
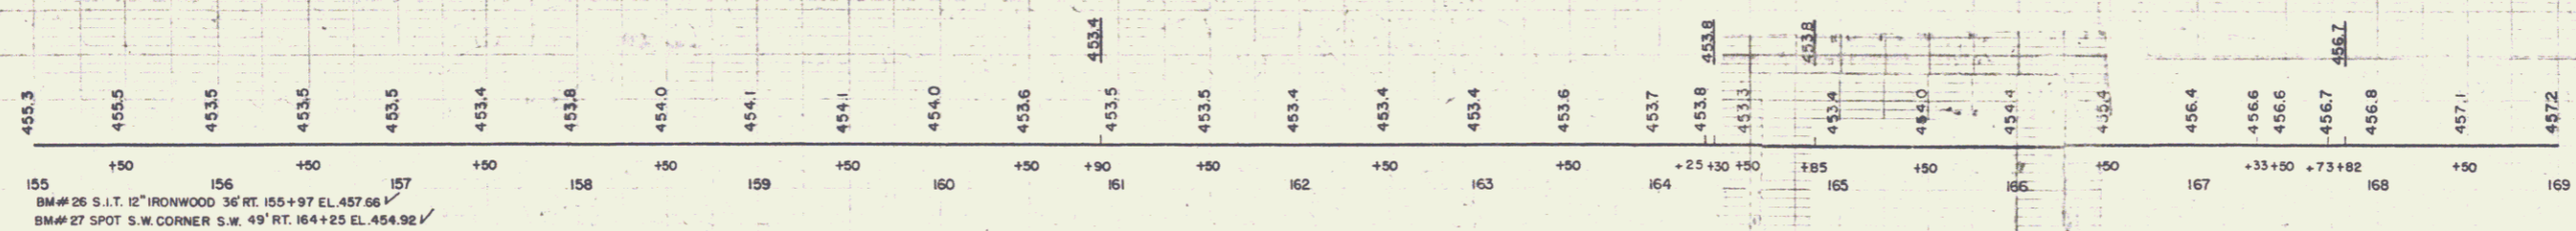


REVISED CURVE DATA
 Δ = 21° 15' RT. ✓
 D = 4"
 R = 1432.7
 T = 268.8
 L = 531.3
 E = 25.0
 BANK 3/4" PER FT.

PARCEL	GRANTOR	NATURE OF TITLE	DATE	TOWN	RECORDING VOL.	DATA PAGES	DATE	NOTES
19 B	JOHN J. & GERTRUDE I. PEDDEN	W.D.O.E.	2-28-56	SPRINGFIELD	5	13	3-19-56	SEE SHEET 15
20 E	ESSIE L. CHITTENDEN	W.D.O.E.	6-27-56	SPRINGFIELD	5	27-28	7-12-56	DRAINAGE RIGHTS

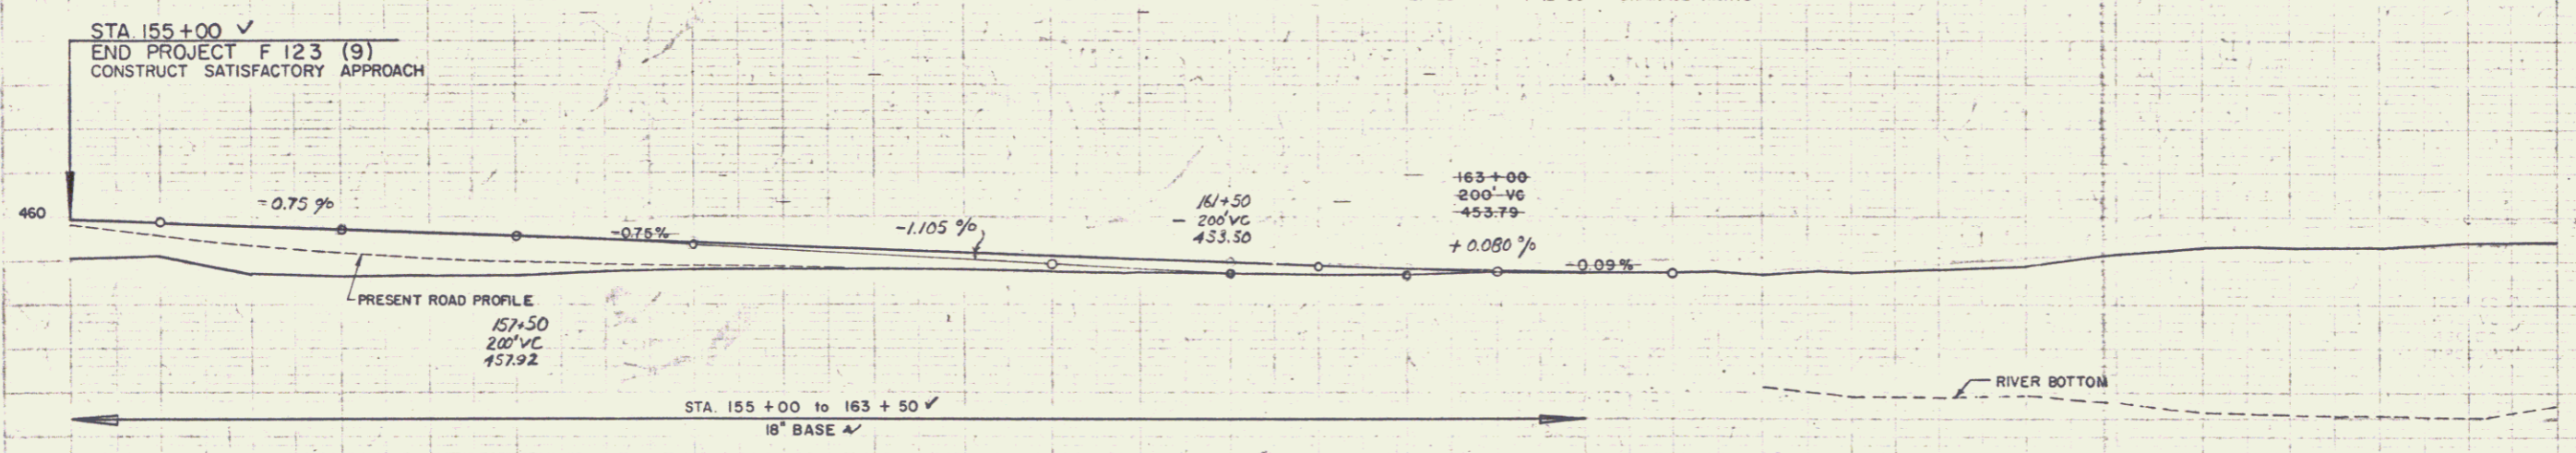

SHEET 16
 SPRINGFIELD
 THE CLARKSON ENGINEERING CO., INC.
 CONSULTING ENGINEERS
 BOSTON MASSACHUSETTS