

STA 155+00  
END PROJECT BEGIN PROJECT F 123 (11)  
F 123 (11)

THREE DOUBLE BLIND BARS WITH STEEL HOISTS  
EL 164+19.8 - 170+00


GRANITE CURB  
163+25 - 164+10 R/L  
165+08 - 166+25 R/L  
166+73 - 166+100 R/L  
166+61 - 169+00 R/L

ONE COURSE CEMENT CONCRETE SIDE WALK  
163+63 - 163+98  
166+93 - 167+73


ONE COURSE CEMENT CONCRETE SIDE WALK  
163+25 - 163+58  
165+08 - 166+25  
166+73 - 166+100  
166+61 - 169+00

REMOVE FROM 110  
STONE PILE  
165+50 - 170+00  
166+50 - 170+00

SCALE	1" = 40'
DATE	
BY	
CHECKED	
APPROVED	

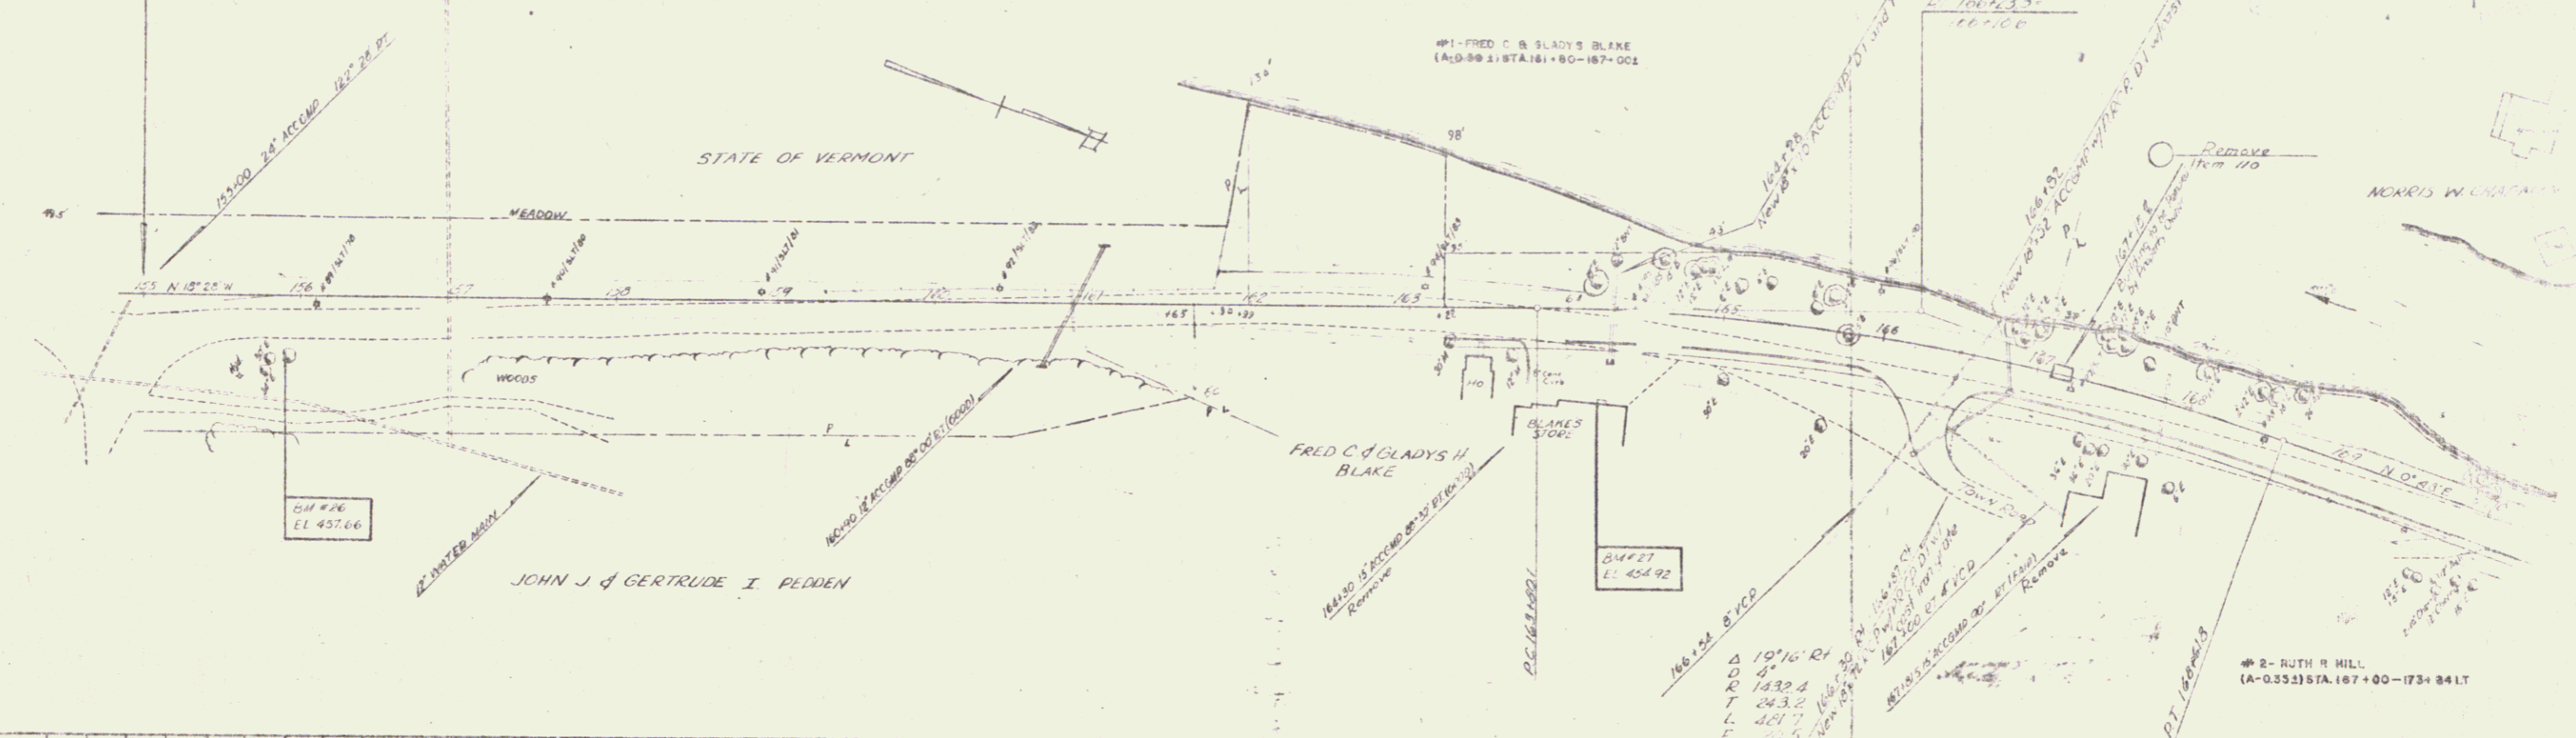

STA 158+00  
END PROJECT BEGIN PROJECT F 123 (11)  
F 123 (11)

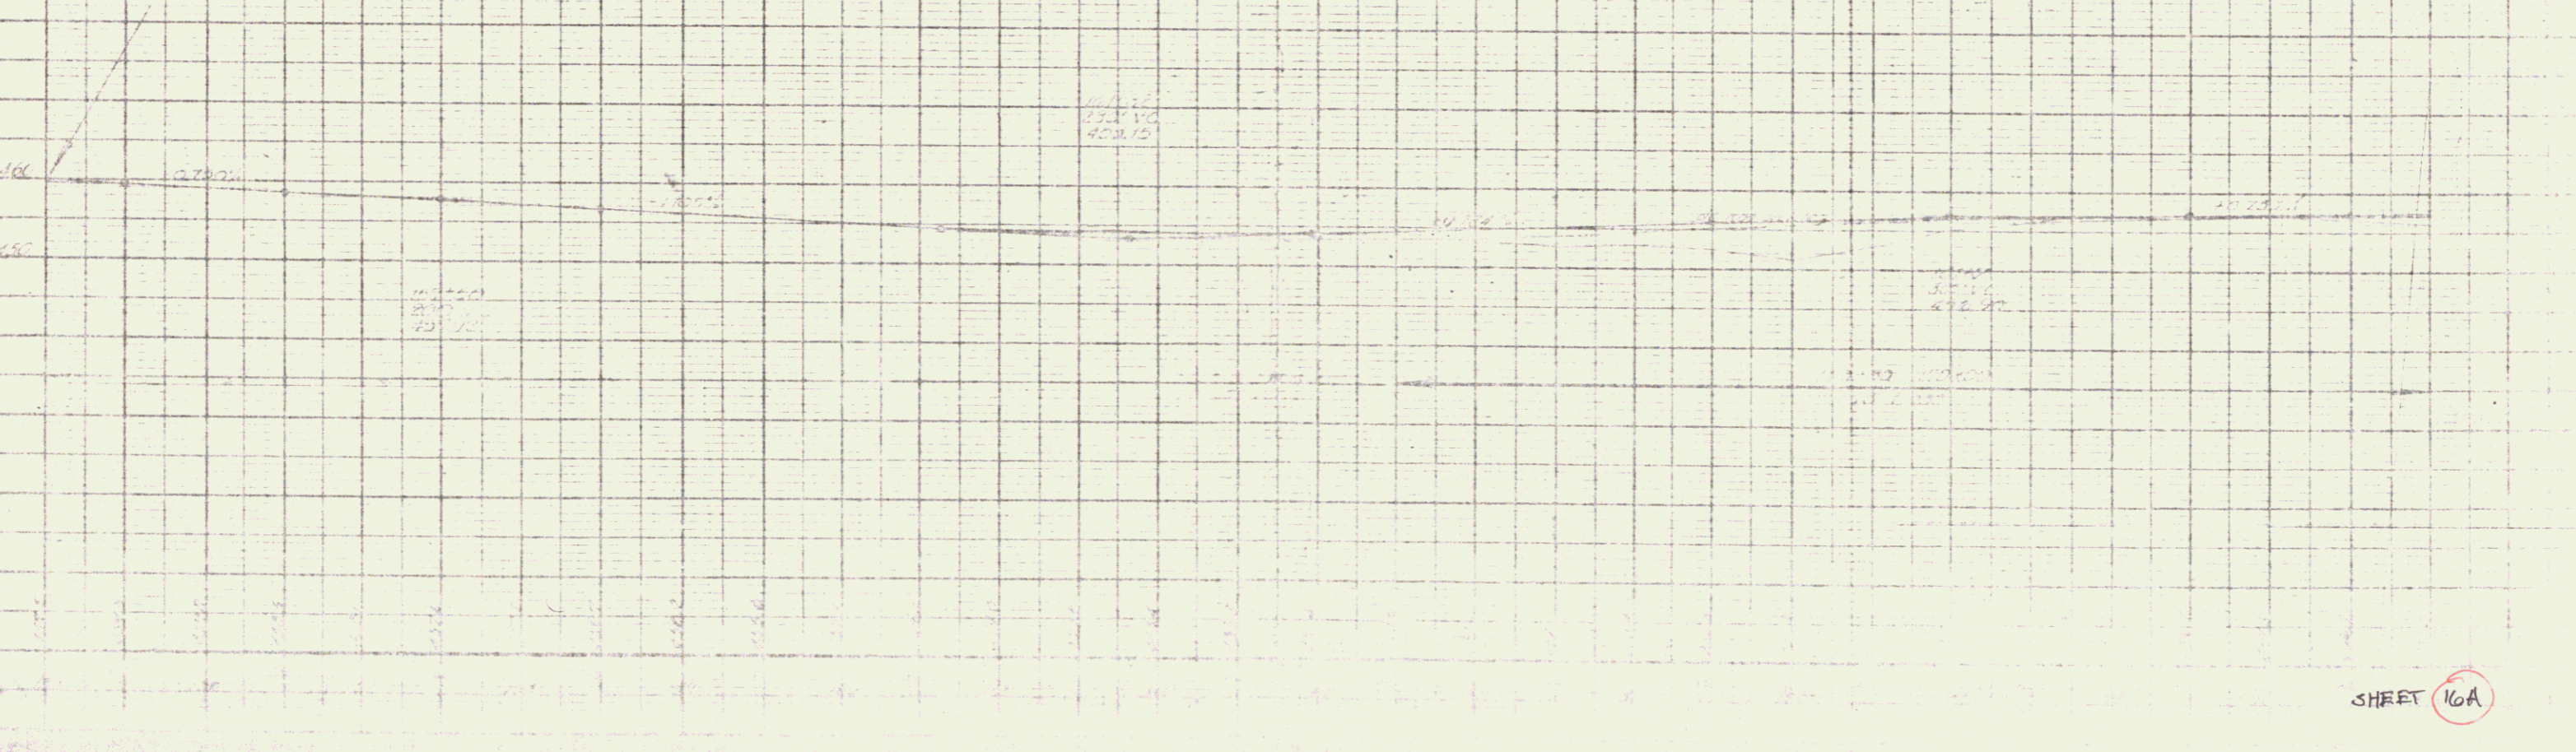

SHEET 10A