


PLAN
 1/4" = 20'
 REVISIONS
 11-54
 6-55
 1-56
 1-58
 1-59
 1-59

PLAN
 1/4" = 20'
 REVISIONS
 11-54
 6-55
 1-56
 1-58
 1-59
 1-59


REVISED CURVE DATA
 Δ 40°-06' LT
 D 5°
 R 1146.3
 T 418.3
 L 802.0
 E 74.0
 BANK 1 1/2 PER FT

C & R TREE
 ITEM 104A

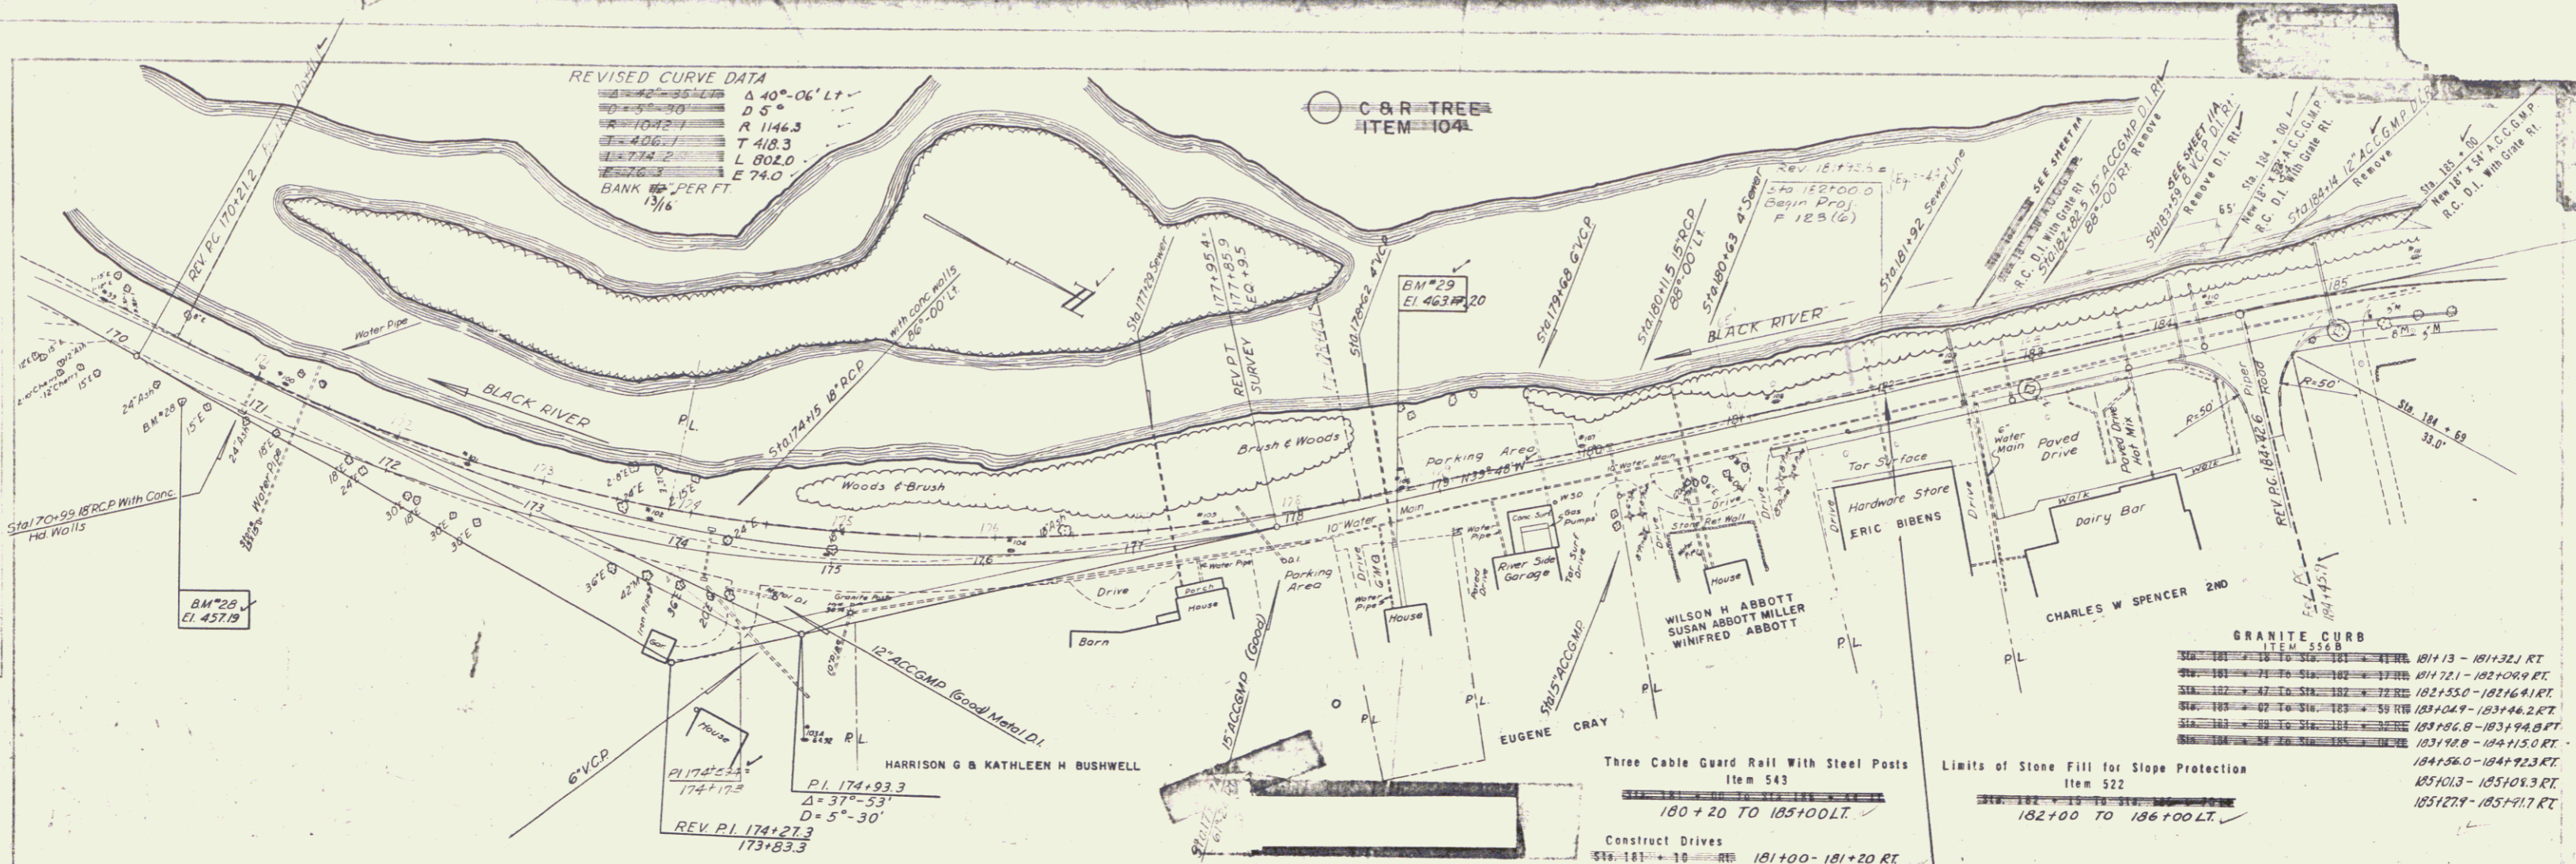

GRANITE CURB ITEM 528

Sta. 181+13	181+13.21 RT
Sta. 181+14	181+14.09 RT
Sta. 181+15	181+15.00 RT
Sta. 181+16	181+16.01 RT
Sta. 181+17	181+17.02 RT
Sta. 181+18	181+18.03 RT
Sta. 181+19	181+19.04 RT
Sta. 181+20	181+20.05 RT
Sta. 181+21	181+21.06 RT
Sta. 181+22	181+22.07 RT
Sta. 181+23	181+23.08 RT
Sta. 181+24	181+24.09 RT
Sta. 181+25	181+25.10 RT
Sta. 181+26	181+26.11 RT
Sta. 181+27	181+27.12 RT
Sta. 181+28	181+28.13 RT
Sta. 181+29	181+29.14 RT
Sta. 181+30	181+30.15 RT

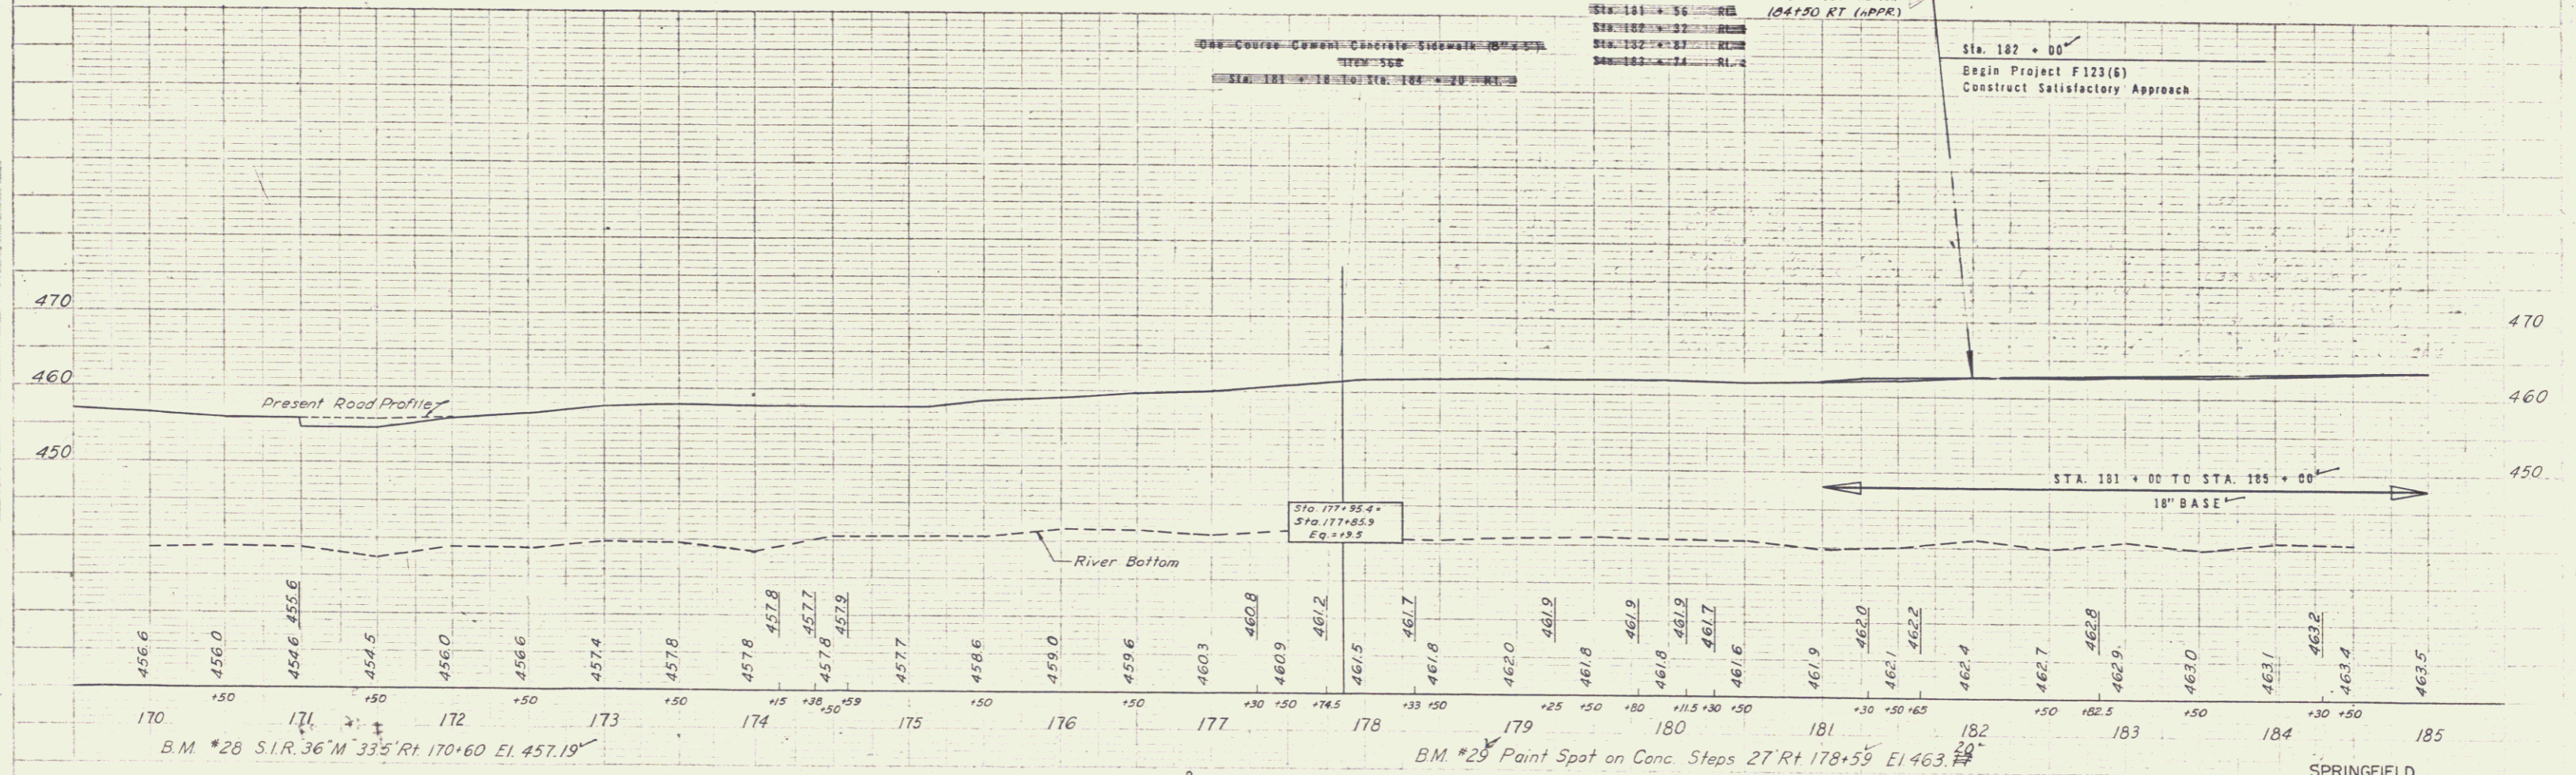

B.M. #28 S.I.R. 36' M 33' 5" Rt 170+60 El. 457.19

B.M. #29 Paint Spot on Conc. Steps 27' Rt 178+59 El. 463.7

SPRINGFIELD
 THE CLARKSON ENGINEERING CO., INC.
 CONSULTING ENGINEERS
 BOSTON MASSACHUSETTS
 SHEET 11