

Construct Drive
 Construct Special Ditch
 Item 598
 Item 599
 Item 600
 Item 1000

3/4" Seamless Copper Water Pipe
 Item 598
 (Actual Stations of Water Pipe to be Determined in the Field)
 207+00-214+50 LT, 214+45 L, 214-45 - 214+50 RT
 RIGHT OF WAY 510 ITEM
 Water Pipe Sleeve, Item 431 and 2" Seamless Copper Water Tube, Item 598
 STA. 206+00 - 208+00, Install Sleeves and Water Pipes furnished
 by the State of Vermont. Any Excavation is to be paid for as
 Trench Excavation, Item 103.

CONSTRUCT SPECIAL DITCH
 200+00 LT - 4100 FT APPROACH
 205+00 RT - 205+30 RT
 207+00 LT - 200 FT LINE WITH PIPE
 215+25 RT - 214+00 RT
 CONTROL OF SECTION OF OLD HIGHWAY BEGINNING AT A POINT IN VERMONT RTE. 106,
 AT ITS INTERSECTION WITH FORMER VERMONT RTE. 10, SAID POINT BEING 790' LEFT OR
 WESTERLY OF APPROX. SURV. STA. 195+30 OF C. OF PROJECT F 123 (G) AND CONTINUING
 NORTHERLY 0.20 MI TO A POINT 90' LEFT OR WESTERLY OF SURV. STA. 203+10 OF
 C. OF SAID PROJECT RELINQUISHED TO THE TOWN OF SPRINGFIELD, AND RECORDED
 IN BOOK 5, PAGE 84, OF HIGHWAY RECORDS, OF THE TOWN OF SPRINGFIELD, ON THE 7TH
 DAY OF OCTOBER, 1958.

DI 4-640 TOX =
 PT 31-300 Jewett
 Δ 5° 02' 14"
 DI 5150.0
 Δ 13° 34' 24"

Route 106
 Revised Curve Data
 Δ = 24° 57' 30" L
 D = 5° 30'
 P = 1042.1
 T = 230.6
 L = 453.8
 E = 25.2

12 FRED M & ALMA L CLARK
 (A 130) STA 203+45-208+40 ±
 CULVERT RIGHTS-STA 207+00 ±
 W.D.E. 11/20/56
 RECORDED: SPRINGFIELD-BK 56-PG 232-233-12/12/56

10 EDWIN J & ADA KING MORSE
 CULVERT RIGHTS-STA 201+00
 COND. 10/11/56
 RECORDED: SPRINGFIELD-BK 56-PG 36-39-10/11/56

10 EDWIN J & ADA KING MORSE
 DRAINAGE DITCH STA 198+00-200+36
 W.D. 11/16/57
 RECORDED: SPRINGFIELD BK 56
 PG 376 11/8/57

11 WILLIAM JOHN & VIRGINIA M. BLAKE
 (A.O.I.) STA 203+50-204+80 ±
 W.D.E. 11/27/56
 RECORDED: SPRINGFIELD BK 56-PG 231-233 12/12/56

CONSTRUCT DRIVE
 201+22 LT
 APPROACH 11+25 LT - 13+60 LT
 APPROACH 8+03 LT - 8+85 LT
 APPROACH 9+03 LT - 216+40 LT (MAIN LINE)
 MAIN LINE 20+40 RT - 208+70 RT
 MAIN LINE 21+163 RT - 216+00 RT













THREE CABLE G.R. W/ STEEL POSTS
 APPROACH 11+25 LT - 13+60 LT
 APPROACH 8+03 LT - 8+85 LT
 APPROACH 9+03 LT - 216+40 LT (MAIN LINE)
 MAIN LINE 20+40 RT - 208+70 RT
 MAIN LINE 21+163 RT - 216+00 RT

CONSTRUCT DRIVE
 201+22 LT
 APPROACH 11+25 LT - 13+60 LT
 APPROACH 8+03 LT - 8+85 LT
 APPROACH 9+03 LT - 216+40 LT (MAIN LINE)
 MAIN LINE 20+40 RT - 208+70 RT
 MAIN LINE 21+163 RT - 216+00 RT

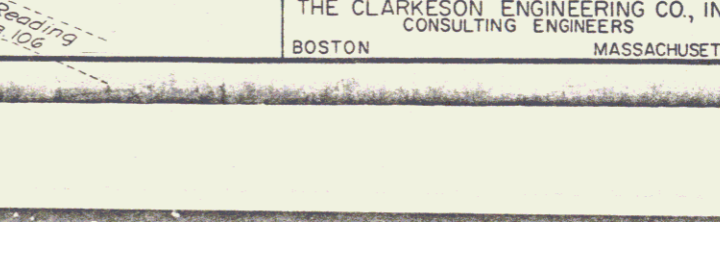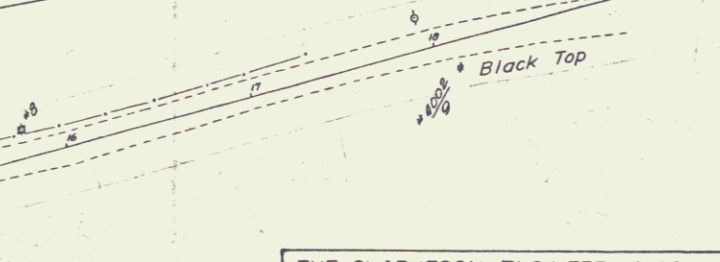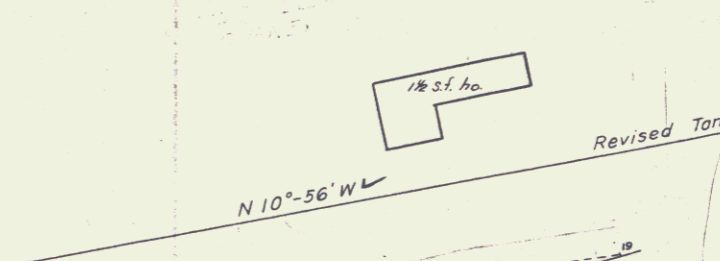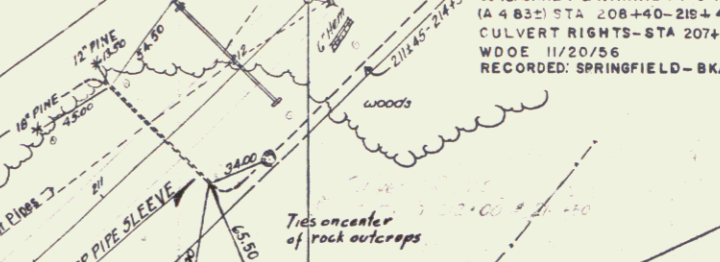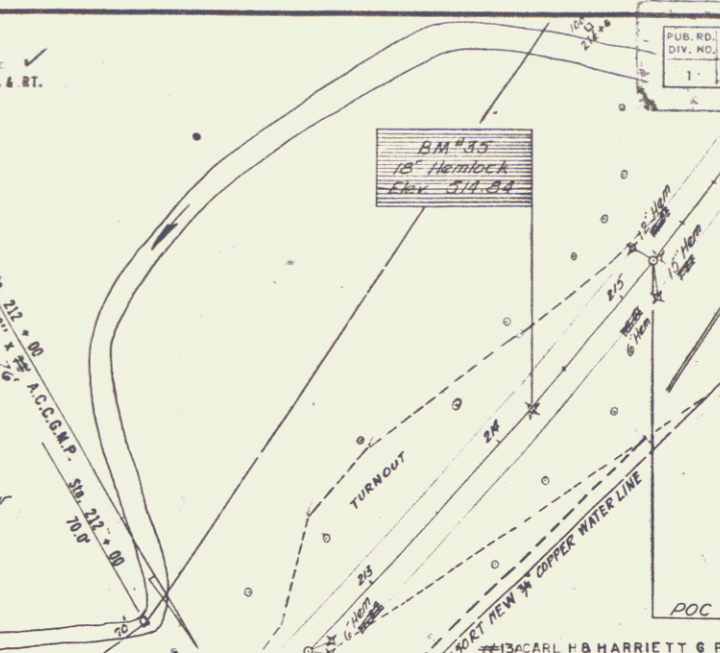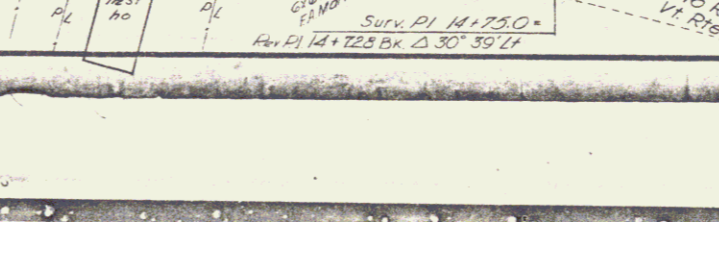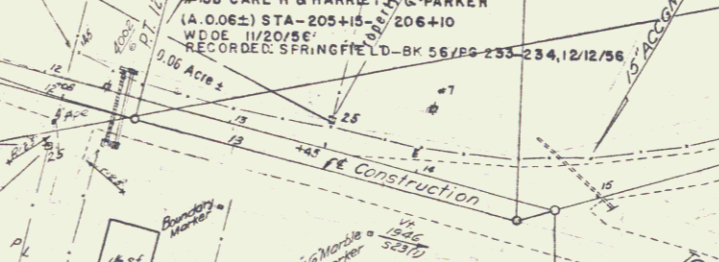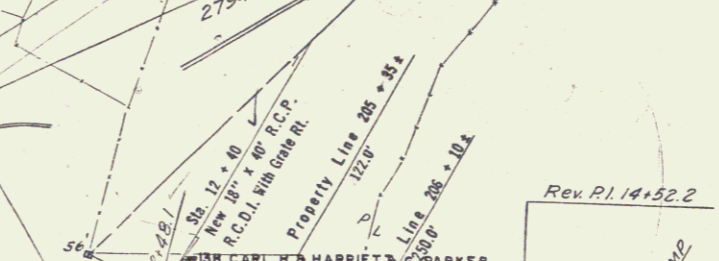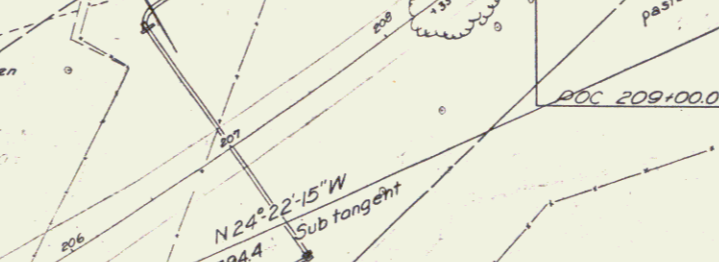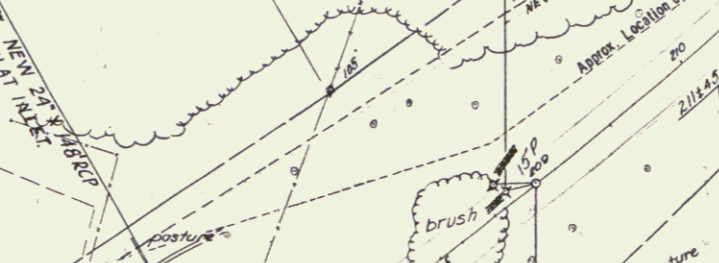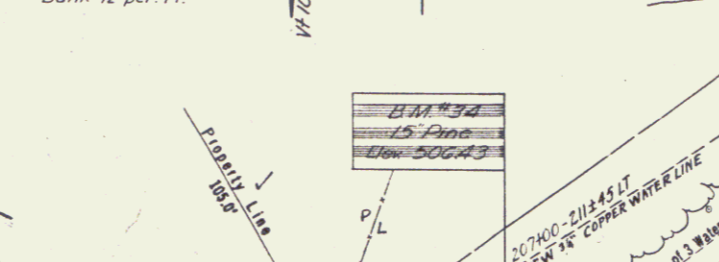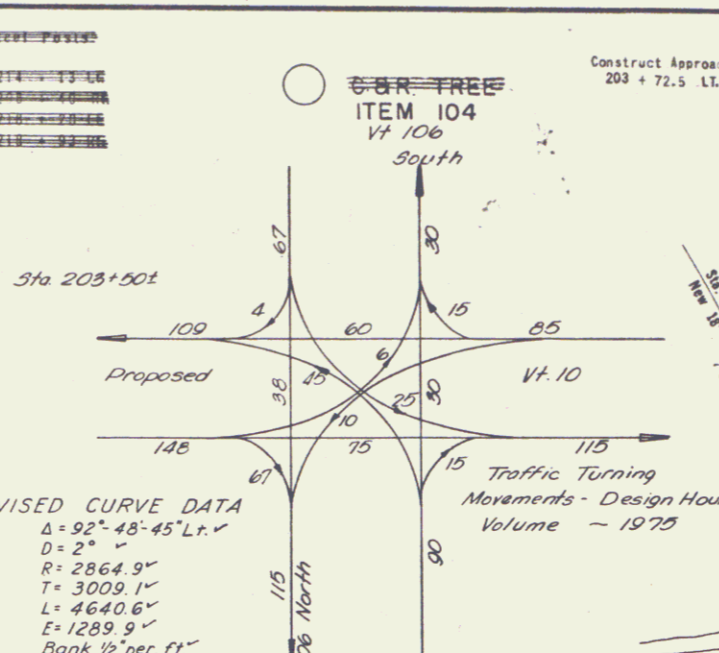

PUB. NO.	STATE	FED. AID PROJECT	FISCAL YEAR	SHEET NO.	TOTAL SHEETS
1	VT	F 123 (6)		14	36

BM 33
 12" Hemlock
 Elev. 314.84

13 CARL H B HARRIETT & PARKER
 (A 483) STA 208+40-218+40
 CULVERT RIGHTS-STA 207+00, 212+00, 216+50
 W.D.E. 11/20/56
 RECORDED: SPRINGFIELD-BK 56-PG 233-234-12/12/56

14 EDWIN J & ADA KING MORSE
 CULVERT RIGHTS-STA 201+00
 COND. 10/11/56
 RECORDED: SPRINGFIELD-BK 56-PG 36-39-10/11/56

15 WILLIAM JOHN & VIRGINIA M. BLAKE
 (A.O.I.) STA 203+50-204+80 ±
 W.D.E. 11/27/56
 RECORDED: SPRINGFIELD BK 56-PG 231-233 12/12/56

16 EDWIN J & ADA KING MORSE
 DRAINAGE DITCH STA 198+00-200+36
 W.D. 11/16/57
 RECORDED: SPRINGFIELD BK 56
 PG 376 11/8/57

17 FRED M & ALMA L CLARK
 (A 130) STA 203+45-208+40 ±
 CULVERT RIGHTS-STA 207+00 ±
 W.D.E. 11/20/56
 RECORDED: SPRINGFIELD-BK 56-PG 232-233-12/12/56

18 EDWIN J & ADA KING MORSE
 CULVERT RIGHTS-STA 201+00
 COND. 10/11/56
 RECORDED: SPRINGFIELD-BK 56-PG 36-39-10/11/56

THE CLARKESON ENGINEERING CO., INC.
 CONSULTING ENGINEERS
 BOSTON MASSACHUSETTS

SPRINGFIELD
 Surveyed by Roger
 Plotted by Jones
 Traced by Trask
 Series F No 123 (6)
 SHEET 14