
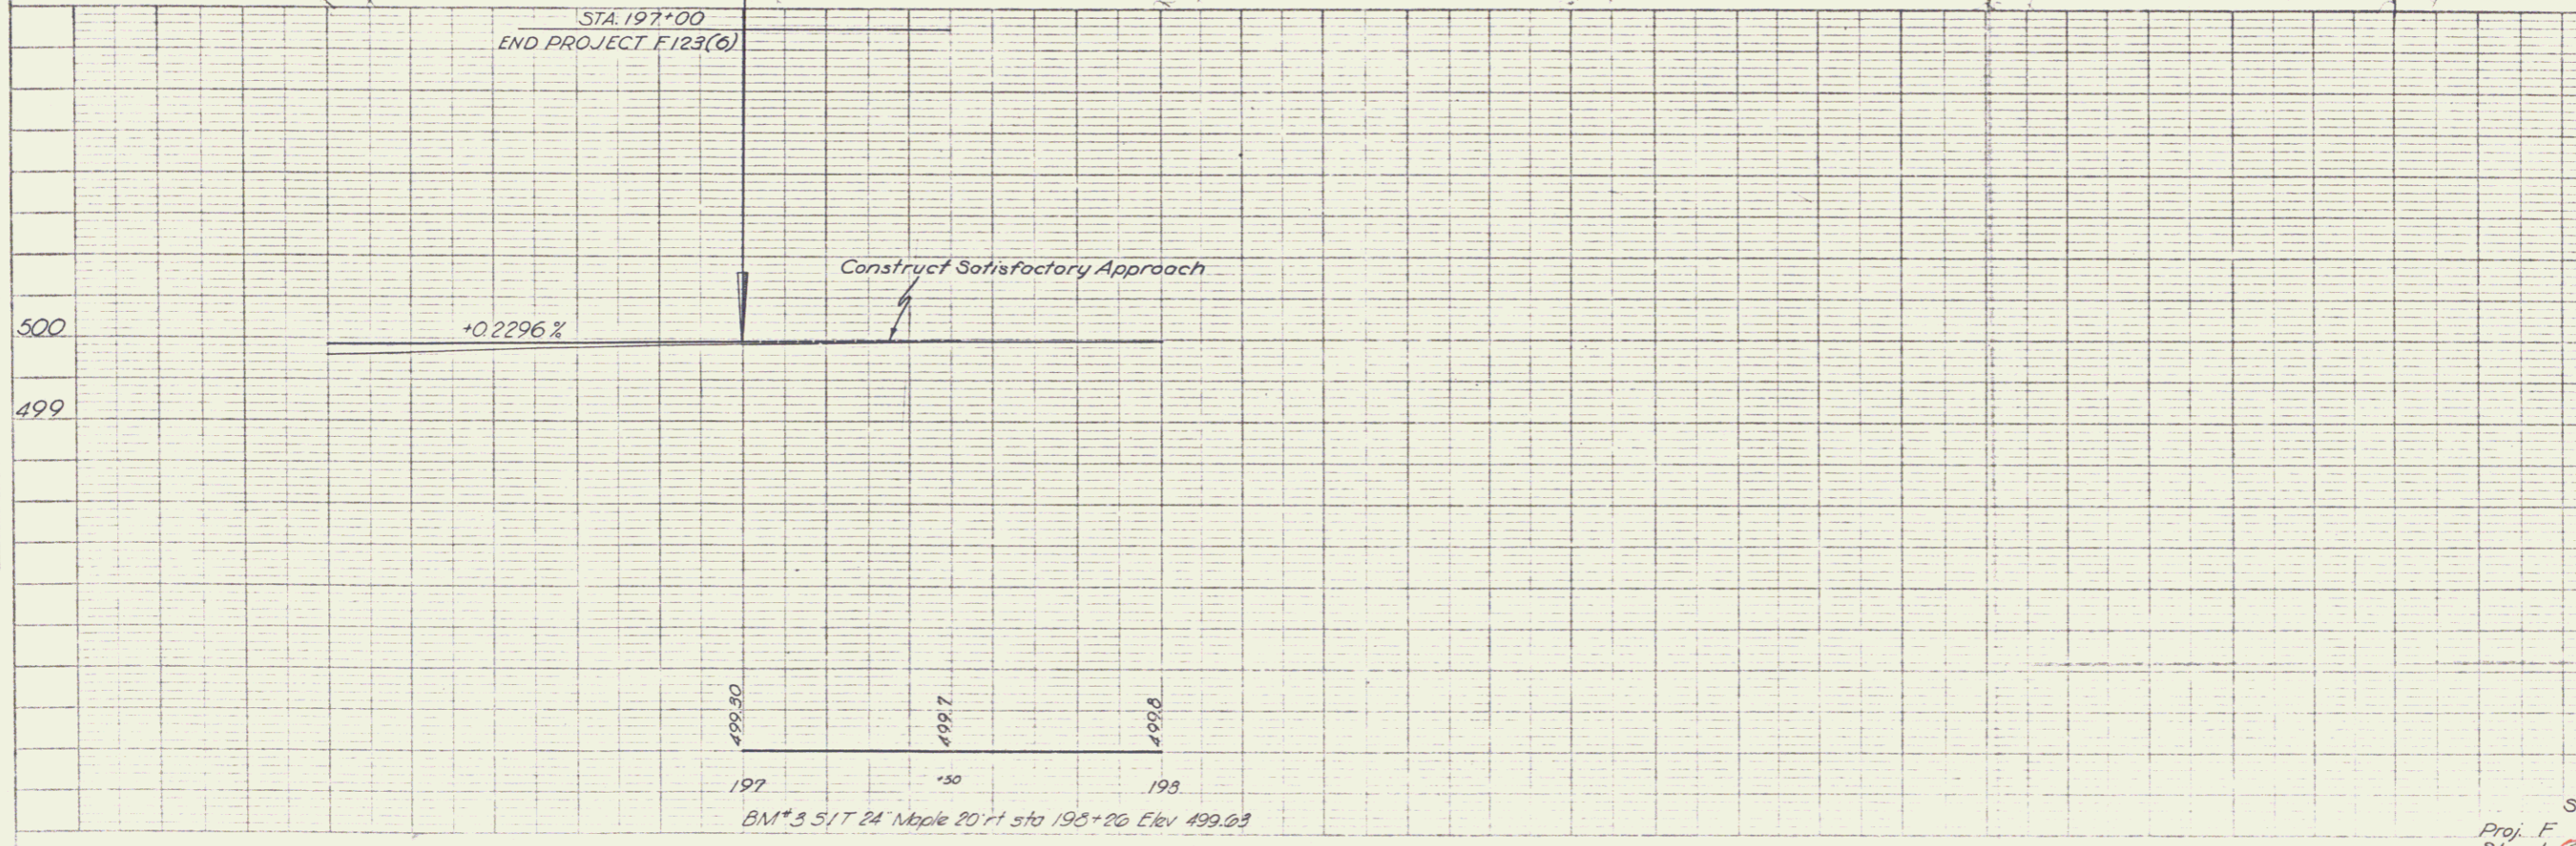


PLAN	DATE	BY
REVISION		
NOTED		
BY		
DATE		

PROFILE	DATE	BY
REVISION		
NOTED		
BY		
DATE		

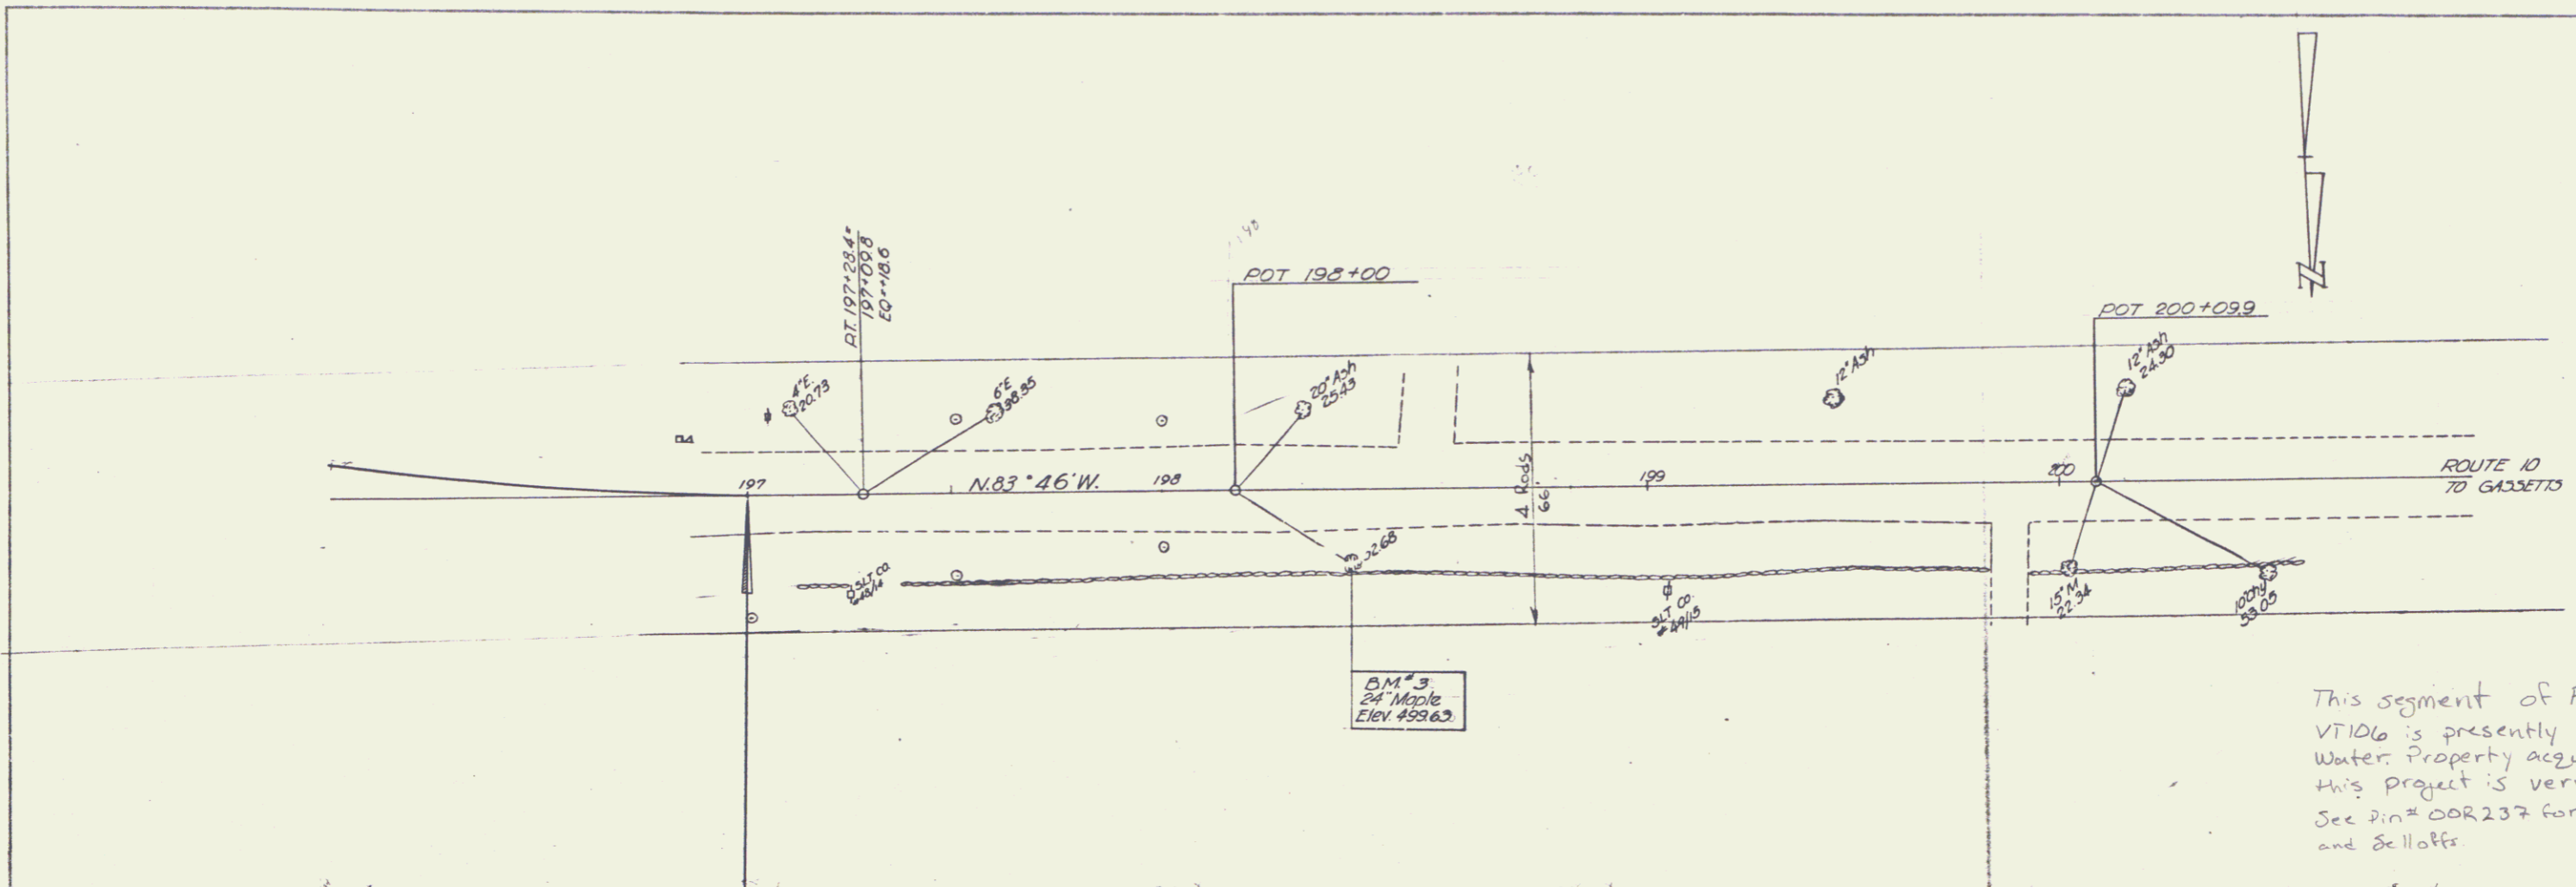

This segment of FORMER VT106 is presently under Water. Property acquired for this Project is very wet. See pin# 00R237 for Dows and Belloffs

499.50
499.7
499.8
197 +50 199
BM#3 517 24 Maple 20' H sta 198+26 Elev 499.63