

STONE FILL FOR SLOPE PROTECTION (LIGHT TYPE)-ITEM 512
31+25 RT-34+75 RT.

UNCLASSIFIED CHANNEL EXCAVATION - ITEM 108C
31+25 RT-34+75 RT.

STANDARD STEEL BEAM GUARD RAIL W/STEEL FLOOR
ITEM 545-A

EXCAV. & REMOVAL OF ROAD SURFACE
AND/OR PAVEMENT
32+00 LT. - 35+00 LT.

CONSTRUCT DRIVE
20+00 LT. ✓
29+05 LT. ✓
29+10 RT. ✓
31+91 LT. ✓
30+75 RT.
31+75 LT.
35+02 LT.

CURVE DATA
Δ 19° 14' LT.
D 3°
R 1145.92'
T 194.17'
L 384.67'
E. 16.33'



30+75 RT - 36+00 RT (6'S SPACING)
Anchor Guard Rail
310-3125 RT 3125-36+0 RT
Item 545-C

BM #9
SIR 18" Elm Cot
Asmd Elev 539.57

RICHARD A. STONE

PLAN
DATE: 11/20/03
SCALE: 1" = 40'
NO. 467

PROFILE
DATE: 11/20/03
SCALE: 1" = 40'
NO. 467

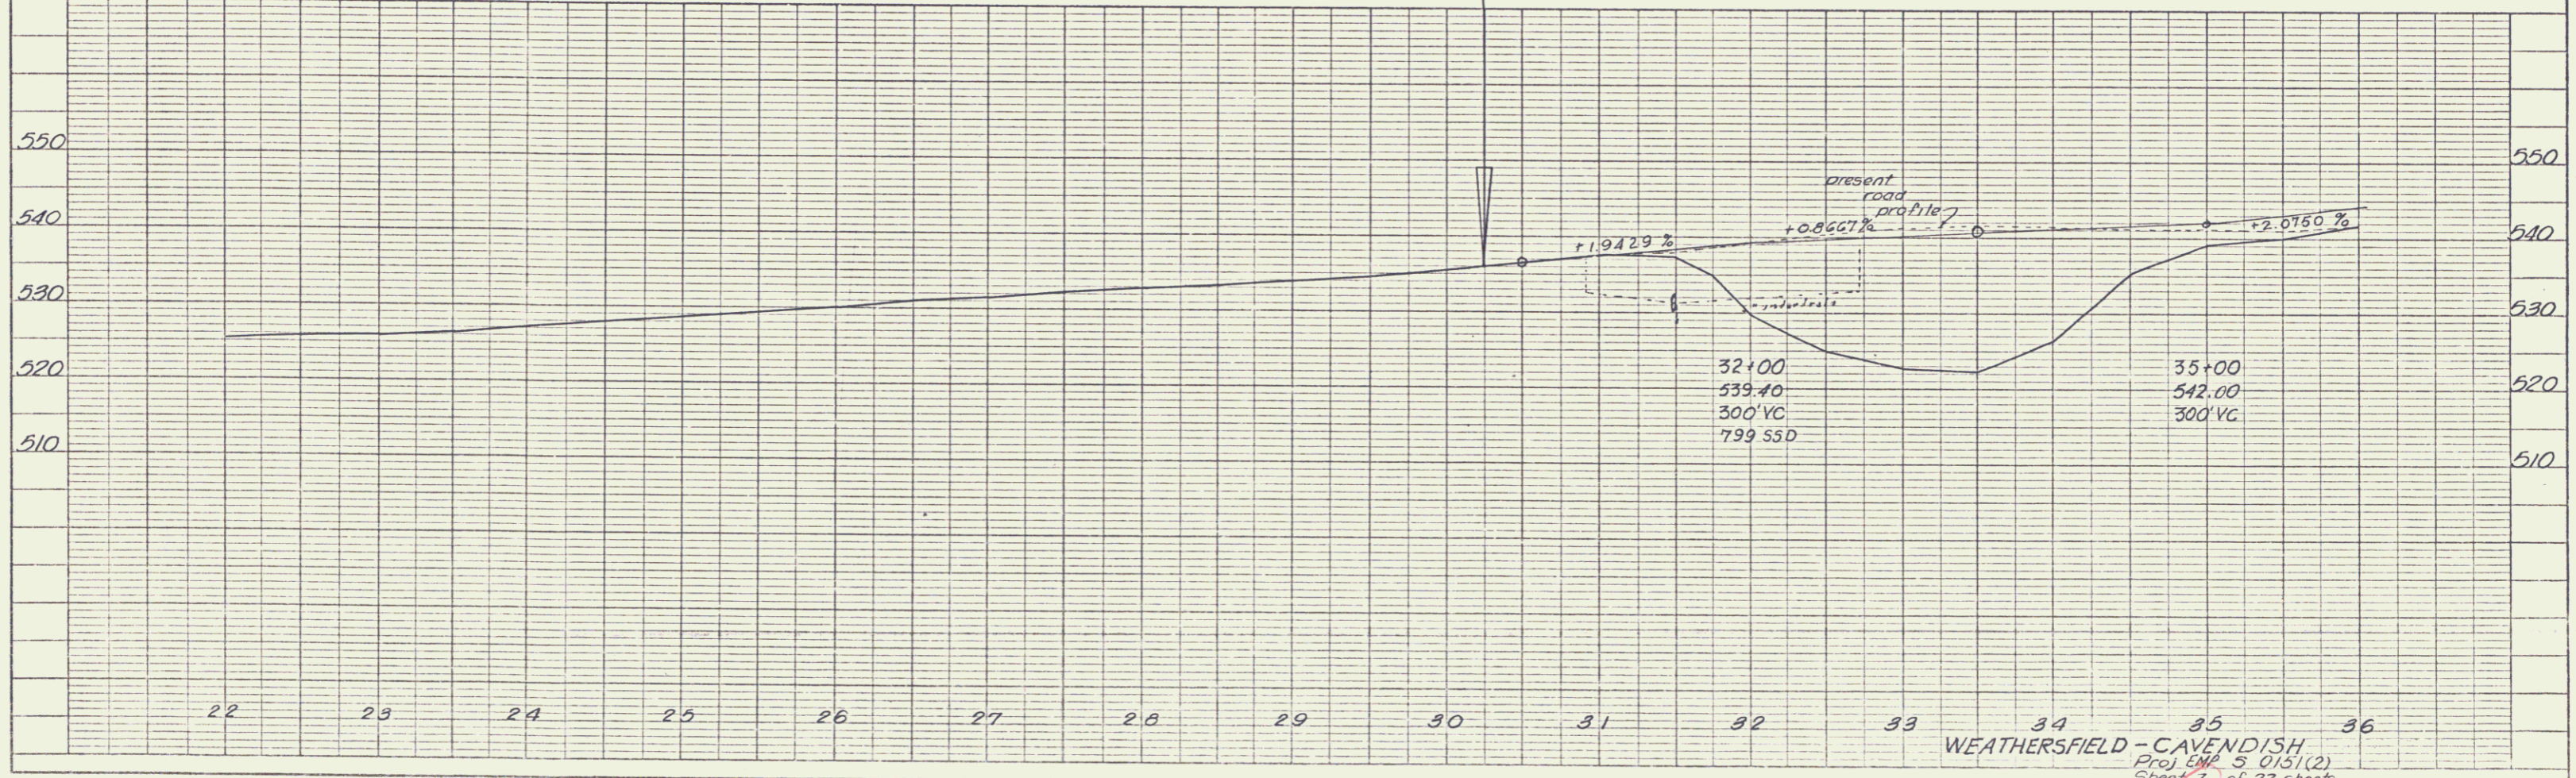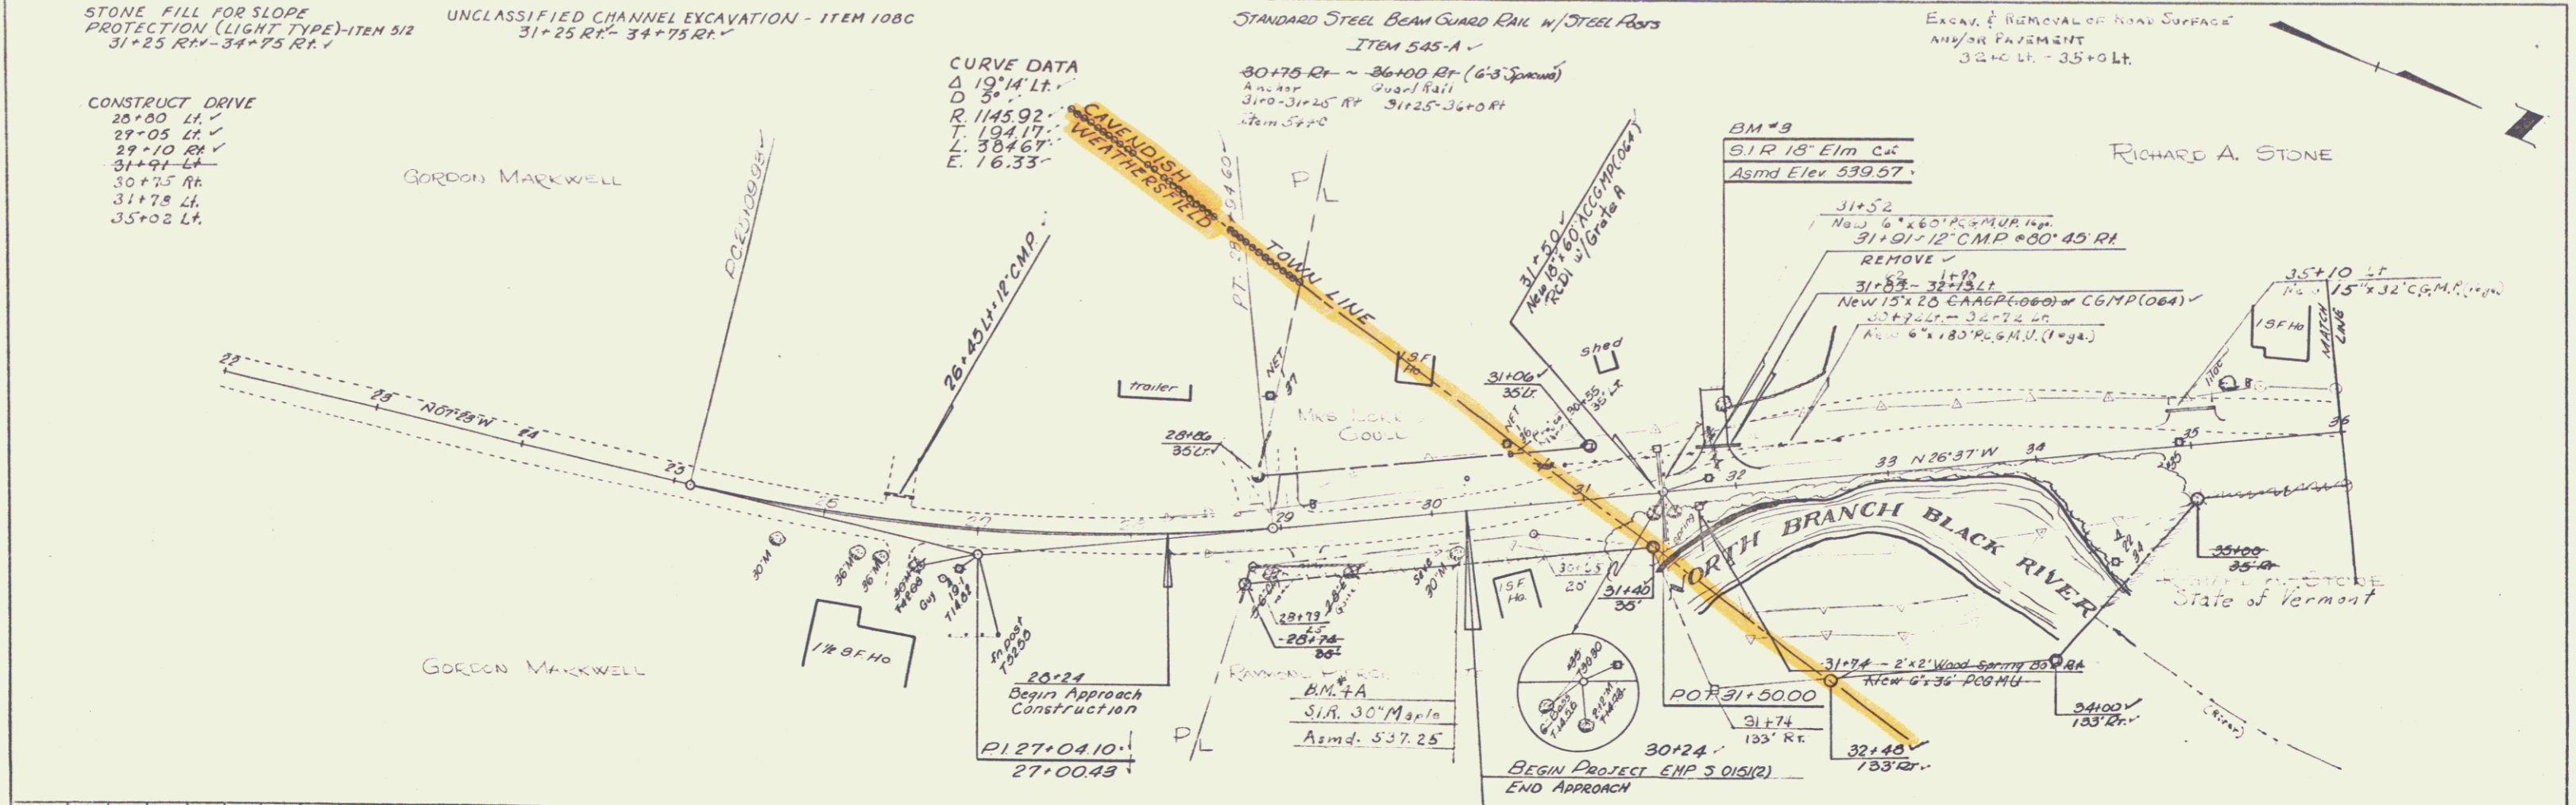

K&E PLATE 1, PLAN/PROFILE
JENNIFER A. BISHOP CO.
40 7312 IMPERIAL "TRAFFIC" GRADE 1/2" x 1/4"

WEATHERSFIELD - CAVENDISH
Proj. EMP 5 0151(2)
Sheet 7 of 27 sheets

4