


INDEX OF SHEETS

1	TITLE SHEET
2	TYPICAL CROSS SECTION OF IMPROVEMENT (10" BITUMINOUS CONCRETE PAVEMENT)
3	QUANTITY SHEET (ITEMS)
4	QUANTITY / SHEET (DRAINAGE)
5-6	EARTHWORK SHEETS
7-11	PLAN AND PROFILE SHEETS
12	STANDARD SHEET A-61 (SOLID ROCK EXCAVATION)
13	STANDARD SHEET B-1 (BANKING TABLES)
14	STANDARD SHEET B-5 (TURNOUTS)
15	STANDARD SHEET B-11 (USE OF UNDERDRAIN WITH ...)
16	STANDARD SHEET D-1 (THREE RING CONC. DROP INLET WITH GRATE)
17	STANDARD SHEET D-2 (C&W, HEADWALLS, AND UNDERDRAIN)
18	STANDARD SHEET E-1 (BARRICADES, SIGNS, AND LIGHTS)
19	STANDARD SHEET E-9 (FEDERAL-AID CONSTRUCTION IDENTIFICATION SIGNS)
20	STANDARD SHEET G-3 (THREE CABLE GUARD RAIL WITH STEEL POSTS)
21	STANDARD SHEET G-4 (MARKER POSTS AND GUIDE POSTS)
22	STANDARD SHEET J-1 (PROJECT MARKERS AND BOUNDARY MARKERS)
23-43	CROSS SECTION SHEETS
44	CURVE BANKING TRANSITION DIAGRAMS
6A-B	FINAL EARTHWORK SHEETS
7	DRAINAGE SHEETS

STATE OF VERMONT
DEPARTMENT OF HIGHWAYS
PROPOSED IMPROVEMENT

FEDERAL AID SECONDARY
**TOWN OF READING
COUNTY OF WINDSOR
VERMONT ROUTE #106
SPRINGFIELD-WOODSTOCK ROAD**

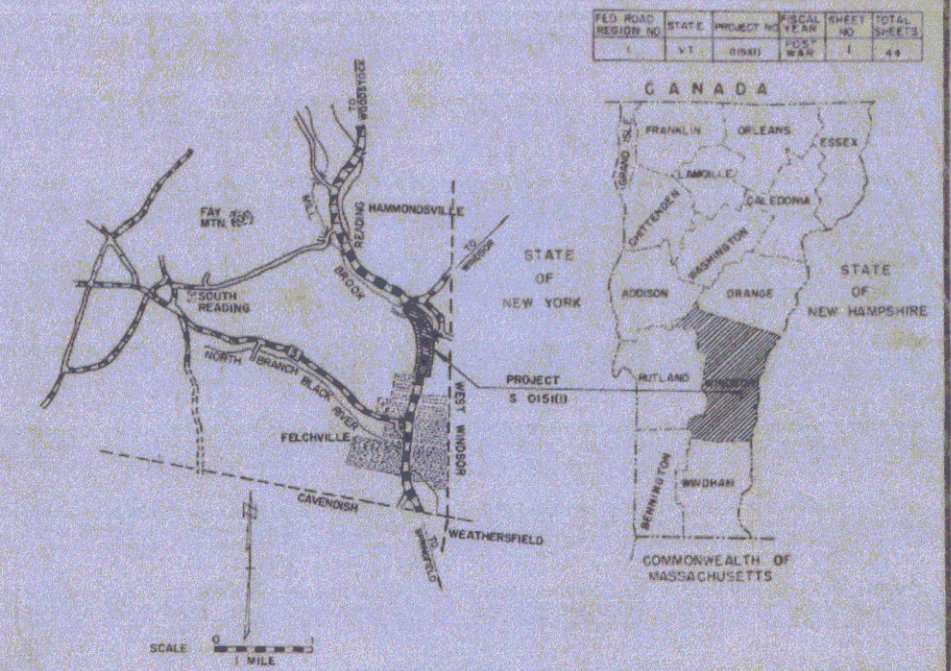


BENCH MARK DATA FROM USGS ELEVATIONS


PROJECT NAME & NUMBER TYPE PAVT. AREA
READING S 0151(1) BIT. CONC. PAVT. 14,722 S.Y.
RECORD PLANS
MATERIALS
SUBBASE OF GRAVEL-LAFFIN PIT-READING, VT.
-SHATTUCK'S PIT & ROBOYS PIT-PERKINSVILLE, VT.
ASPHALT CEMENT-HUMBLE OIL-EVERETT, MASS.
CUTBACK ASPHALT-MOBIL OIL-EAST PROVIDENCE, R.I.
BITUMINOUS CONCRETE-COLD RIVER HOT MIX (PLANT)-NO. WALPOLE, N.H.
REINFORCED CONCRETE PIPE & REINF. CONC. PIPE DROP INLET (PRECAST)
-MARTIN, MARIETTA CO.-WINDSOR, VT.
ASPH. CTD. CORR. GALV. MET. PIPE-NEW ENGLAND METAL CULVERT CO.
-WHITE RIVER JCT., VT.
CAST IRON COVERS FOR FLUSHING BASINS-E.L. LEBARON FOUNDRY CO.
-BROCKTON, MASS.
CABLE GUARD RAIL & STEEL MARKER POSTS-S.T. GRISWOLD & CO.,
INC.-ESSEX JCT., VT.
CONTRACTOR-S.V. ROSSI CONST. CO. INC. CONTRACT DATED-JUNE 20, 1963.
TORRINGTON, CONN.
RES. ENG.-R.C. GILMAN & A.J. REINHART. STARTED-JULY 23, 1963.
RECORD PLANS-A.J. REINHART. COMPLETED-JULY 15, 1964.
ACCEPTED-JULY 15, 1964.

1.222
BEGINNING AT A POINT APPROXIMATELY 1.45 MILES
NORTHERLY OF THE CAVDENSH-READING TOWN LINE
AND EXTENDING NORTHERLY 1.015 MILES
LENGTH OF PROJECT 5358.0 FEET = 10.15 MILES

1960 ADT	585-400
1980 ADT	820-560
1980 DHV	140-110
D	60%
T	9%
V	50 MPH

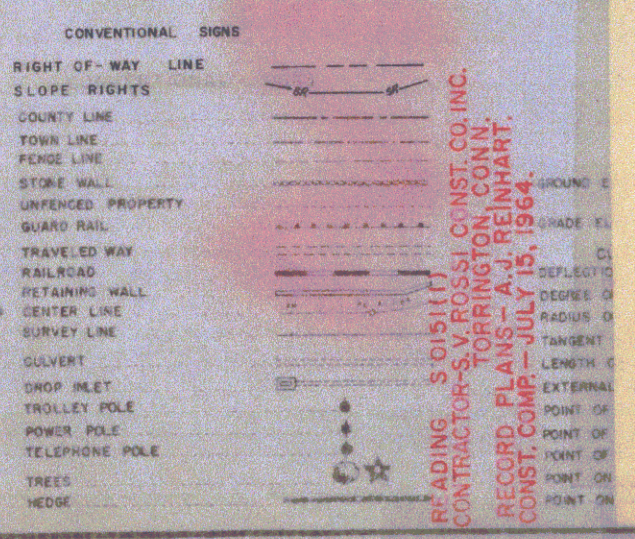

READING
S 0151(1)
BITUMINOUS CONCRETE PAVEMENT
S.V. ROSSI CONST. CO. INC.
TORRINGTON, CONN.
Location: Beginning of a point, 1.45 miles northerly of the Cavanaugh -
Reading Town Line and extending northerly 1.015 miles.

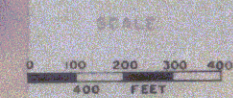

THESE PLANS ARE SUBJECT TO SUCH REVISIONS AS MAY BE
REQUIRED BY THE BUREAU OF PUBLIC ROADS OR THE COMMISSIONER
OF HIGHWAYS.
CONSTRUCTION IS TO BE CARRIED ON IN ACCORDANCE WITH
THE PLANS AND THE STANDARD SPECIFICATIONS FOR HIGHWAY AND BRIDGE
CONSTRUCTION OF JANUARY 1956 SUBMITTED TO THE BUREAU OF
PUBLIC ROADS AS APPROVED JULY 5, 1956, INCLUDING ALL SUBSEQUENT
APPROVED REVISIONS AND SUCH REVISED SPECIFICATIONS AND SPECIAL
PROVISIONS AS ARE SUBMITTED WITH THE PLANS.

APPROVED DATE 3/30/62 DISTRICT ENGINEER	APPROVED DATE 7/10/62 CONSTRUCTION ENGINEER	APPROVED DATE 3-30-62 DISTRICT ENGINEER	APPROVED DATE Sept 6, 1962 HIGHWAY ENGINEER	APPROVED DATE Sept 11, 1962 CHIEF ENGINEER
---	---	---	---	--

Pin # 00R245

DEPARTMENT OF COMMERCE
BUREAU OF PUBLIC ROADS

APPROVED
DIVISION ENGINEER
DATE

PROJECT S NO 0151(1)

SHEET 1 OF 44 SHEETS