

REMOVAL AND DISPOSAL OF PRESENT GUARD RAIL  
 LT 34+05-35+75 34+00-36+56

CONSTRUCT DRIVE  
 RT 36+50'

PARCEL	88
STATIONS	32+95-37+61
TAKING	0.32 A

THREE CABLE GUARD RAIL WITH STEEL POSTS  
 RT 34+00-36+81.70

DRILLING AND BLASTING OF SOLID ROCK SUBGRADE  
 RT 35+75-36+00-41+29.00



SPECIAL DITCH  
 41-75 Lt.

PARCEL	98
STATIONS	35+50-53+42
TAKING	3.2 A



Cutting & Removing Trees  
 40+00-40+50 LT 3  
 41+00-42+00 LT 4

Truck Lane  
 34+00-41+00 Rt.

PLAN  
 10/6/57  
 Barnes  
 10/6/57  
 Barnes

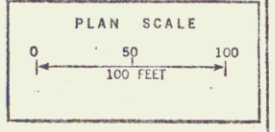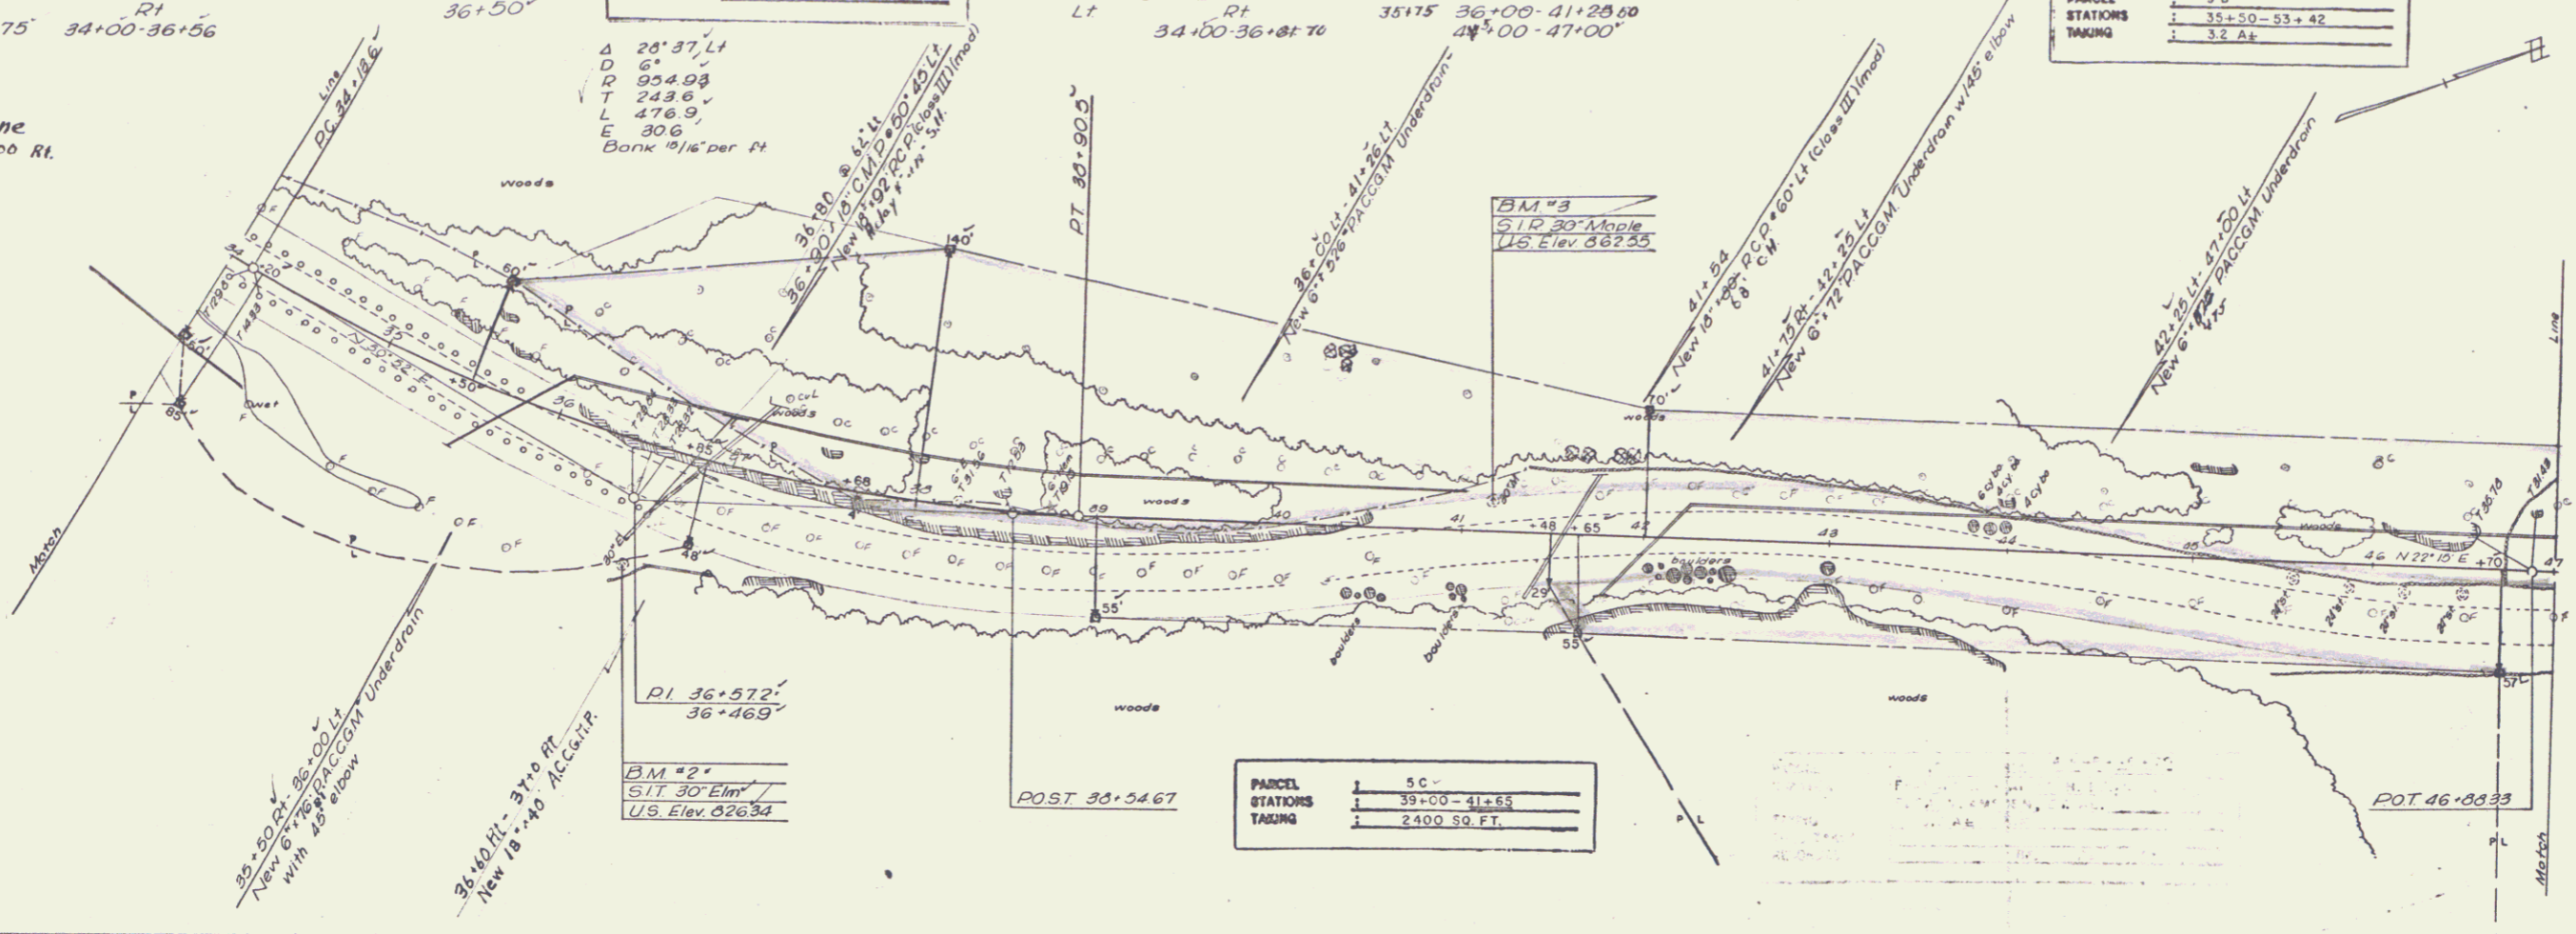

PROFILE  
 10/6/57  
 Barnes  
 10/6/57  
 Barnes

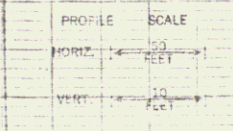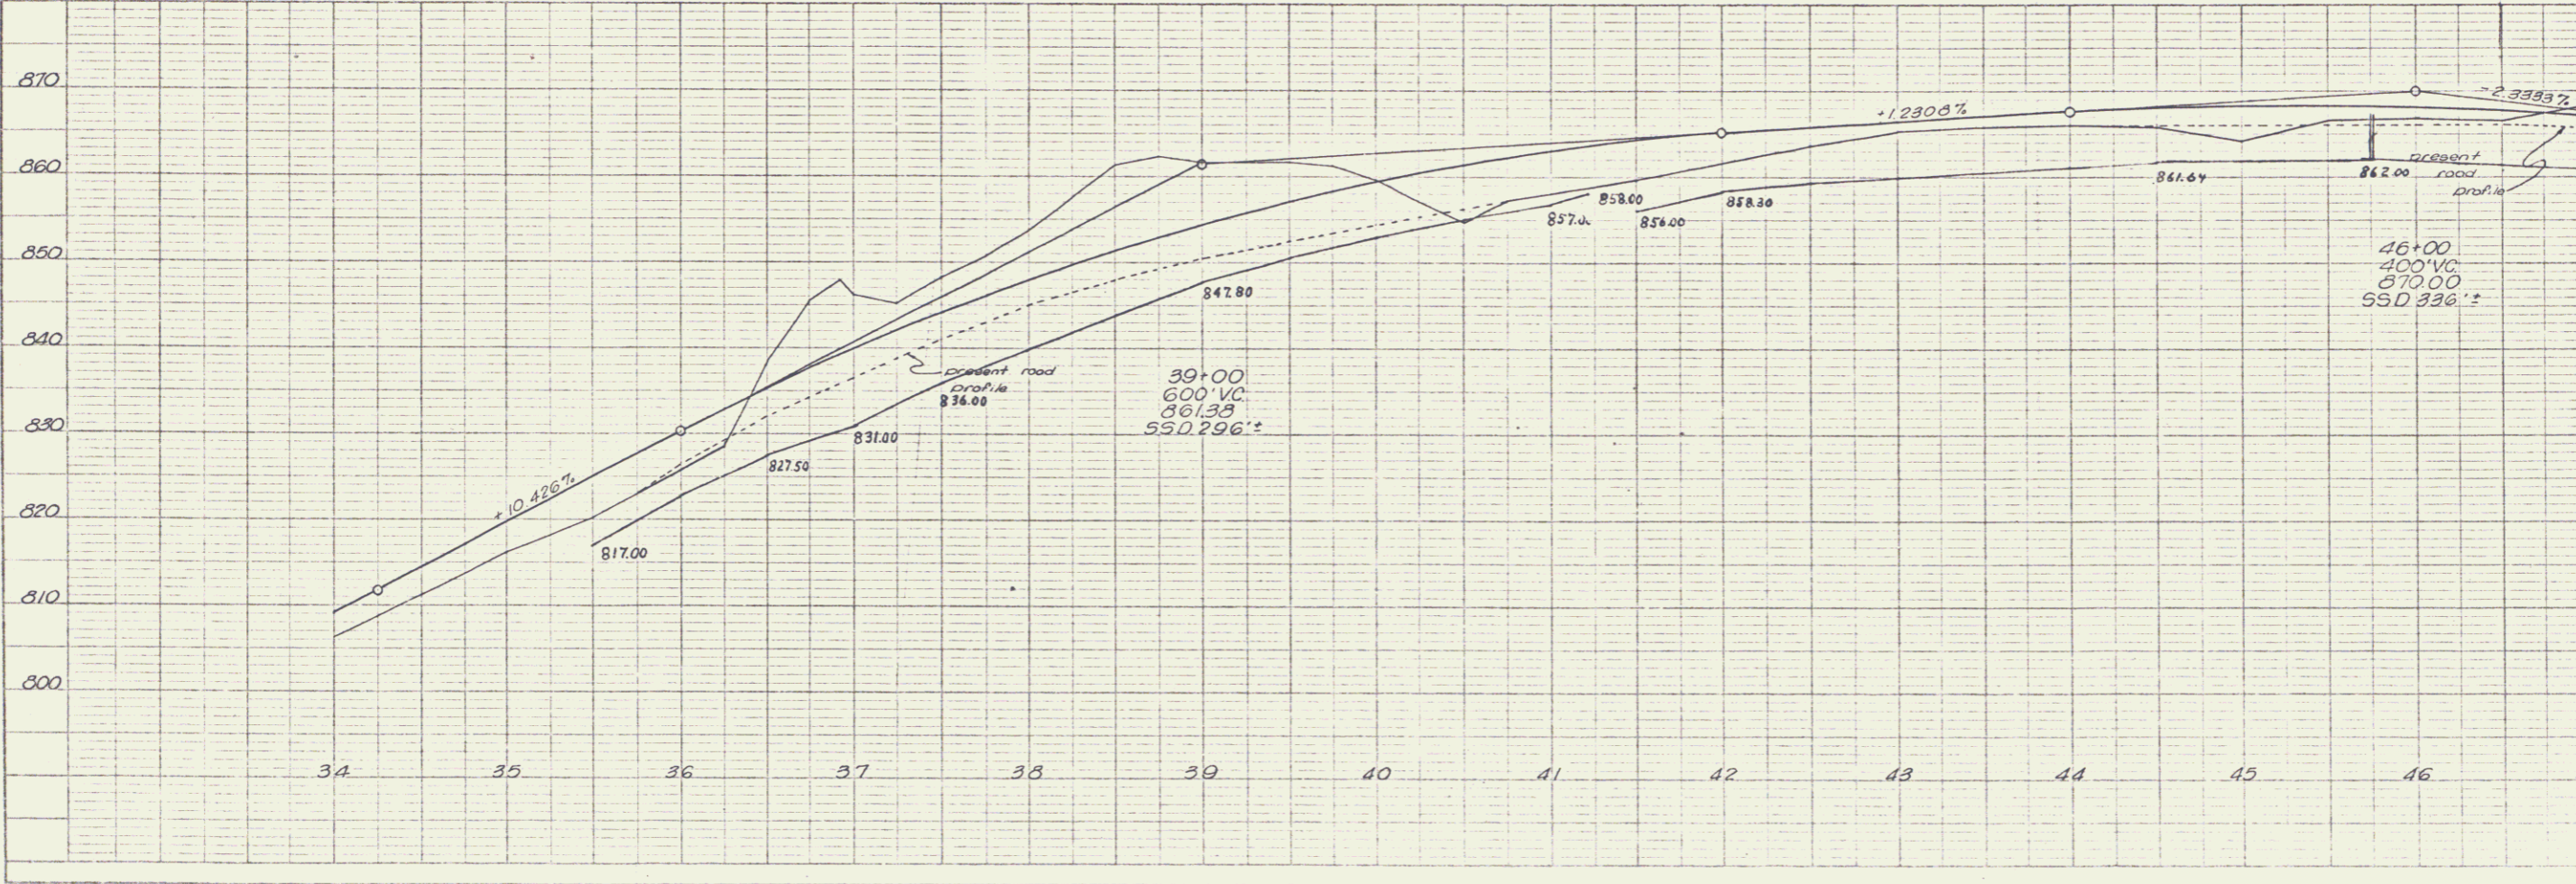

READING  
 Proj S No 0103(11)  
 Sheet 4 of 44