


PLAN  
 10 of 10  
 RUTH H. LAFFIN  
 10/6/63

PROFILE  
 10 of 10  
 RUTH H. LAFFIN  
 10/6/63

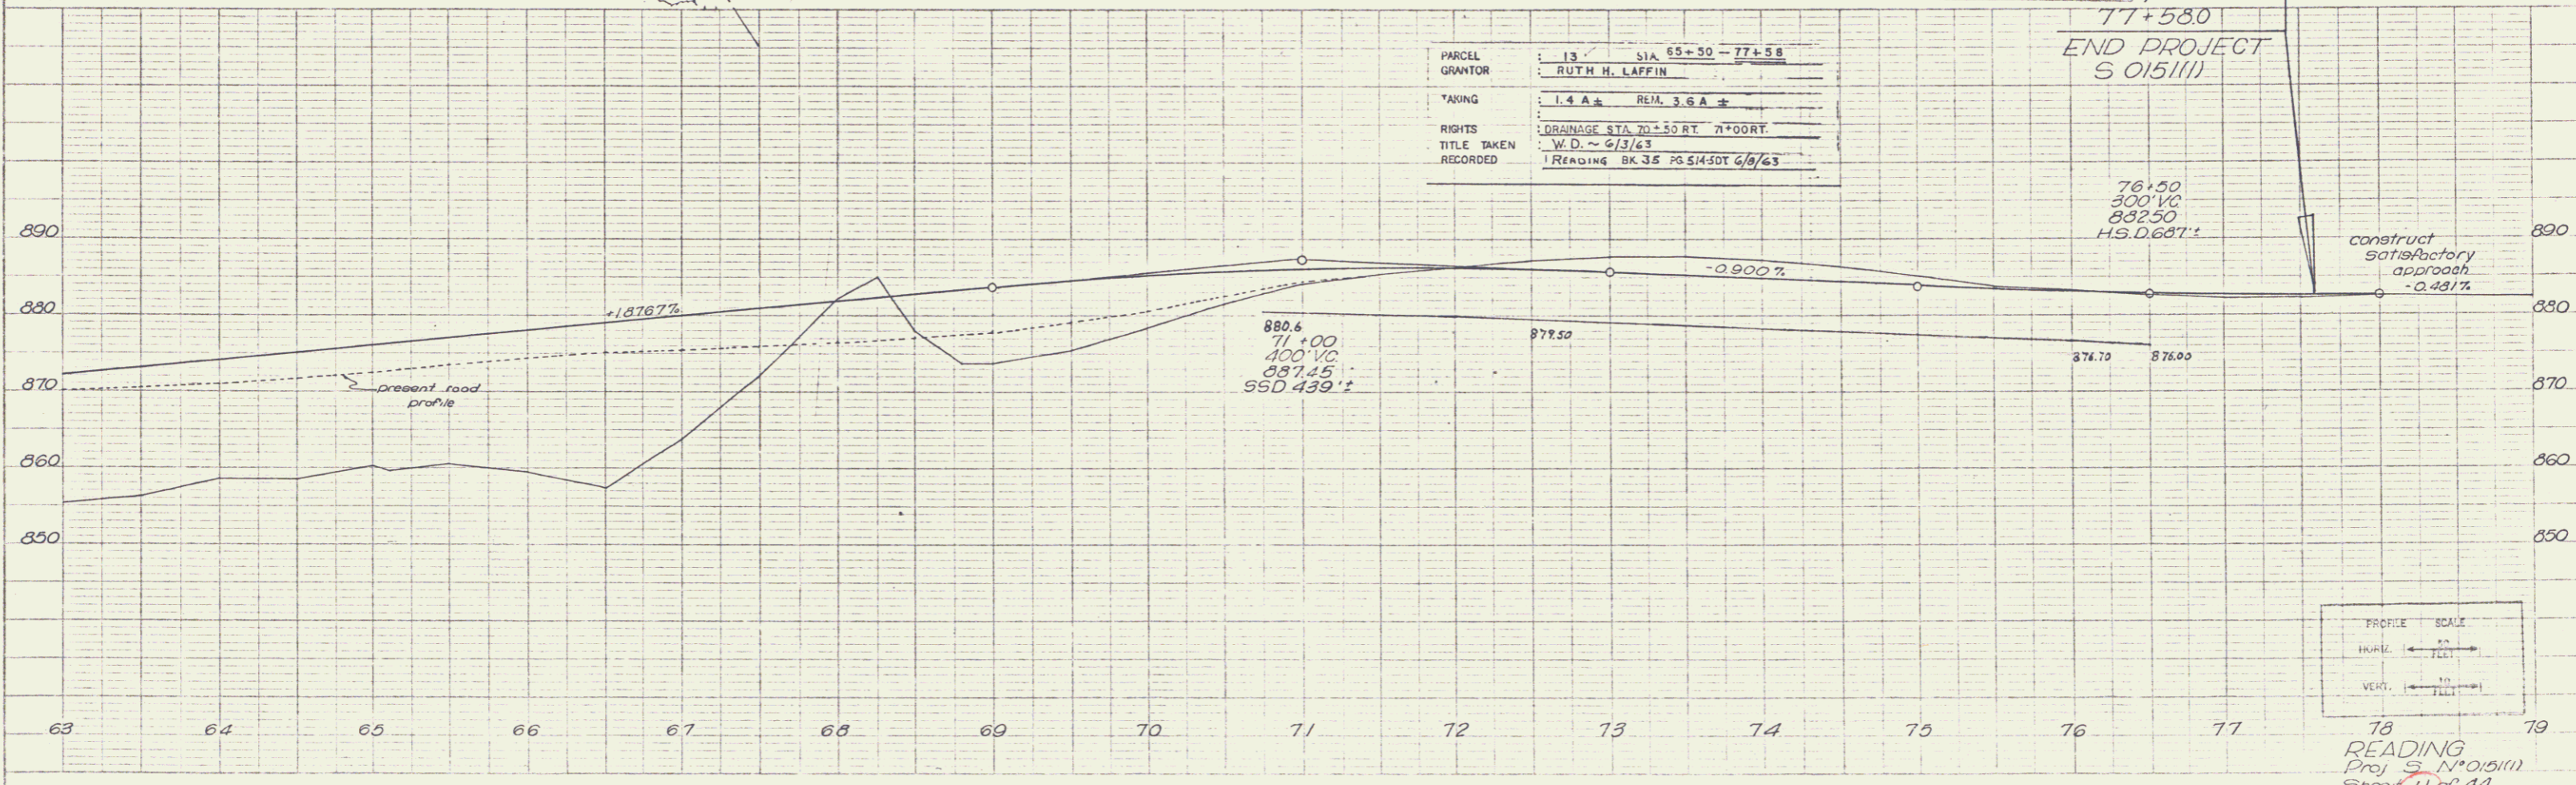

PARCEL	13	SIA	55+30 - 77+58
GRANTOR	RUTH H. LAFFIN		
TAXING	1.4 A	REL.	3.6 A
RIGHTS	DRAINAGE STA 70+50 RT 7+00 RT.		
TITLE TAKEN	W.D. - 6/3/63		
RECORDED	READING BK 35 PG 51450T 6/9/63		

PROFILE SCALE  
 HORIZ. 1" = 100'  
 VERT. 1" = 10'

READING  
 Proj S N°015111  
 Sheet 11 of 44