

Tree Removal Item 109		
Sta	Pos	No.
15+18	L1	1 ✓

PARCEL INSTRUMENT DATE GRANTOR GRANTEE RECORDED READING DATE REMARKS  
 #3A W.D.O.E. 2-28-49 ERNEST & BESSIE AIKEN ST OF VT. 33 392 3-3-49


PLANNED STATE 5 FEDERAL SHEET DATA  
 DIST NO 23(2) YEAR 9 62

B.M. #3  
 15' E  
 21' 492.63

POT 20197.8


PLAN  
 H.R. CANTON & CO.  
 100 N. Main St.  
 Reading, Vt.

PLAN  
 H.R. CANTON & CO.  
 100 N. Main St.  
 Reading, Vt.

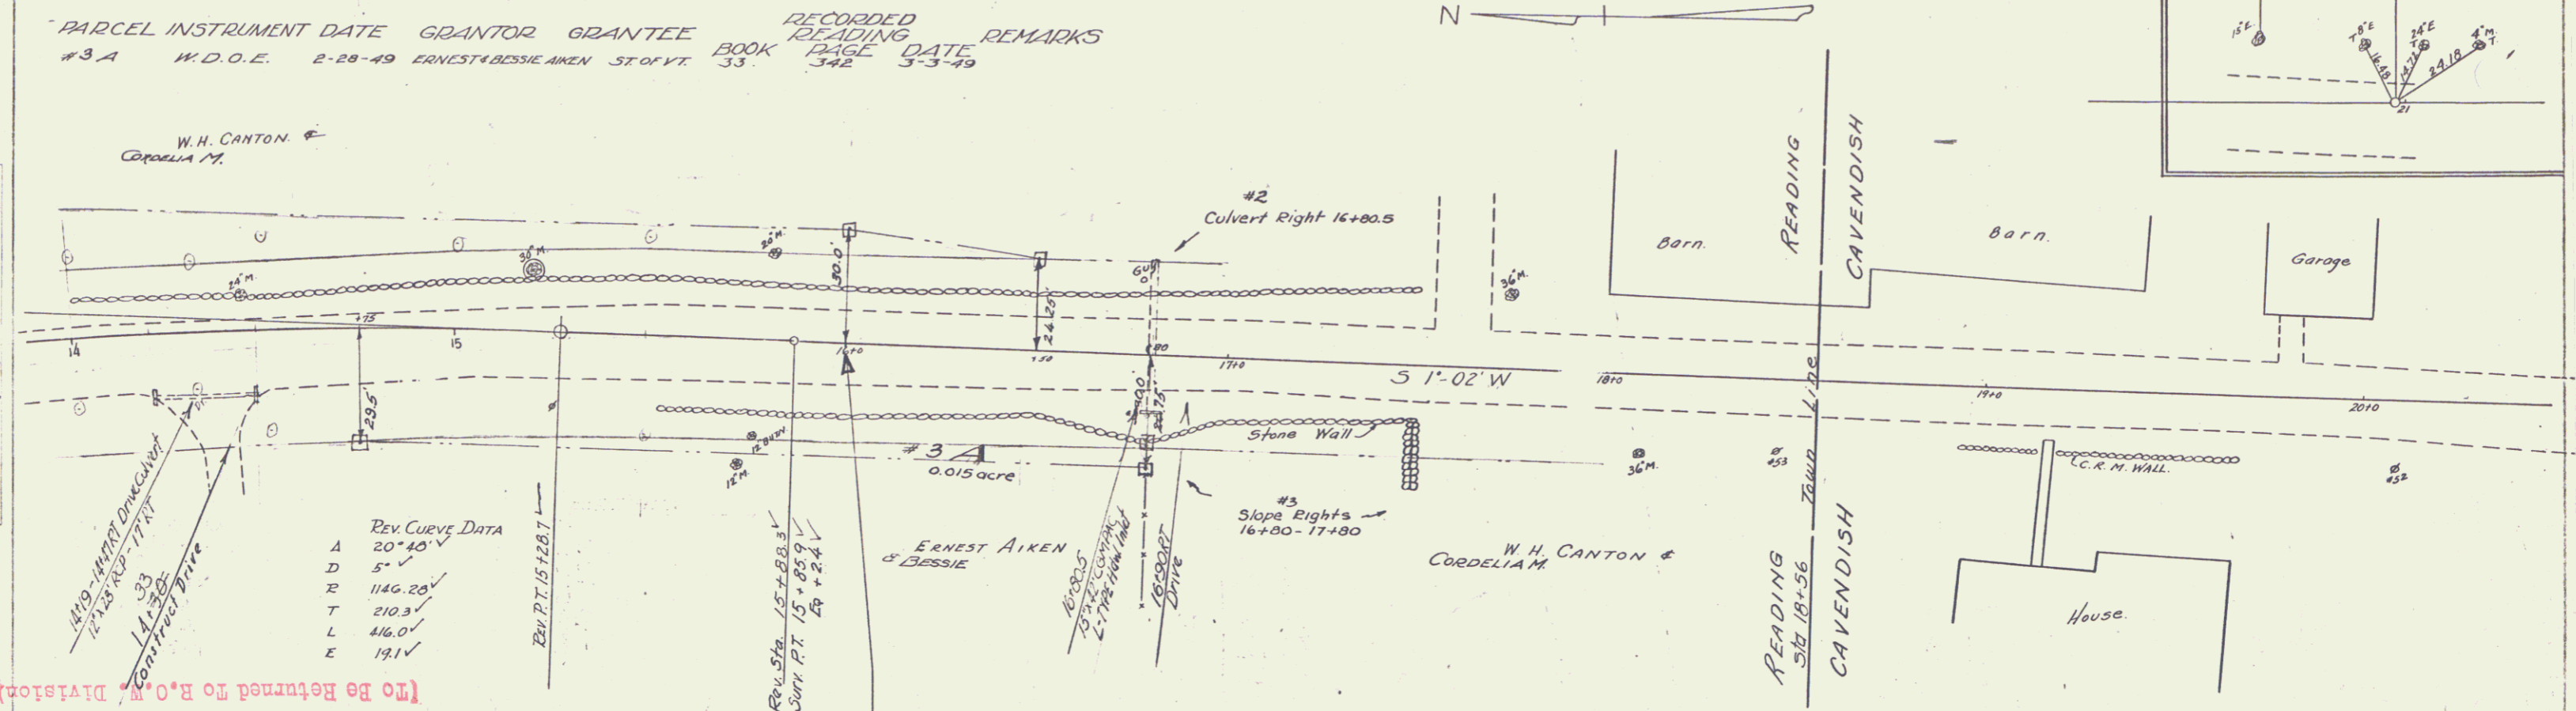

(To Be Returned to R.O.M. Division)

RIGHT-OF-WAY DIVISION  
 DOWN FILE  
 PERPETUAL  
 PLAN OF

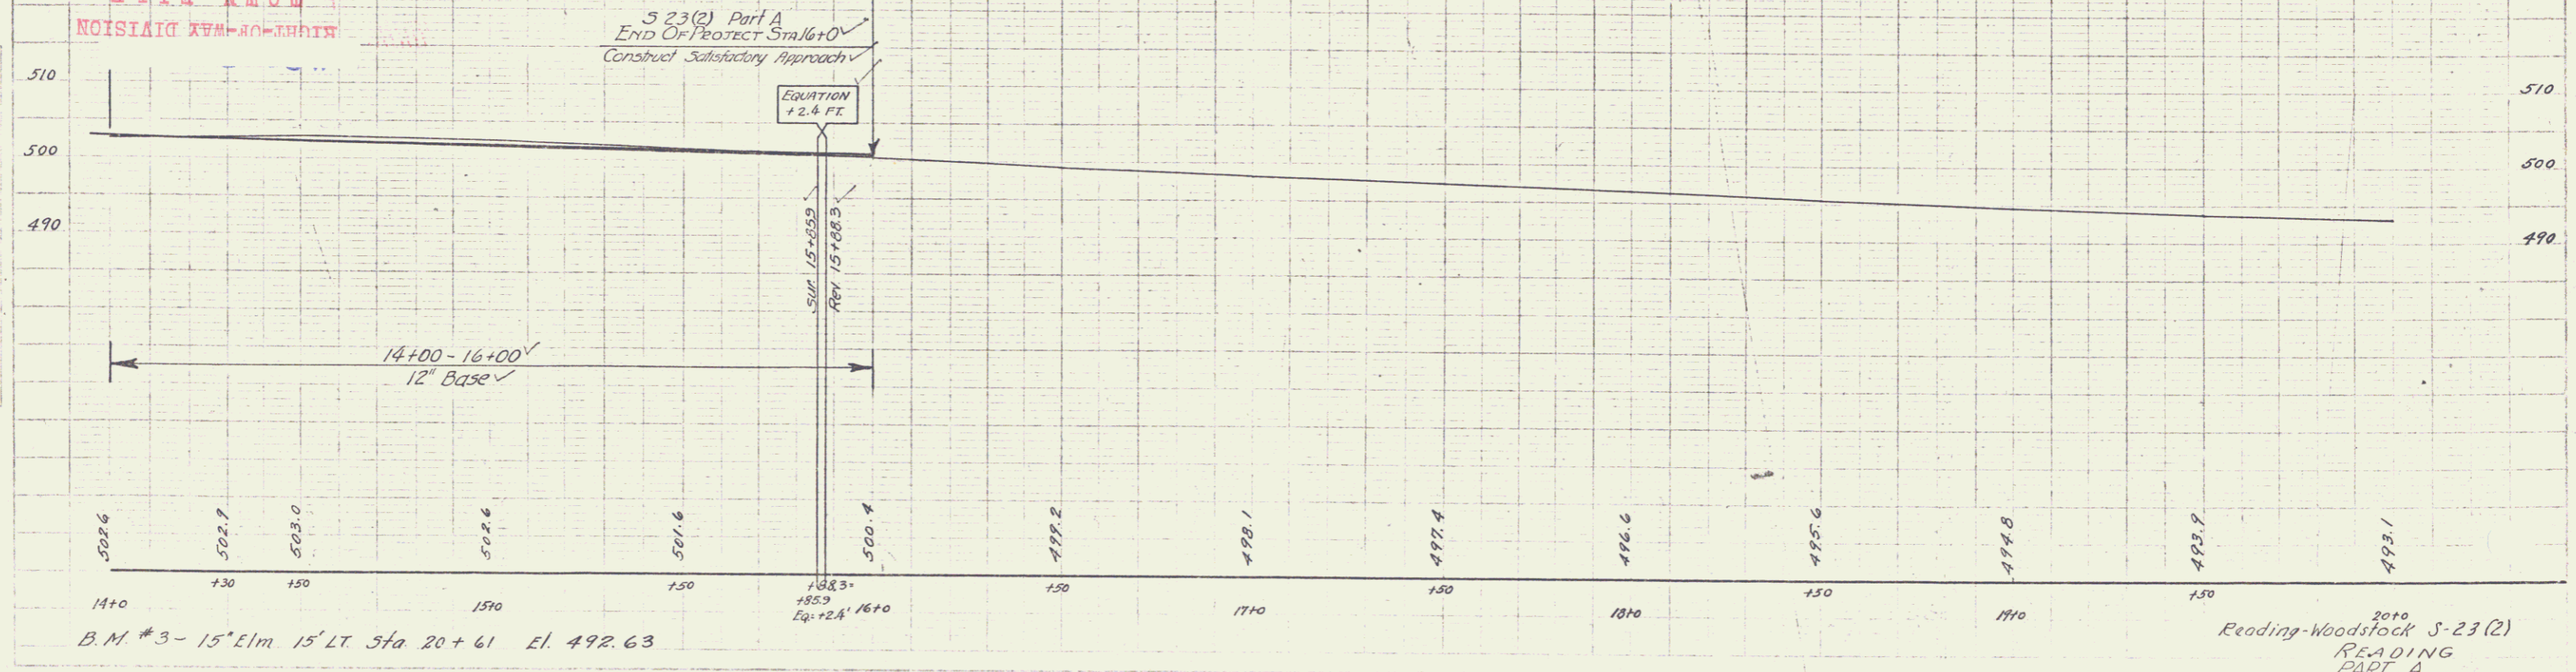

Reading-Woodstock S-23(2)  
 READING  
 PART A

34 9 of 62