
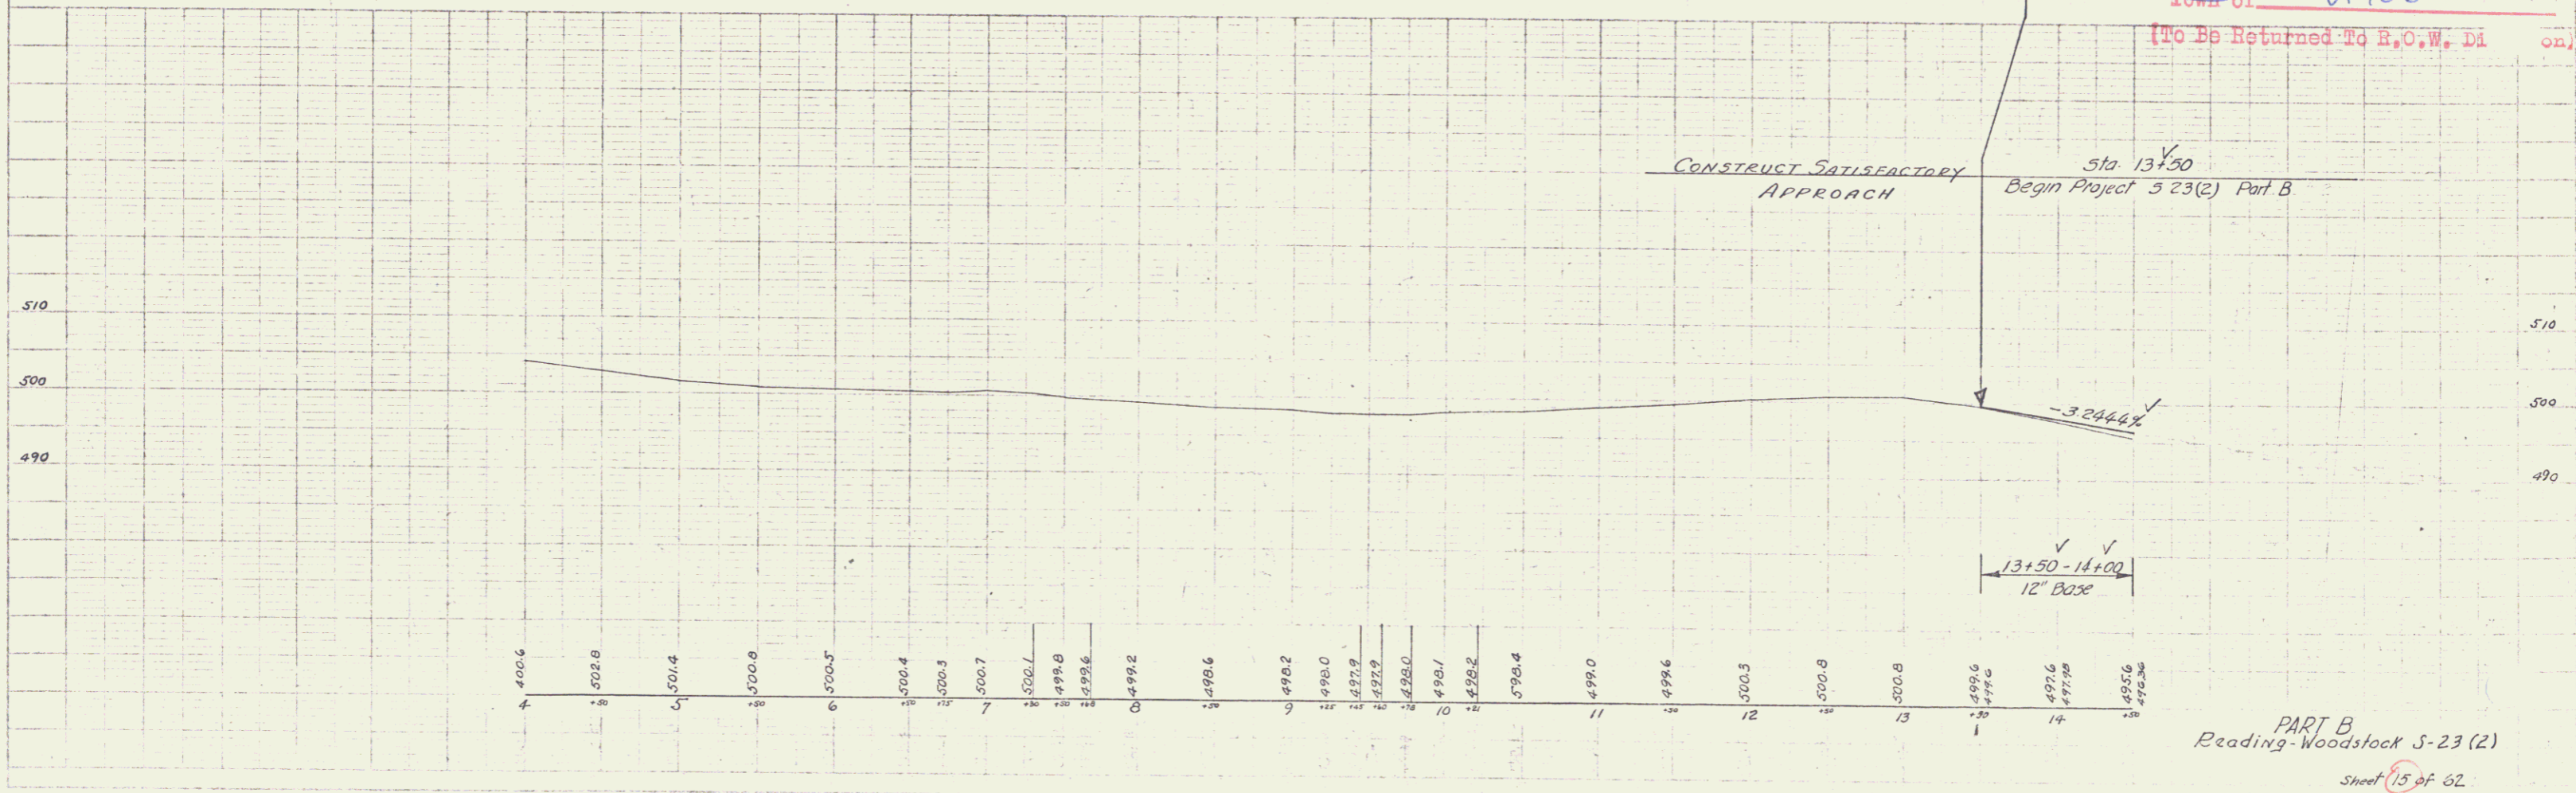


PLAN

DATE	
BY	
CHECKED BY	
APPROVED BY	

PROFILES

DATE	
BY	
CHECKED BY	
APPROVED BY	

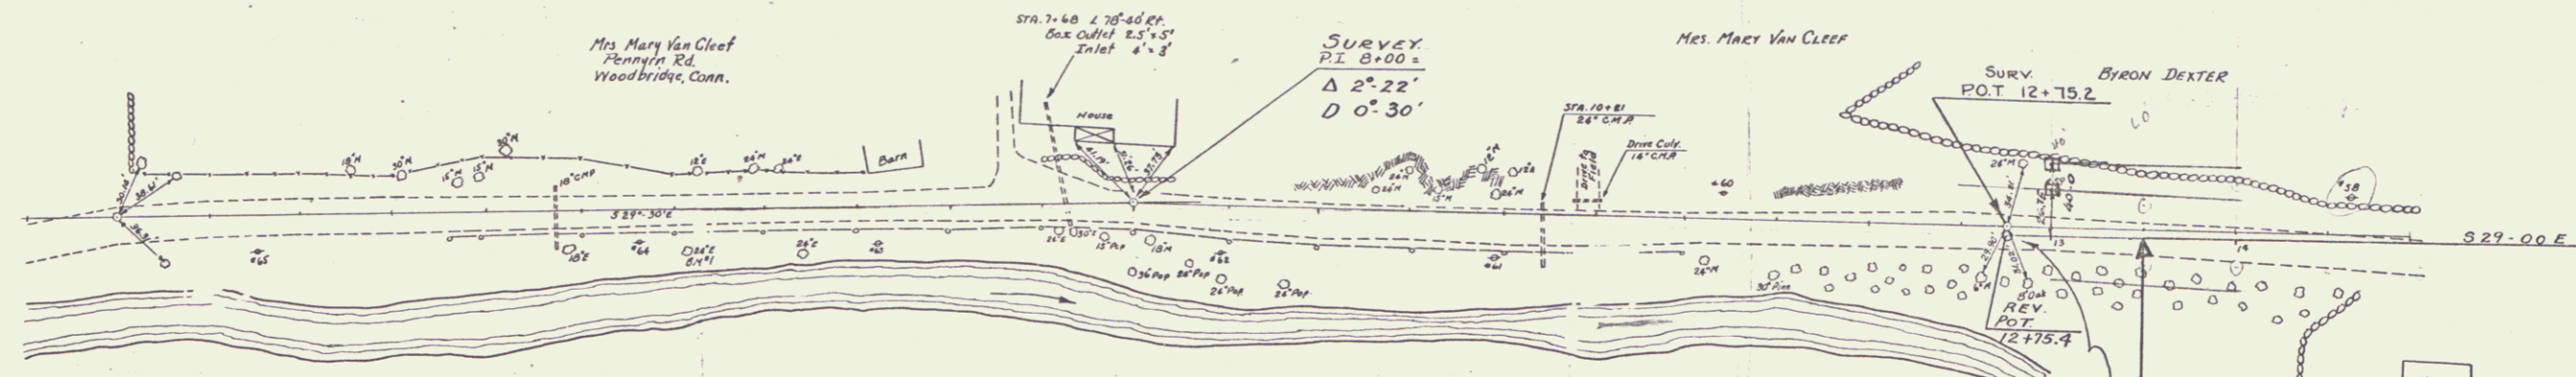

PART B
Reading-Woodstock 5-23(2)
Sheet 15 of 62