



PARCEL INSTRUMENT DATE GRANTOR GRANTEE
 #7 A W.D.O.E. 2-28-49 MAUD L. CADY ST. OF VT.
 RECORDED READING DATE
 BOOK PAGE DATE
 33 345-346 2-28-49

REV. CURVE DATA
 Δ 22°30' ✓
 D 5' ✓
 E 1146.3 ✓
 T 228.0 ✓
 L 450.0 ✓
 E 22.5 ✓

PLAN
 DATE BOOK PAGE
 2/14/49 33 345-346
 DRAWN BY
 CHECKED BY

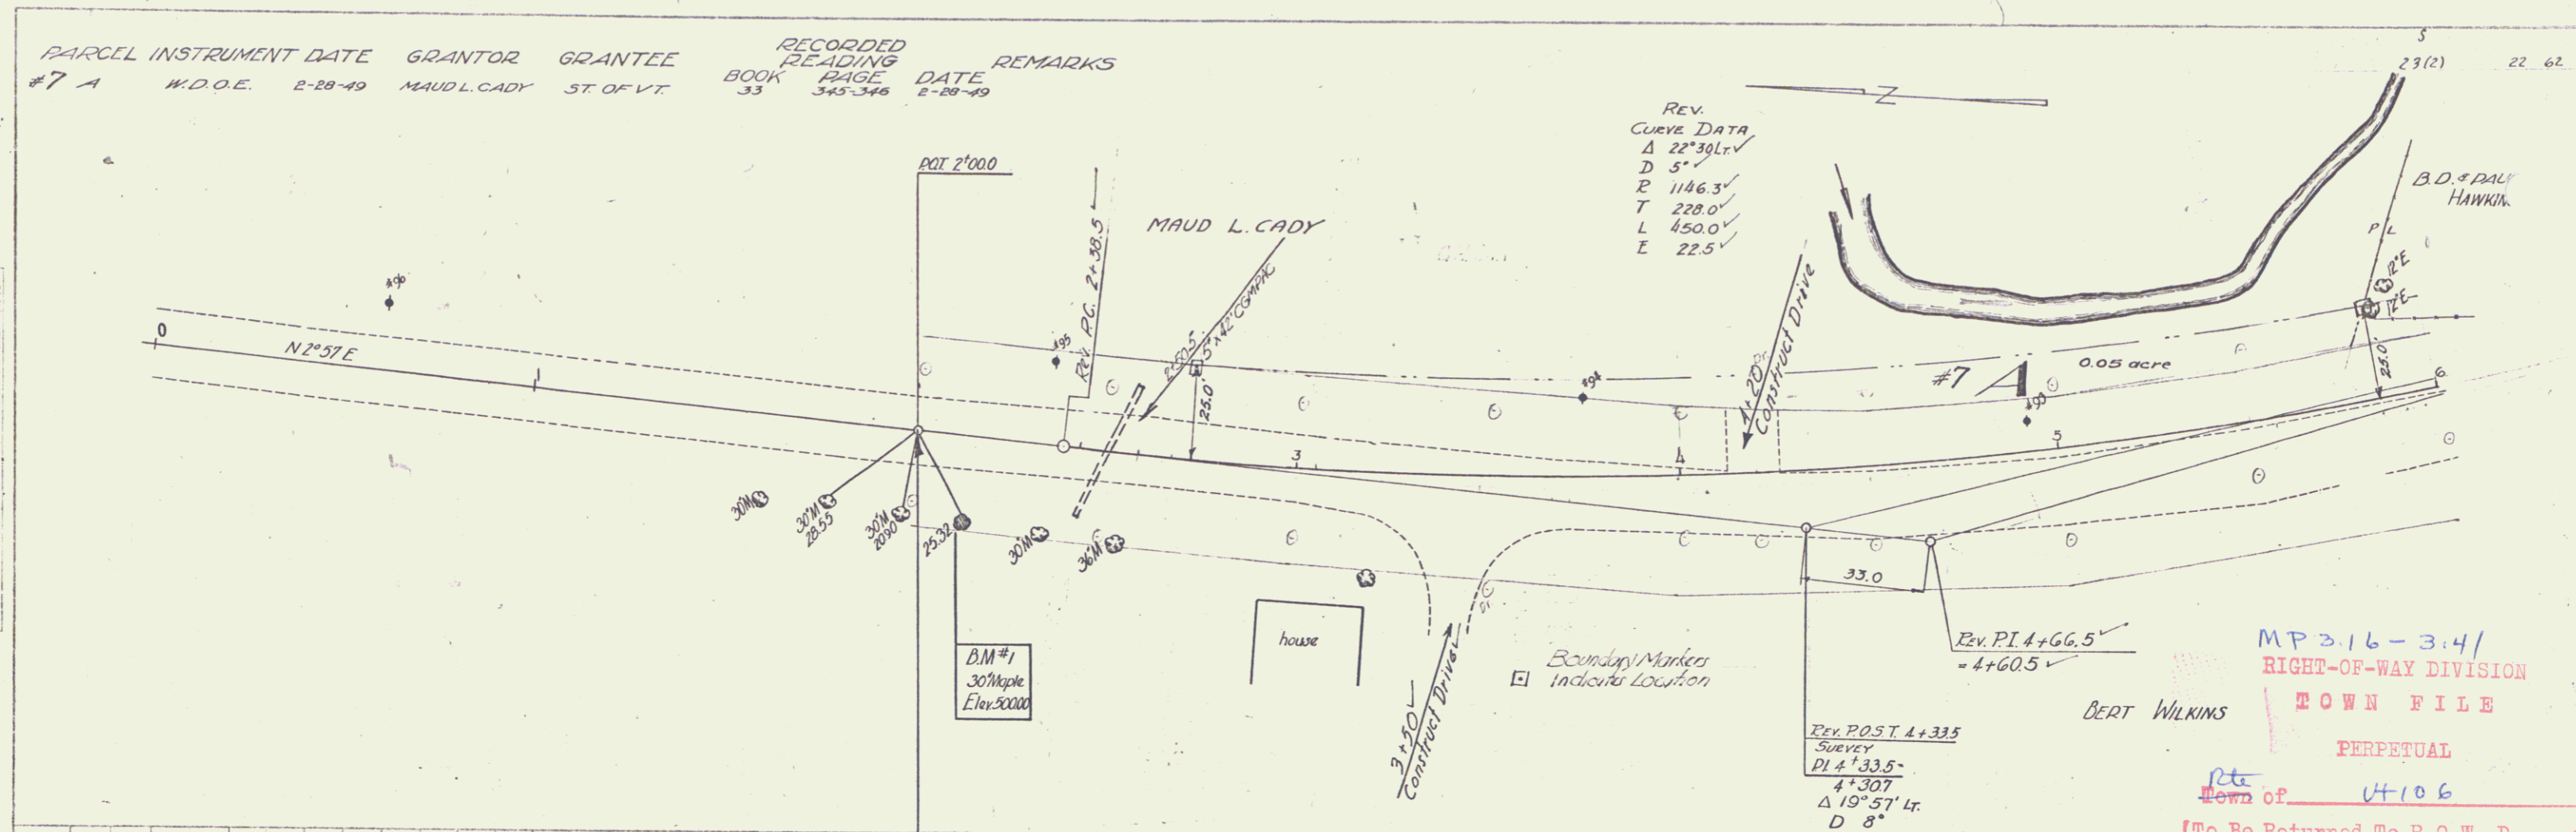

MP 2-16-34/
 RIGHT-OF-WAY DIVISION
 TOWN FILE
 PERPETUAL
 Bert Wilkins
 Town of U+106
 (To Be Returned To R.O.W. I on

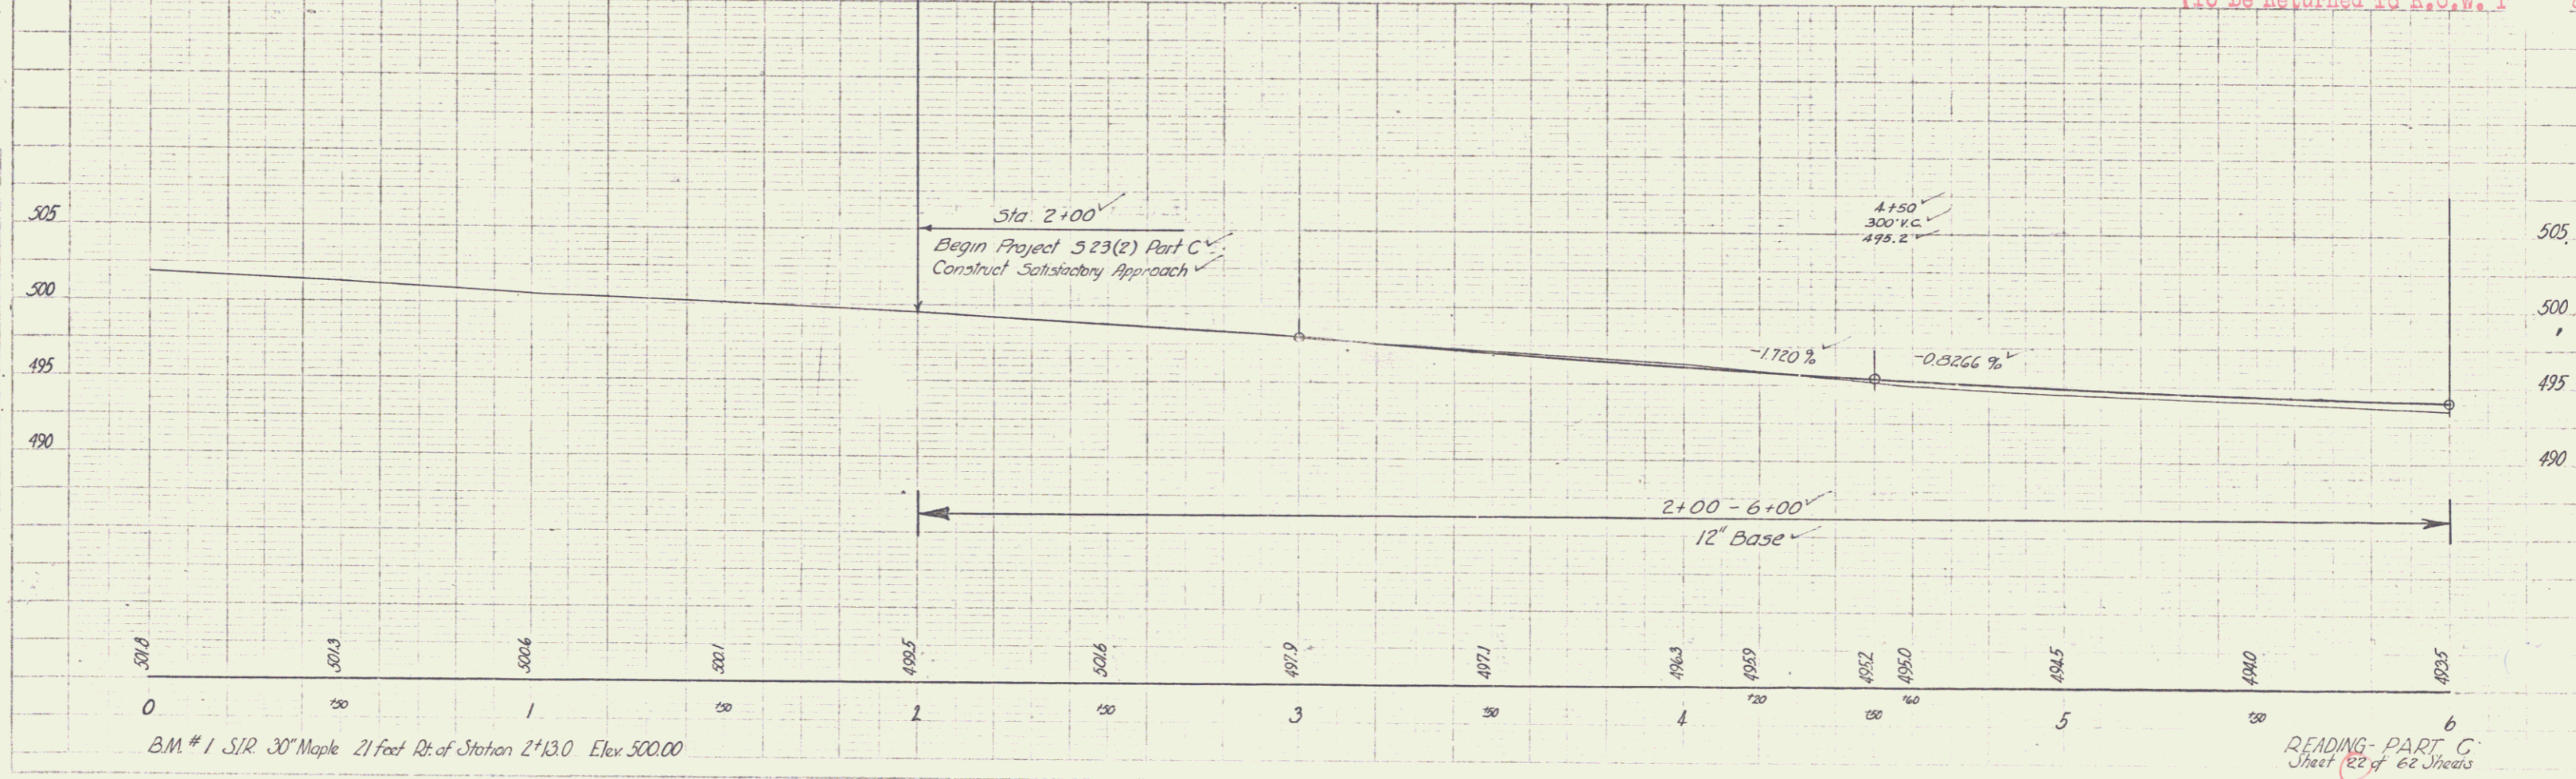

PROFILE
 DATE BOOK PAGE
 2/14/49 33 345-346
 DRAWN BY
 CHECKED BY

READING - PART C
 Sheet 22 of 62 Sheets