


PARCEL INSTRUMENT #	DATE	GRANTOR	GRANTEE	BOOK	WOODSTOCK PAGE	RECORDED DATE	REMARKS
# A	W.D. 2-28-49	SARAH ANNA BAGLEY	STOFVT. 49	49	534	3-3-49	

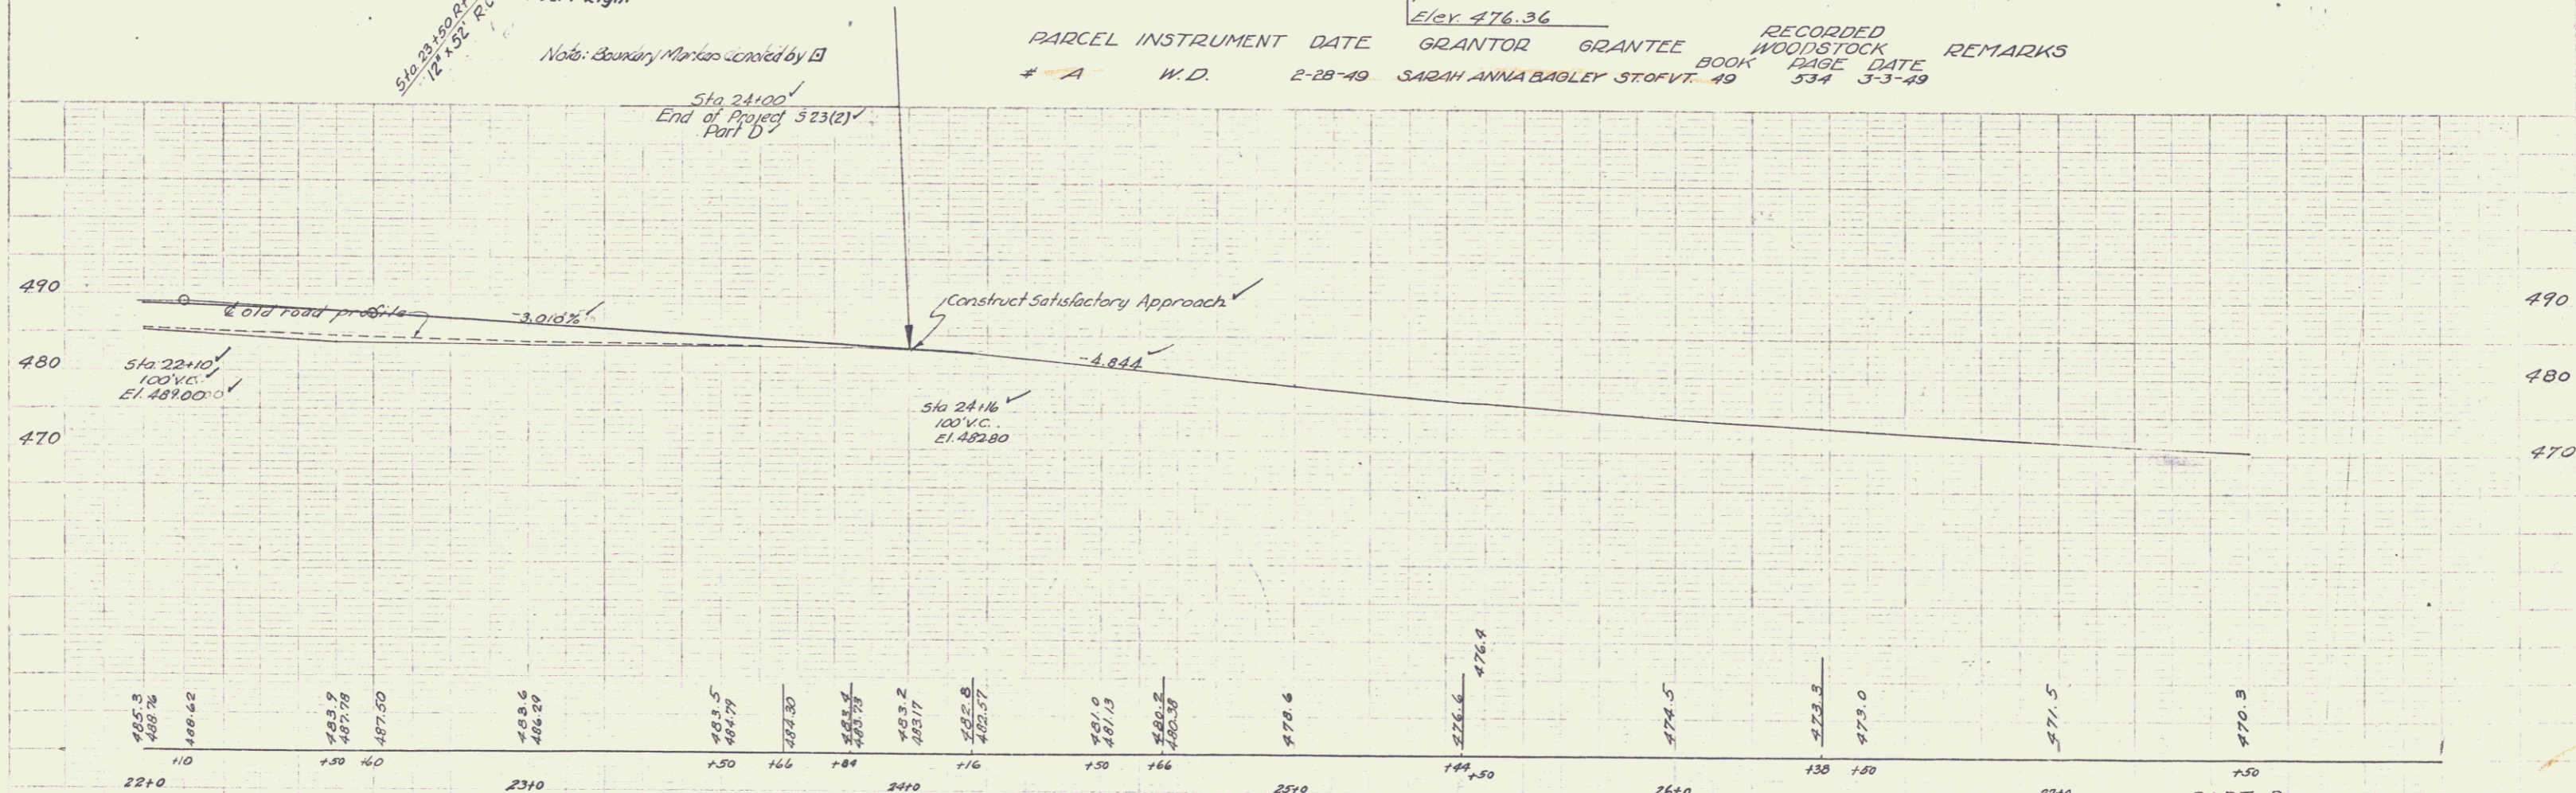

B.M. #3 spike in root 18" M. - 21' RT. STA. 25+37 Elev. 476.36

PART D
 Reading, Woodstock S-23(2)
 SOUTH WOODSTOCK VILLAGE BR.
 5 23(2)
 sheet 32 of 62