
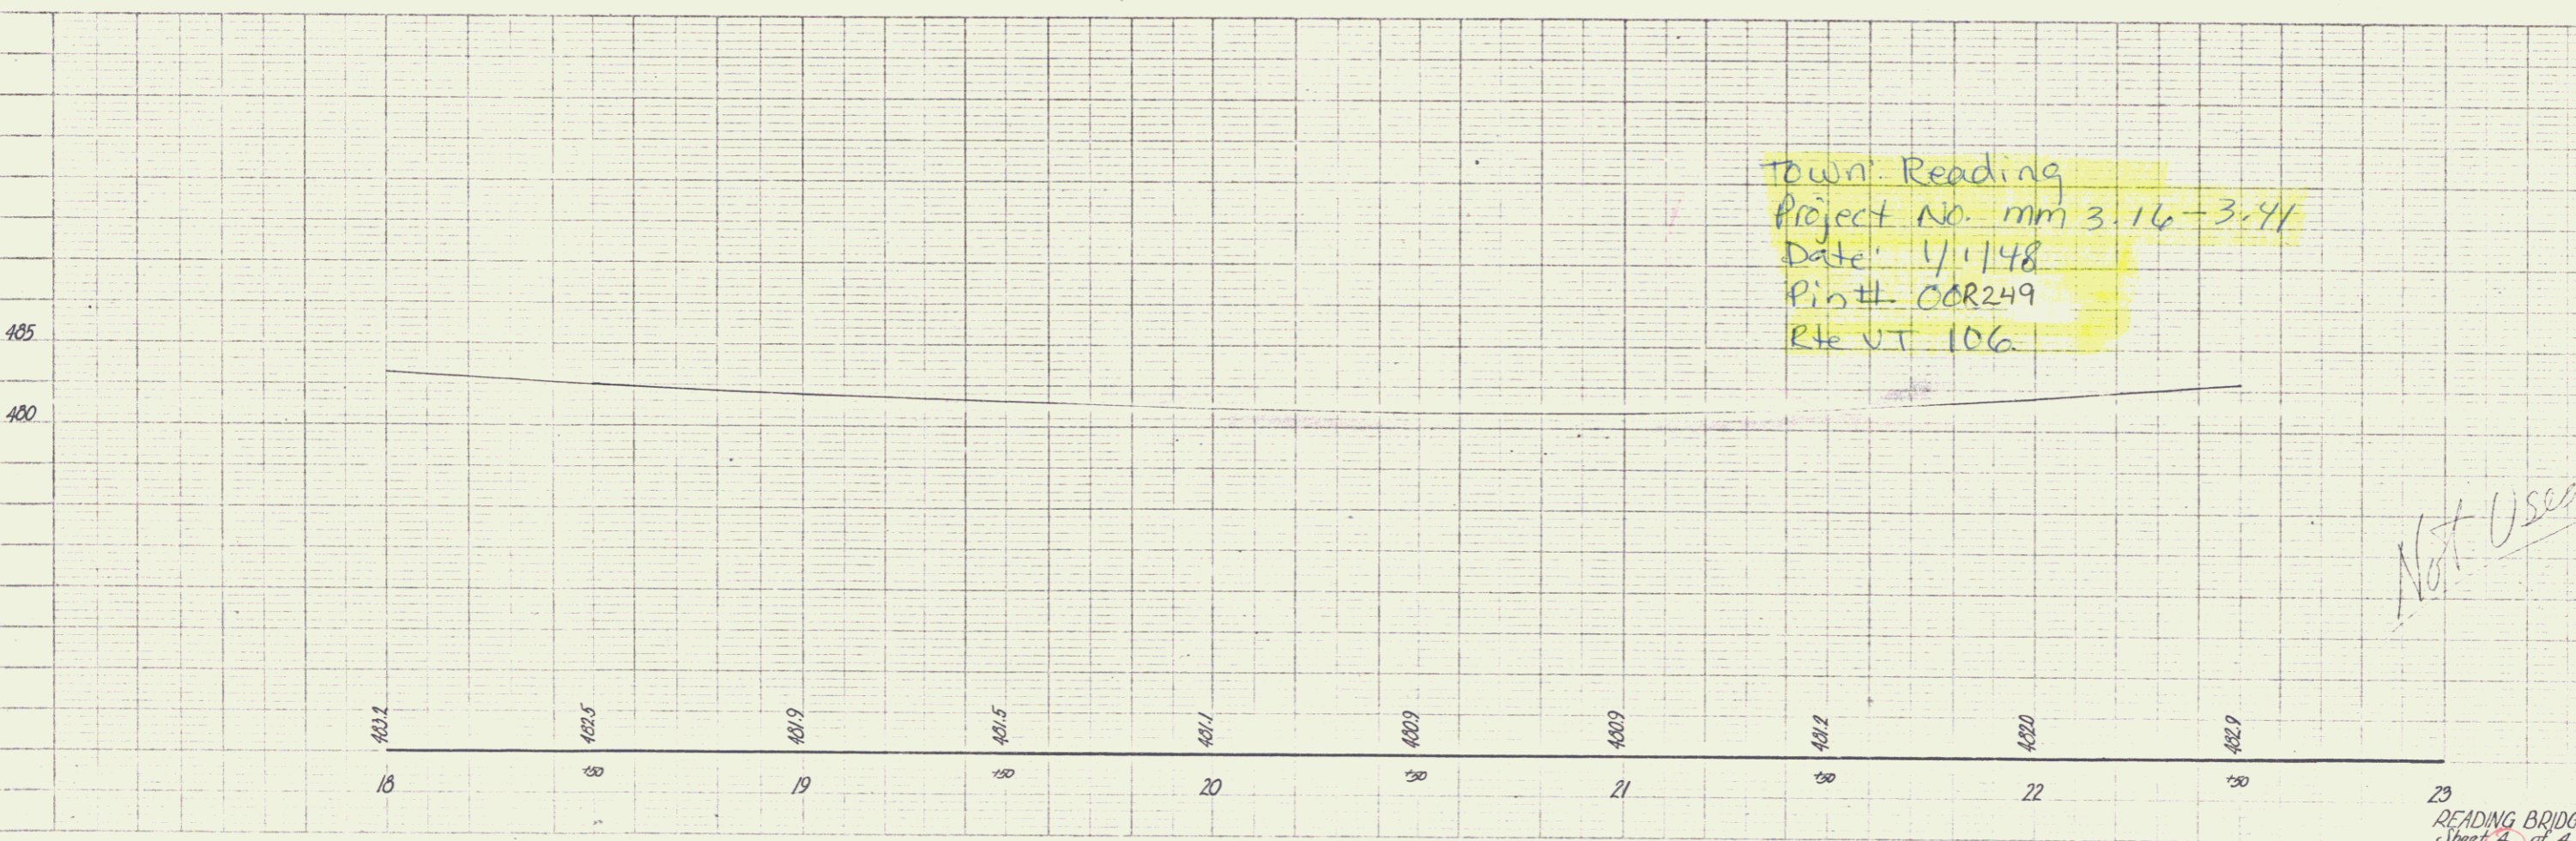


PLAN
 DATE
 SHEET NO. 116
 OF 118
 A. Haughton
 G. Haughton

PLAN
 DATE
 SHEET NO. 116
 OF 118
 A. Haughton
 G. Haughton

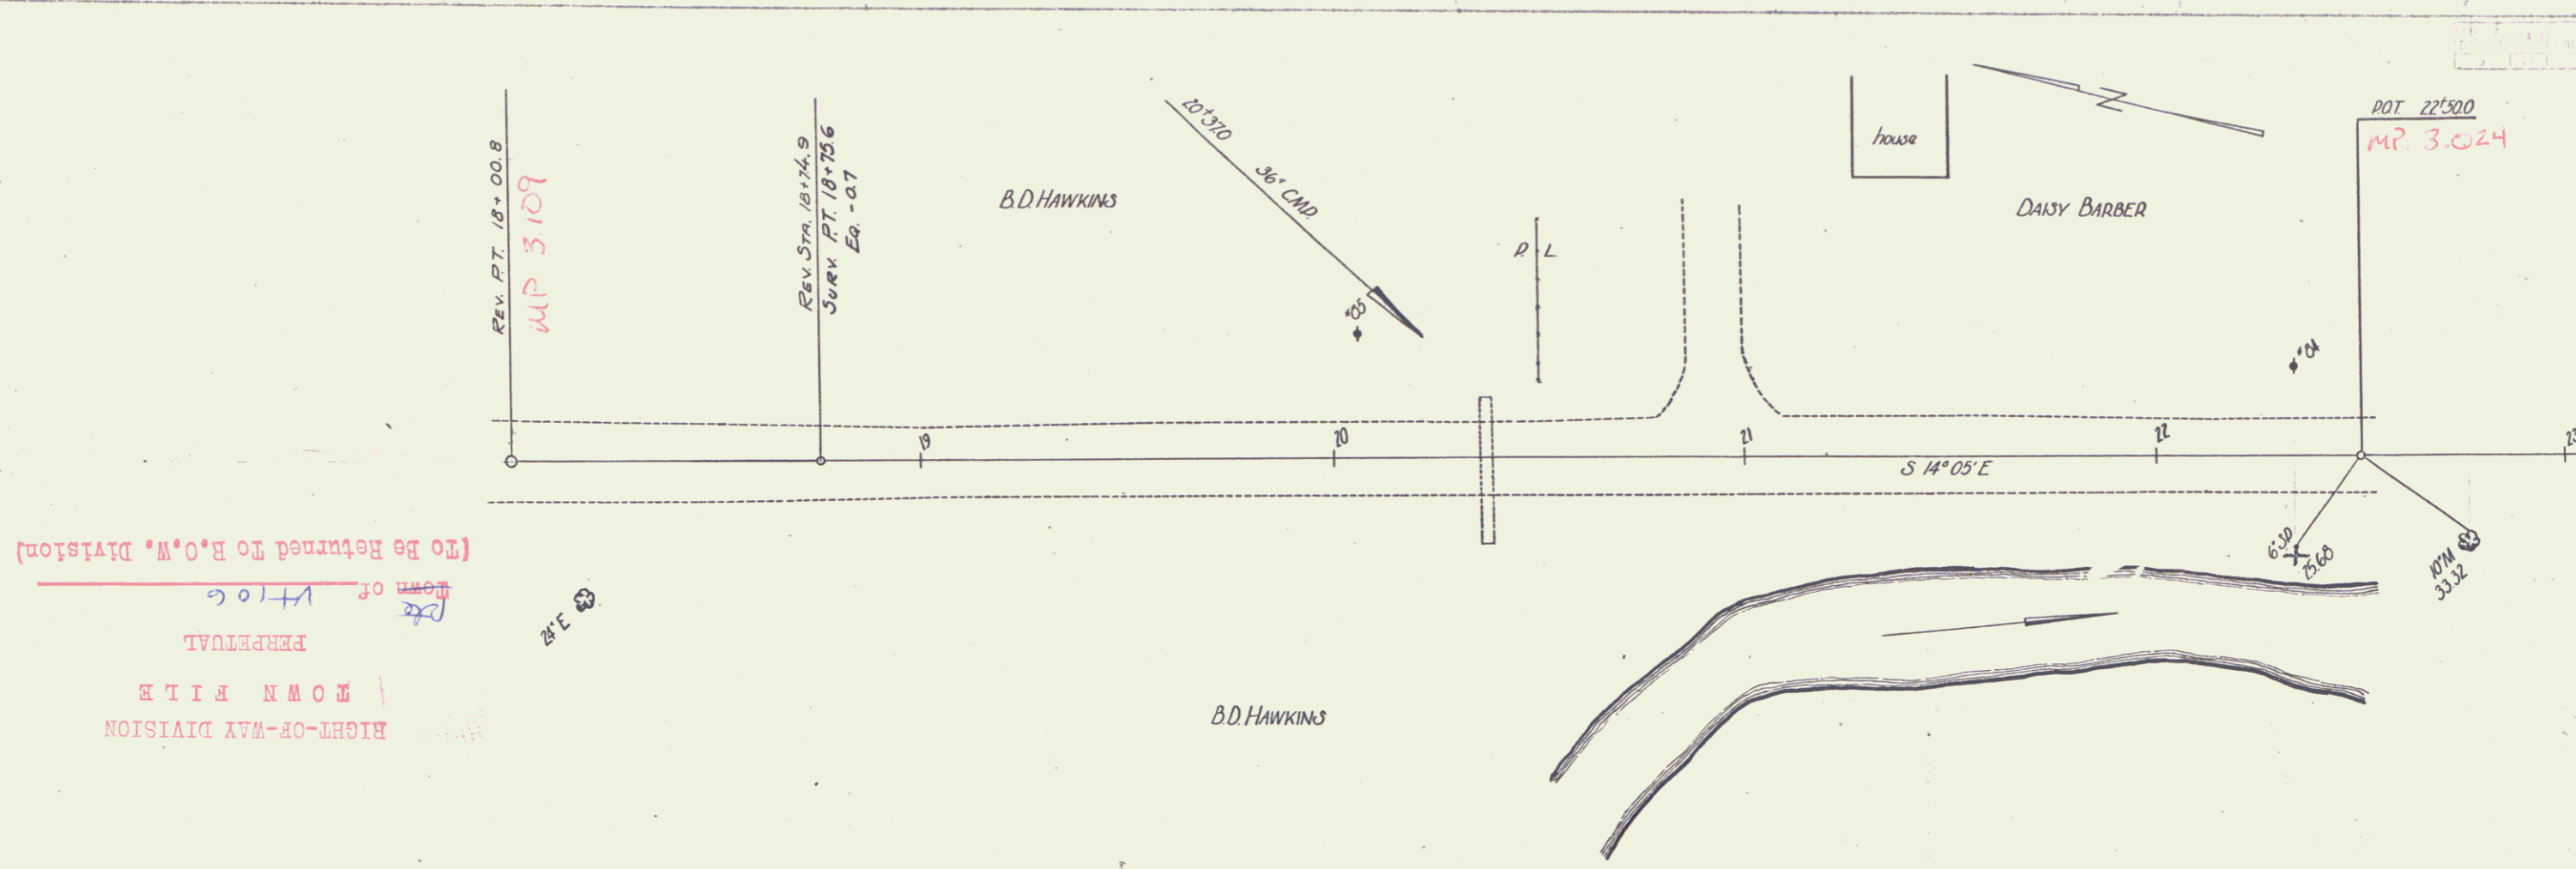

BRIGHT-OF-WAY DIVISION
 TOWN FILE
 PERPETUAL
 Form of VT 106
 (To Be Returned To R.O.W. Division)

READING BRIDGE # 3
 Sheet 4 of 4 Sheets

(4)