
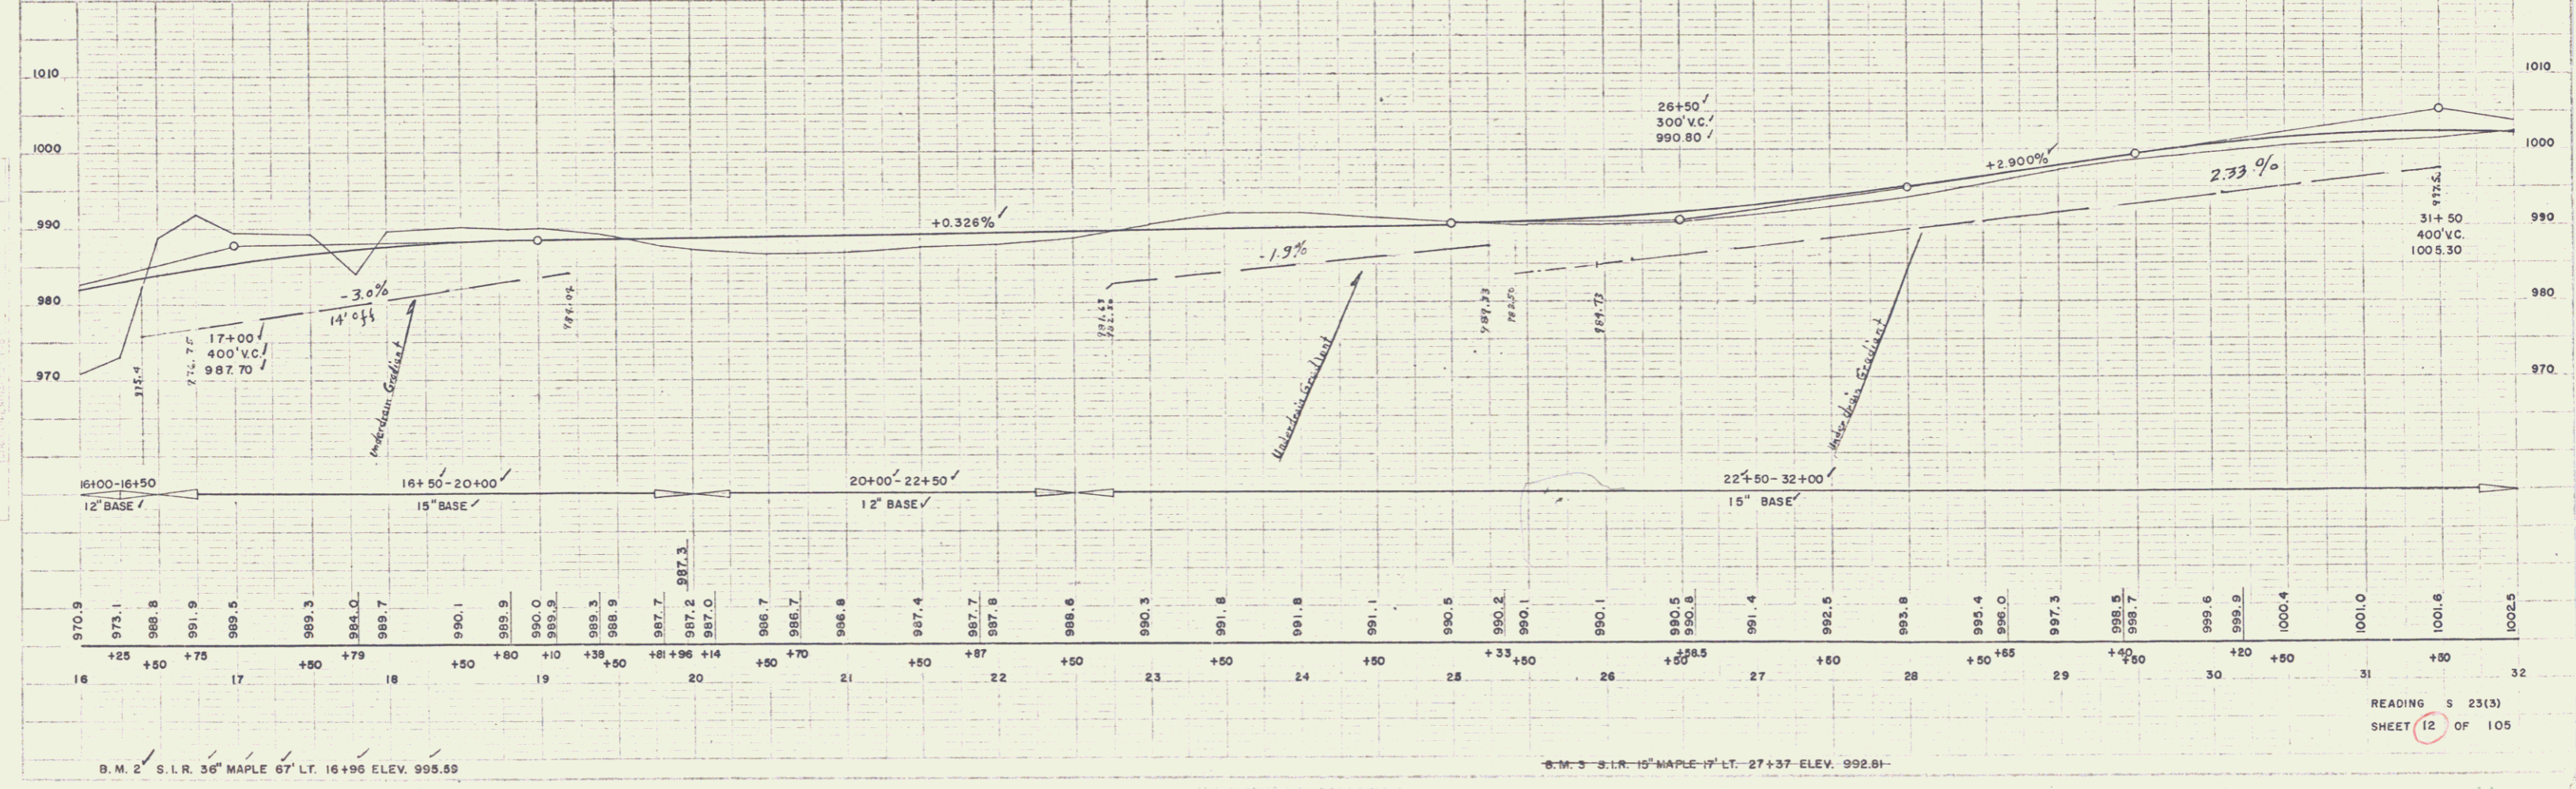


JEWETT
WEBSTER-MARTIN INC.
11-54

JEWETT
WEBSTER-MARTIN INC.
11-54

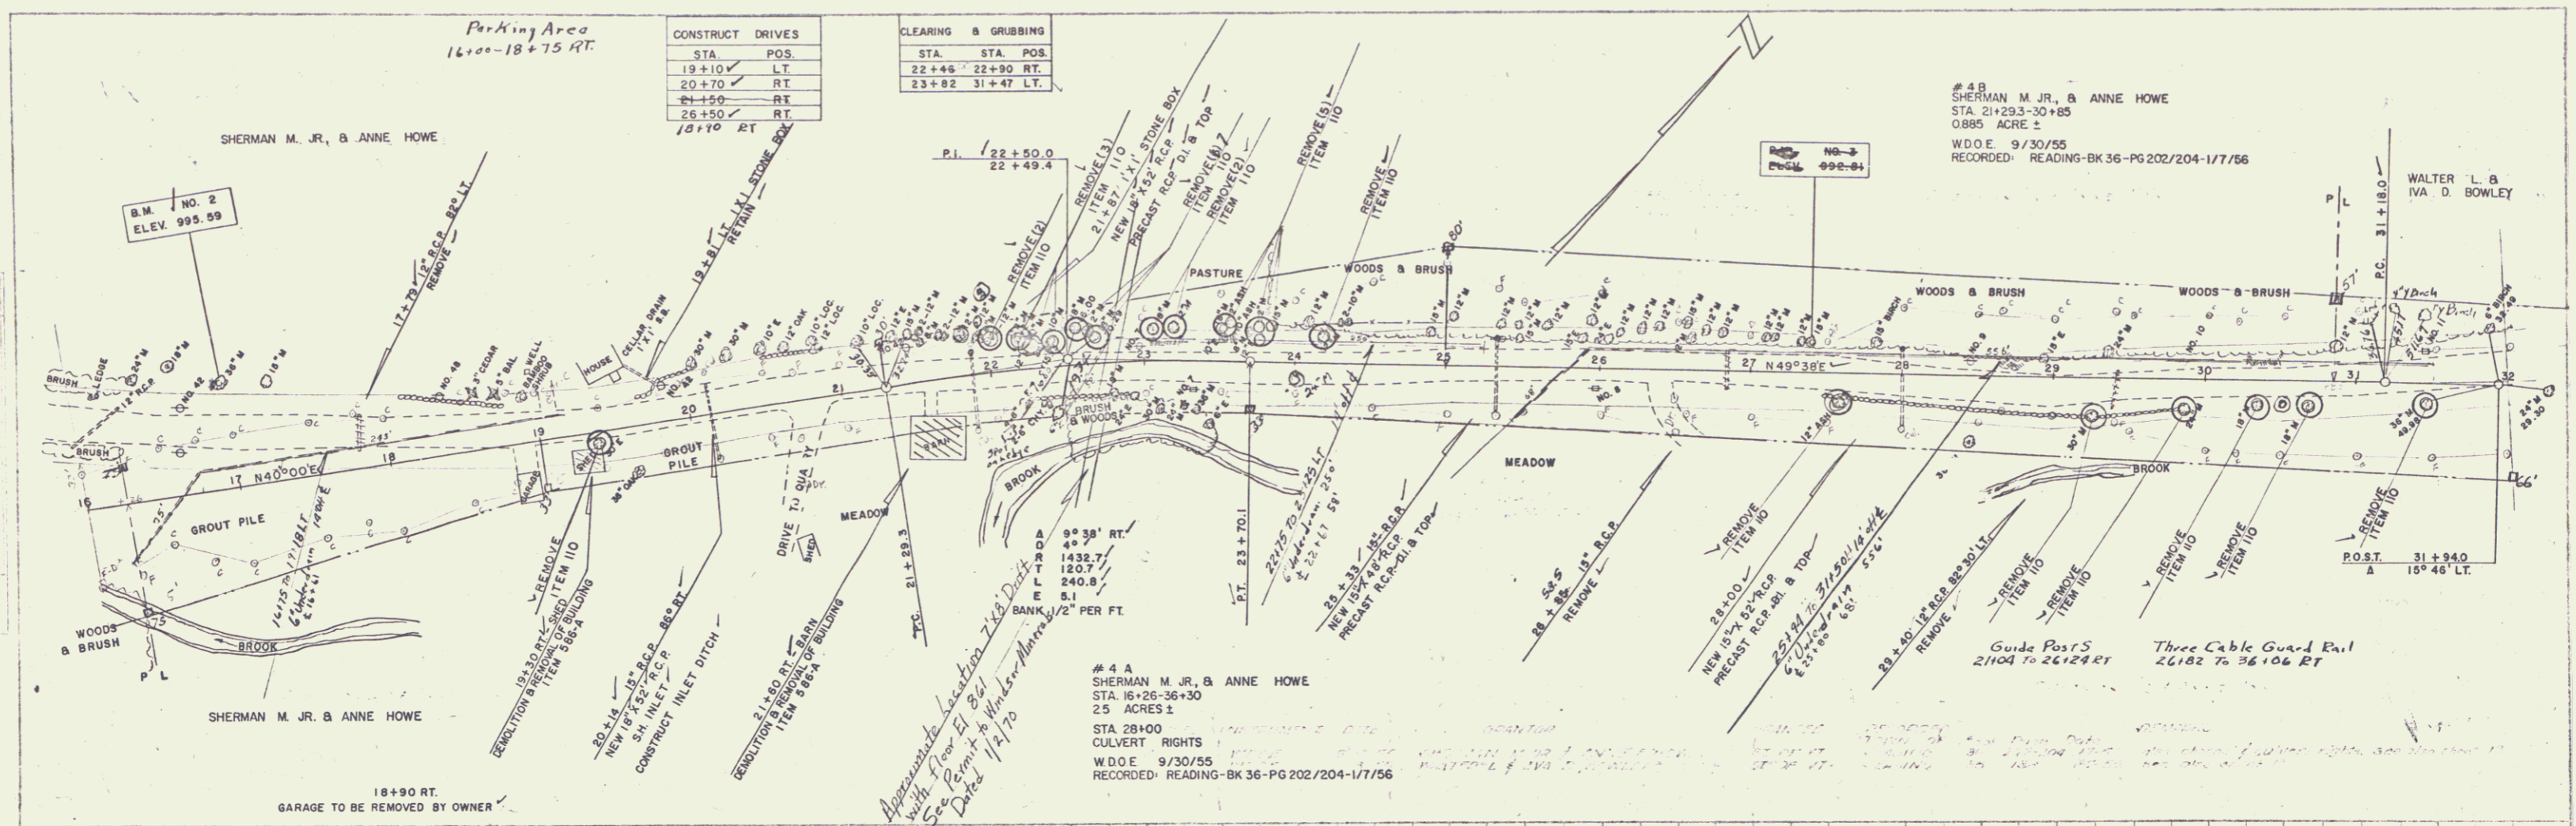

READING S 23(3)
SHEET 12 OF 105

4