


JEFFREY
WEBSTER-MARTIN INC.
11-54

JEFFREY
WEBSTER-MARTIN INC.
11-54

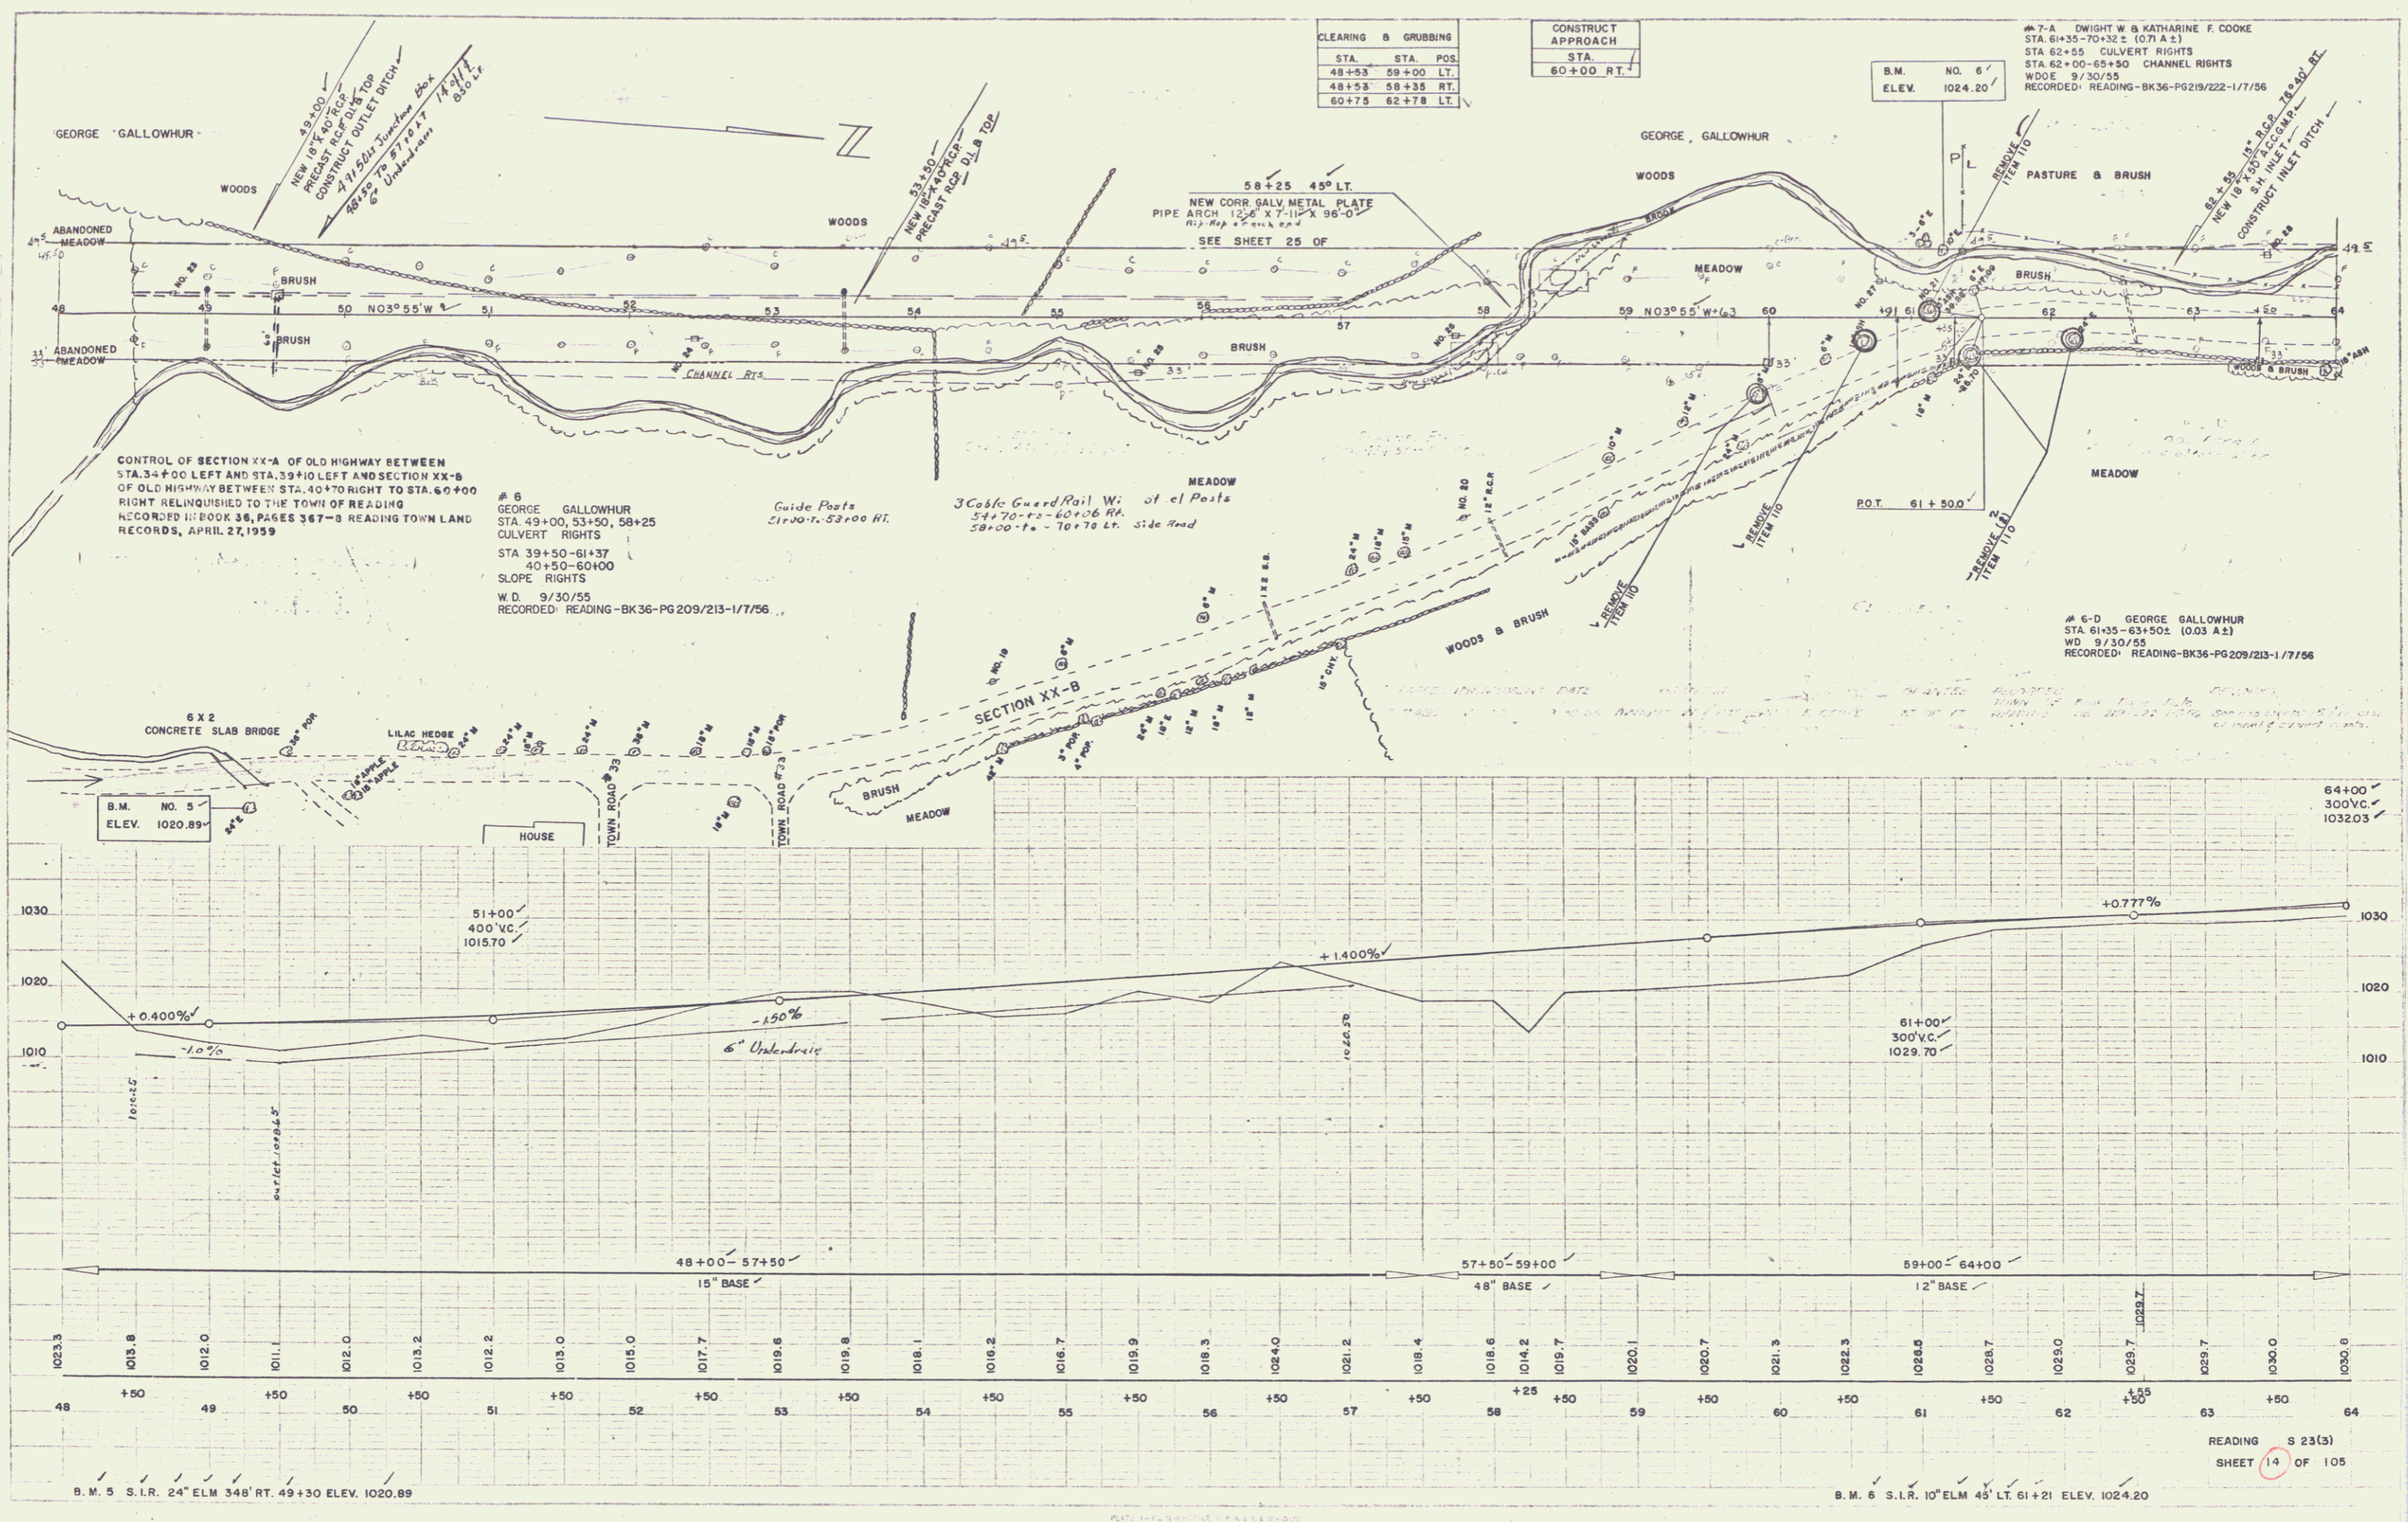

6