
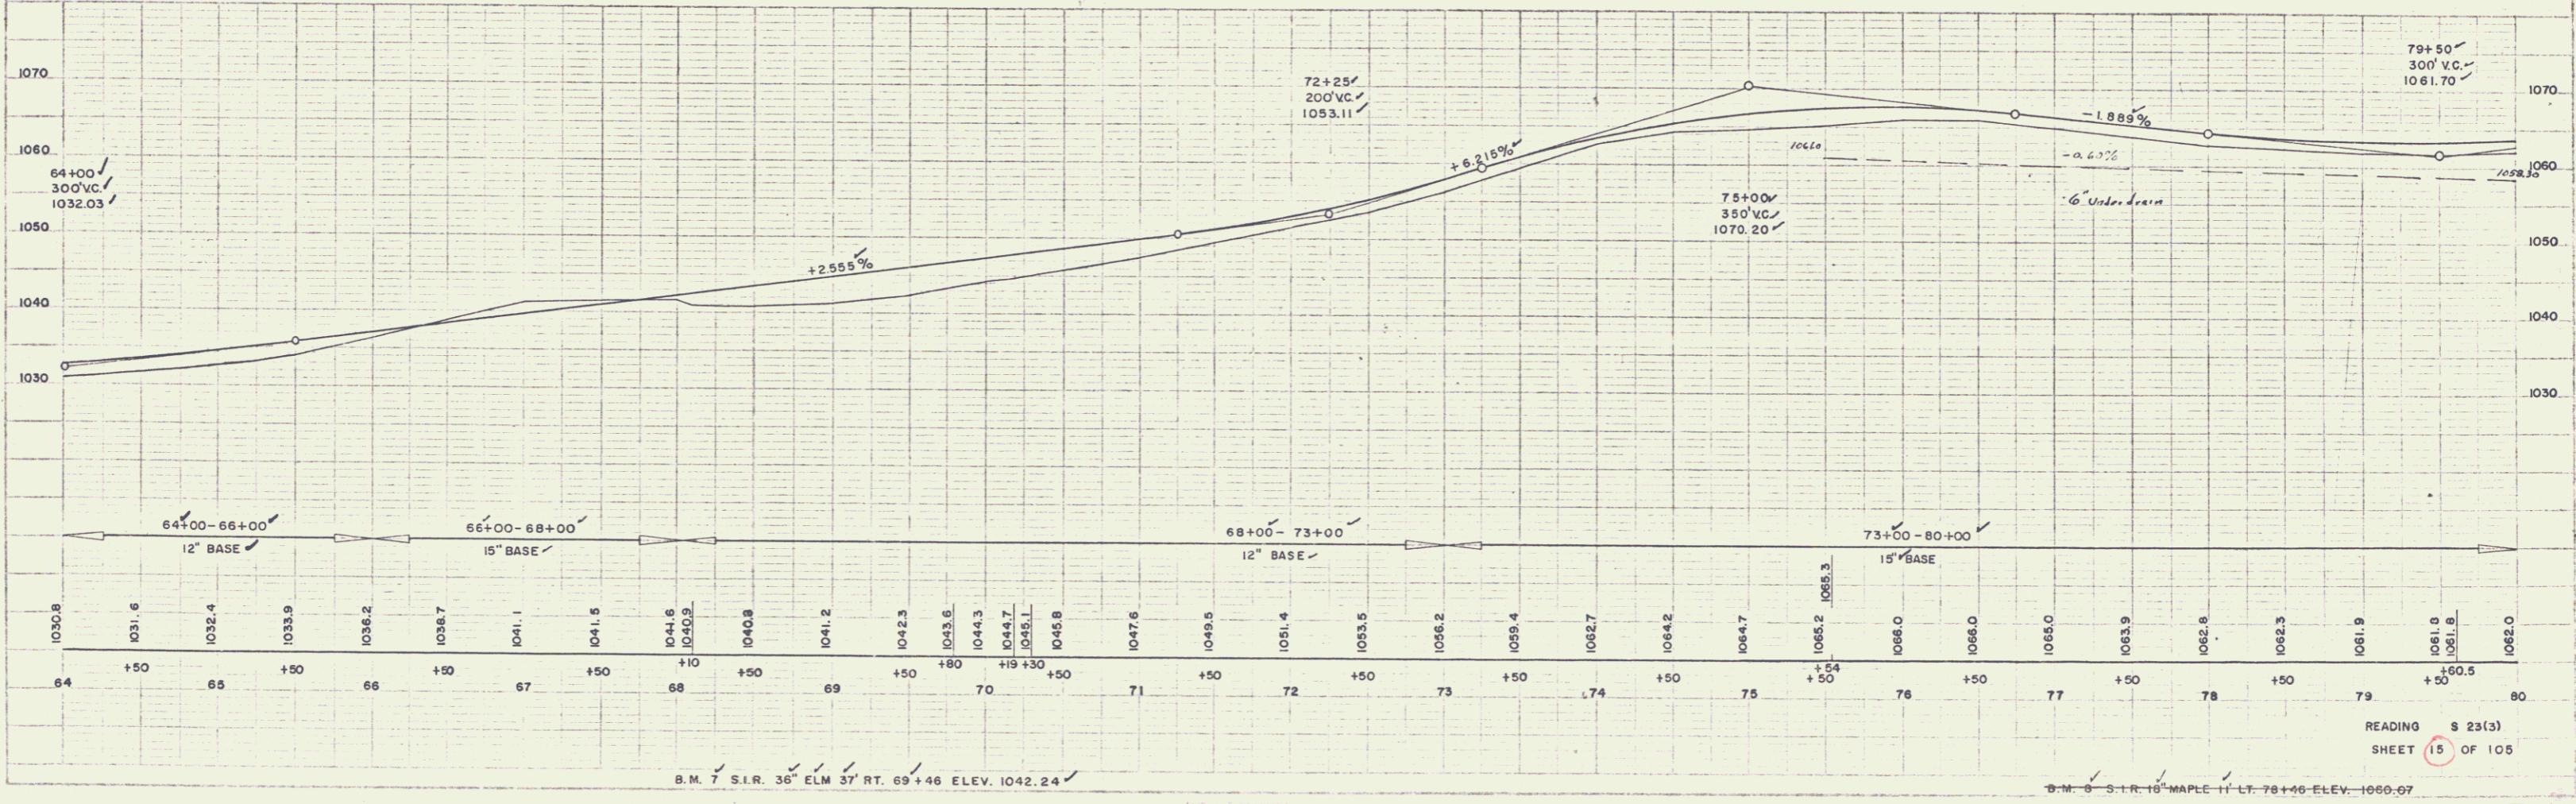


WEBSTER-MARTIN INC. 11-54
 PLAN
 DATE BOOK
 DRAWN BY
 CHECKED BY

WEBSTER-MARTIN INC. 11-54
 PROFILE
 DATE BOOK
 DRAWN BY
 CHECKED BY

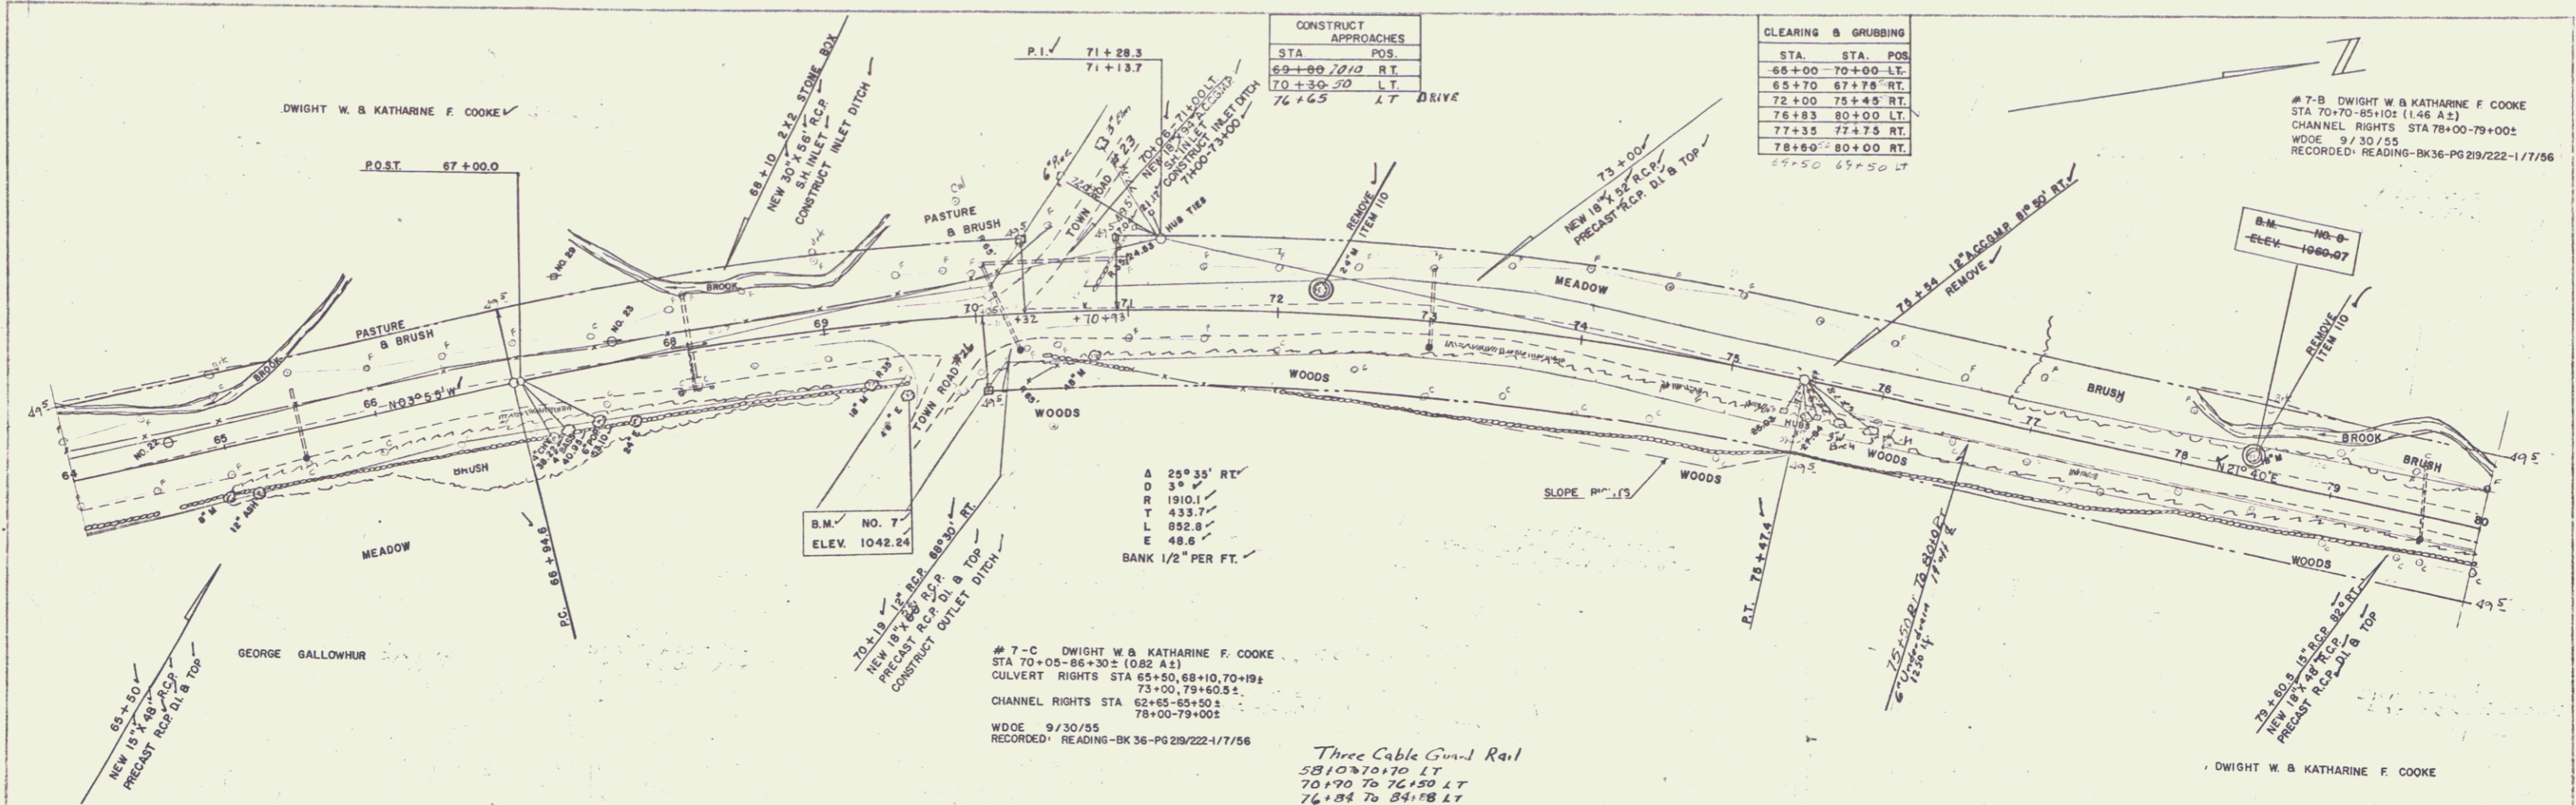

B.M. 7 S.I.R. 36' ELM 37' RT. 69+46 ELEV. 1042.24

B.M. 8 S.I.R. 18' MAPLE 11' LT. 78+46 ELEV. 1060.07

READING S 23(3)
 SHEET 15 OF 105

7