
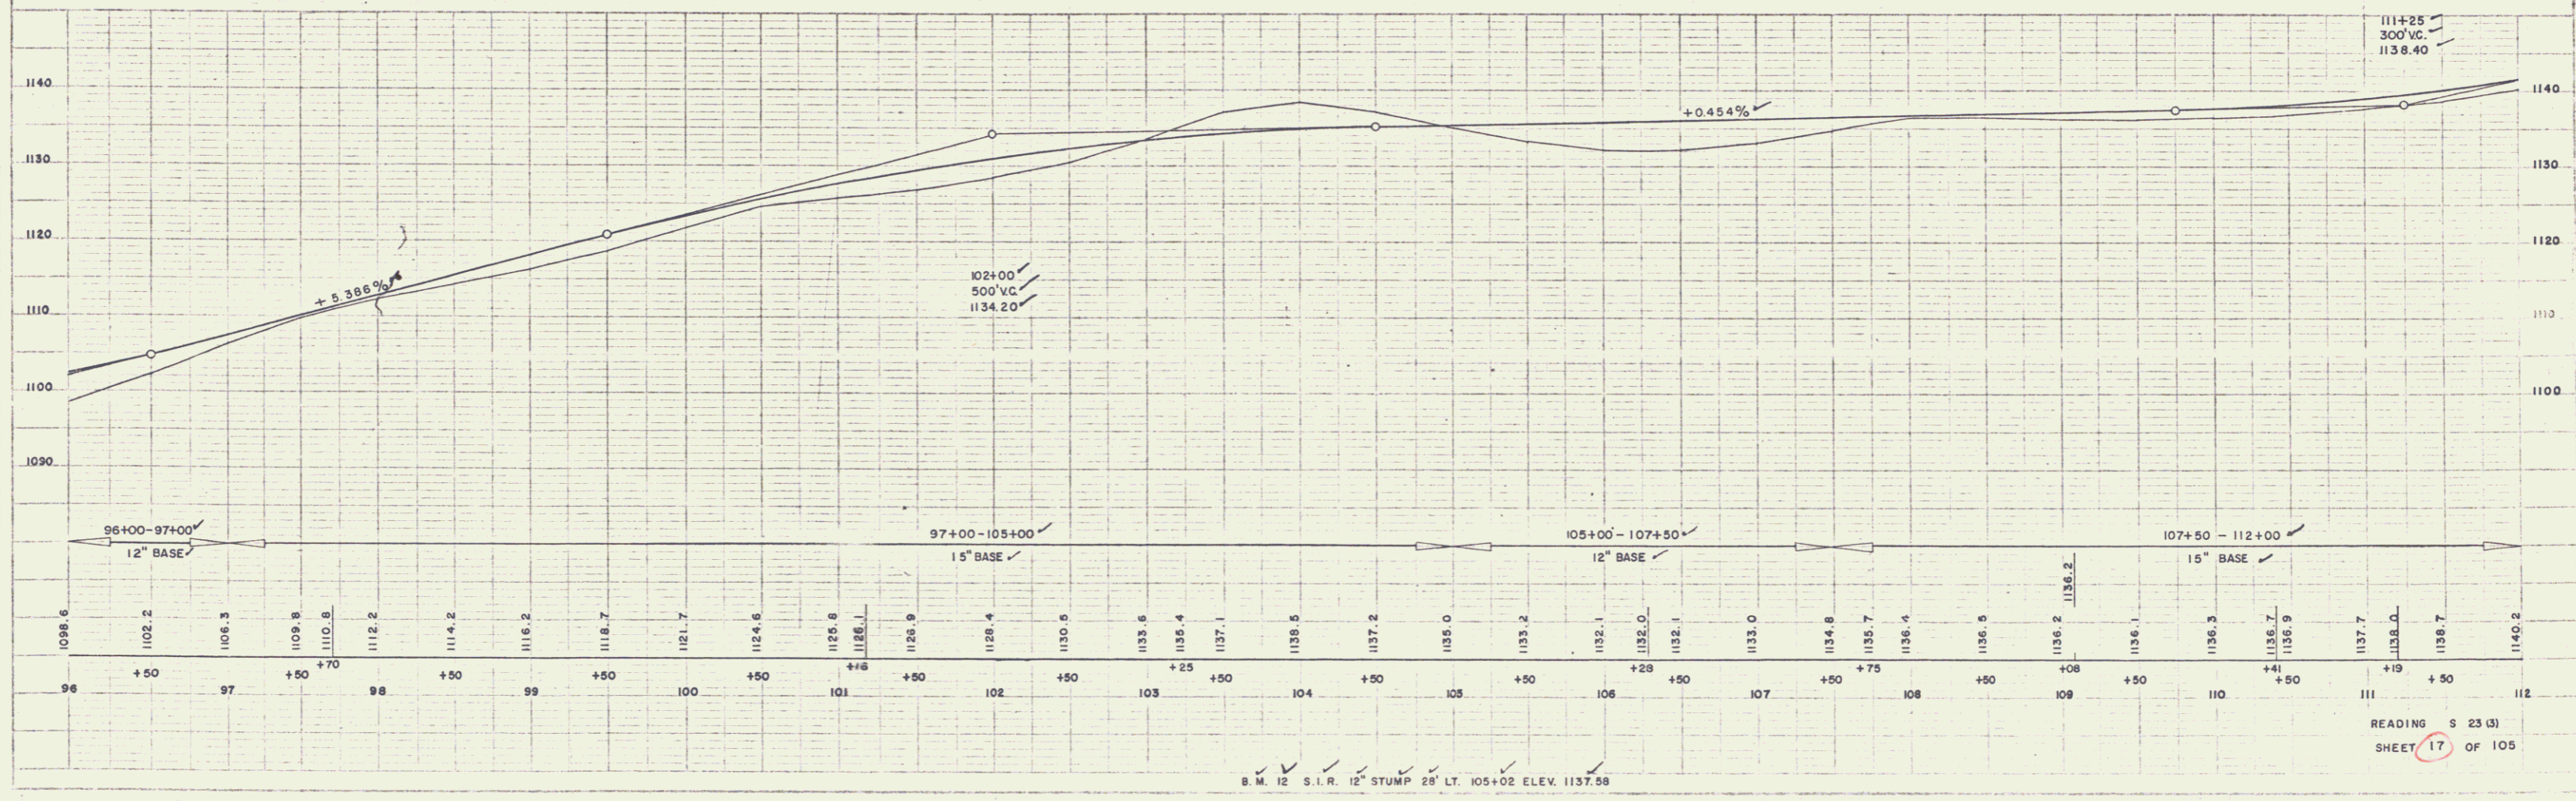


JEFFREY
WEBSTER-MARTIN INC. 11-44

JEFFREY
WEBSTER-MARTIN INC. 11-44

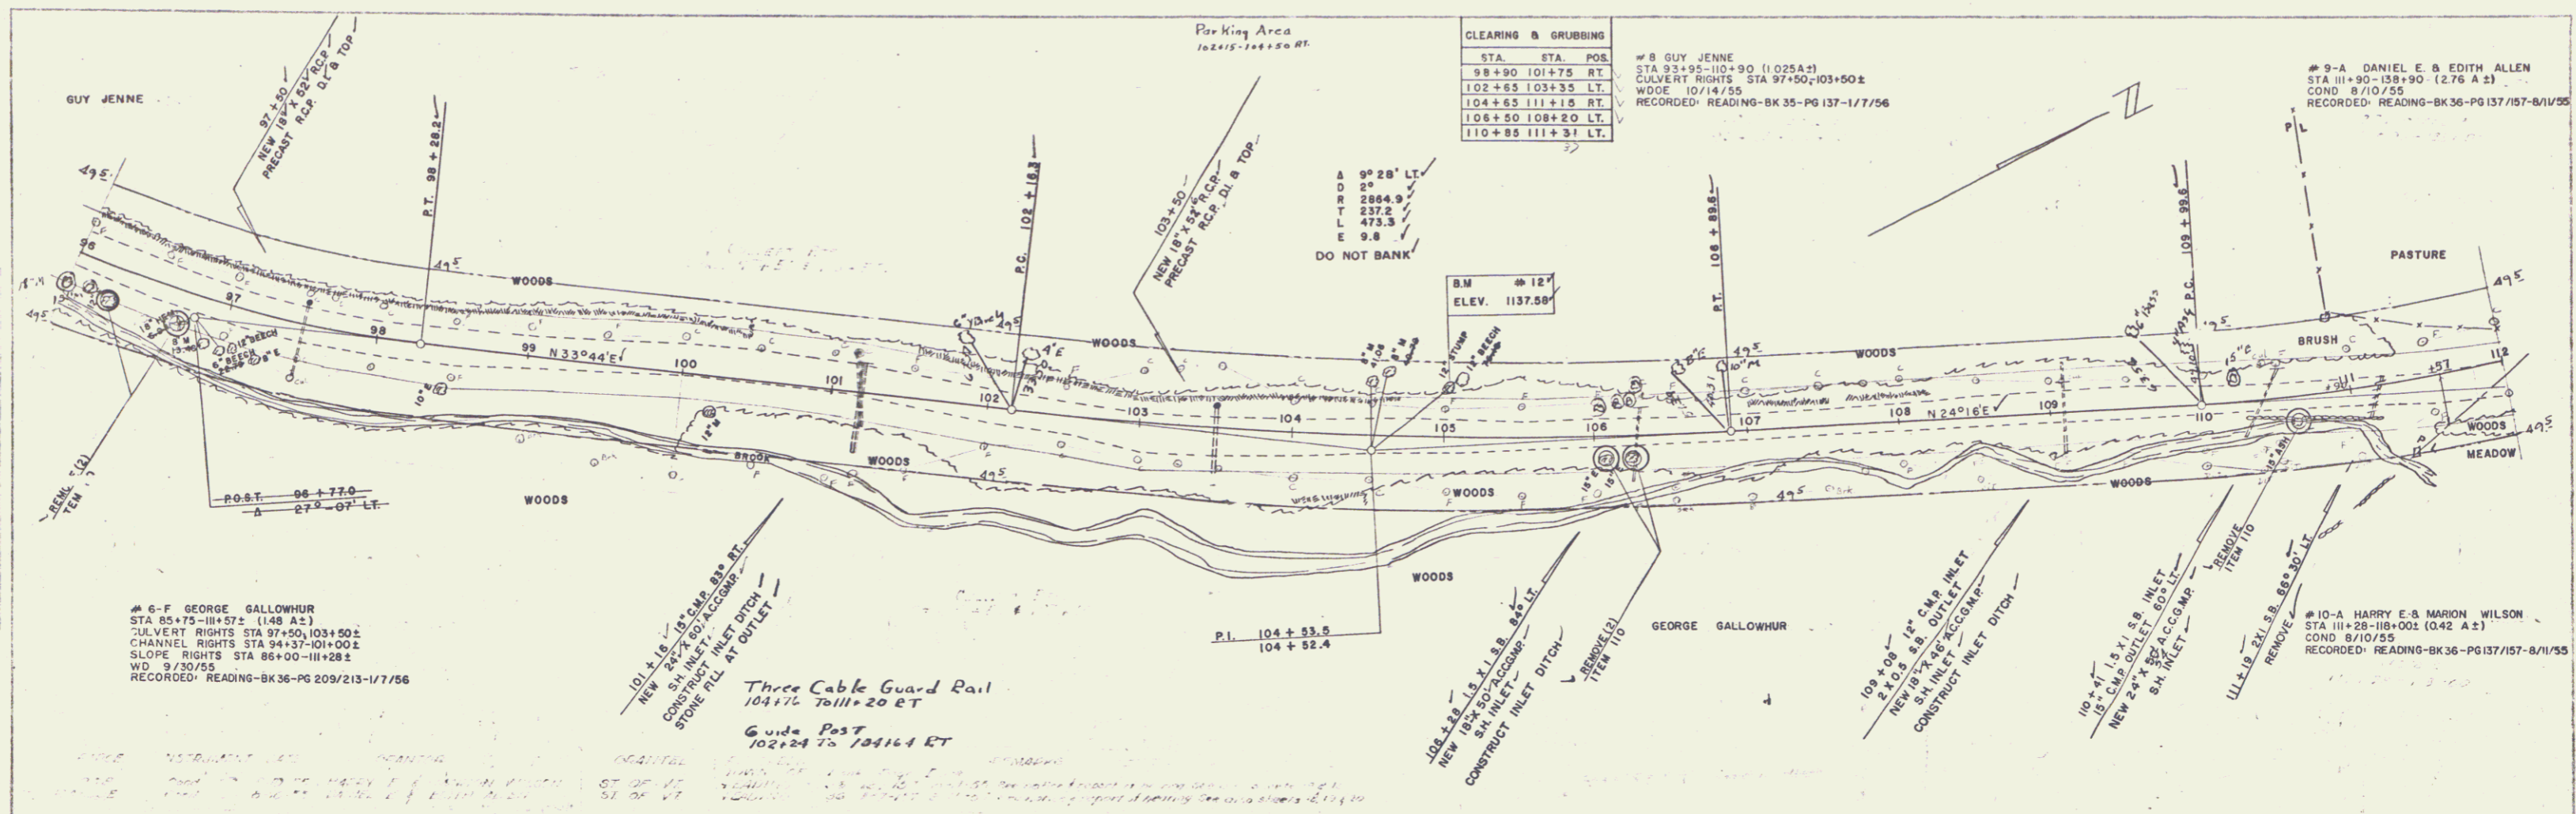

READING S 23 (3)
SHEET 17 OF 105

9