
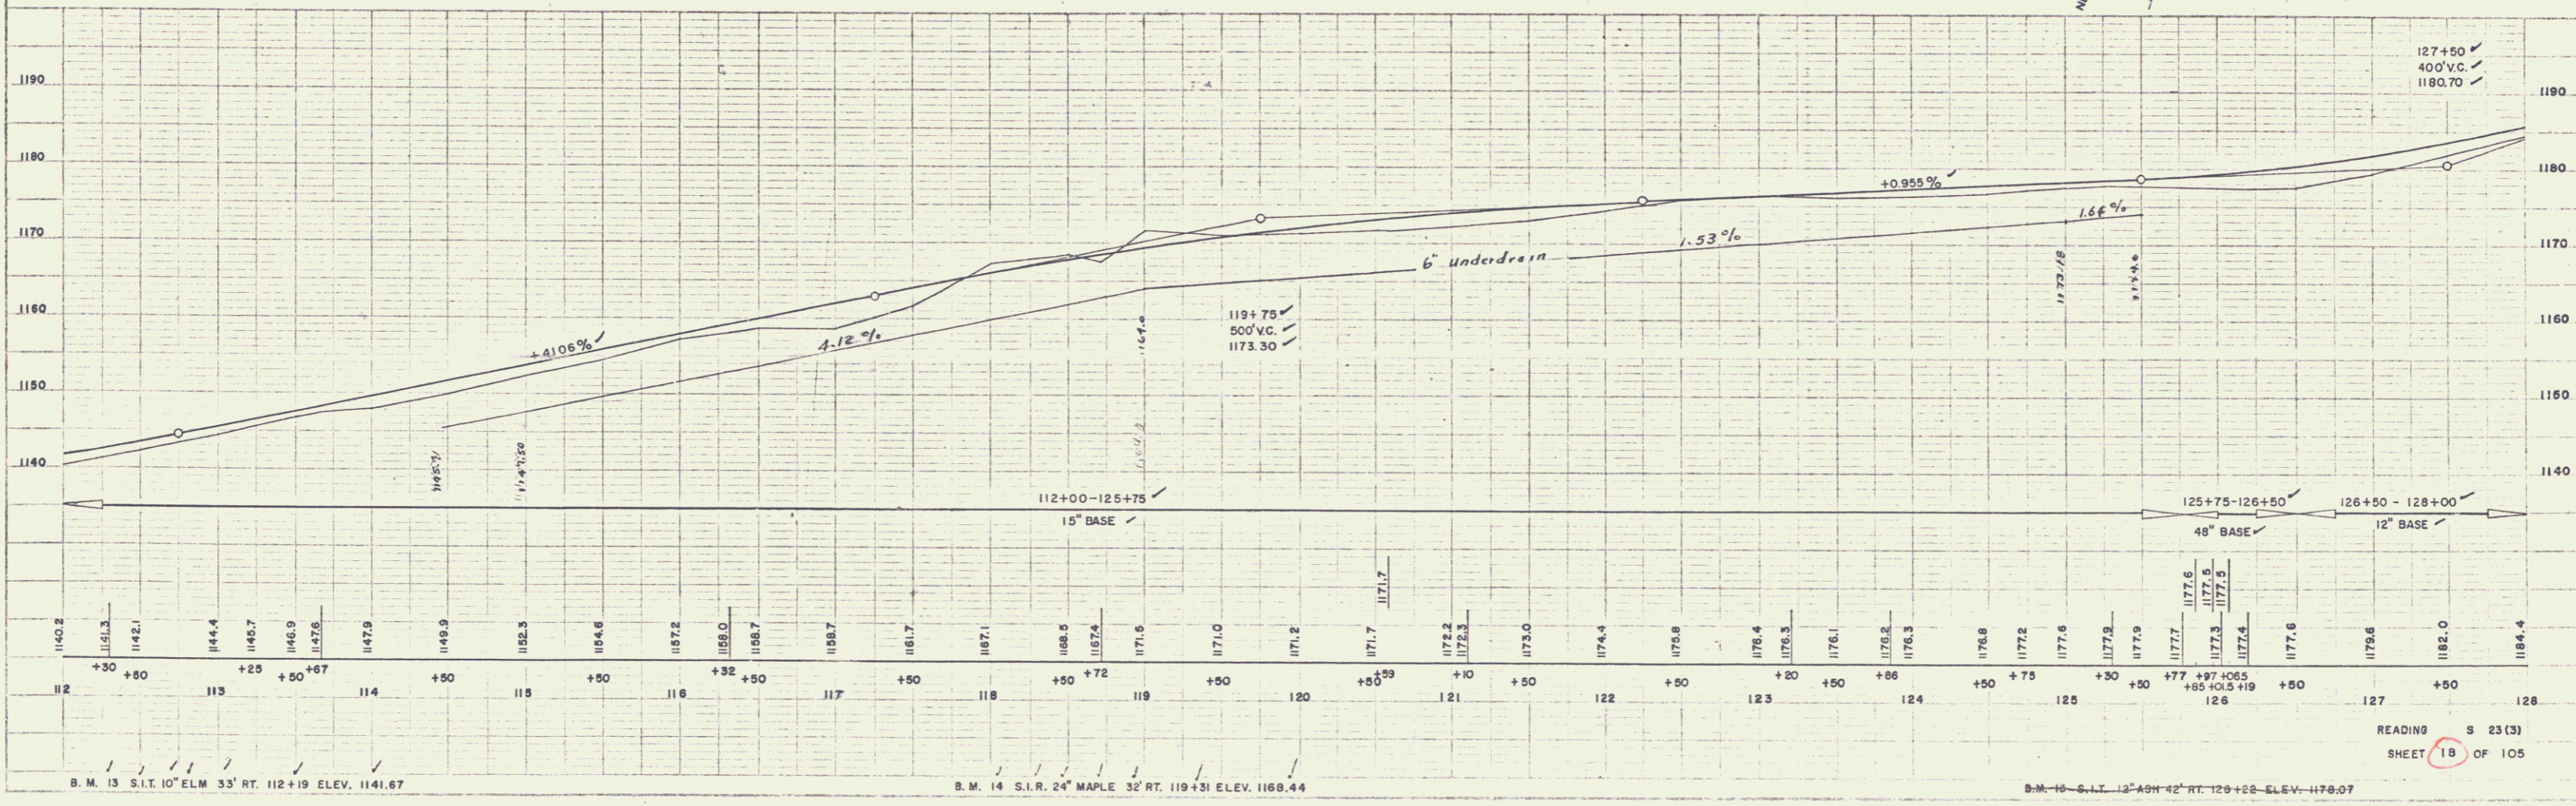


REMOVAL OF PRESENT SUPERSTRUCTURE
120+00.0 E

CONSTRUCT DRIVES	
STA.	POS.
118+72	RT.
126+19	RT.
112+30	RT.

CLEARING & GRUBBING		
STA.	STA.	POS.
113+57	113+90	LT.
121+90	123+45	LT.
123+00	124+65	RT.

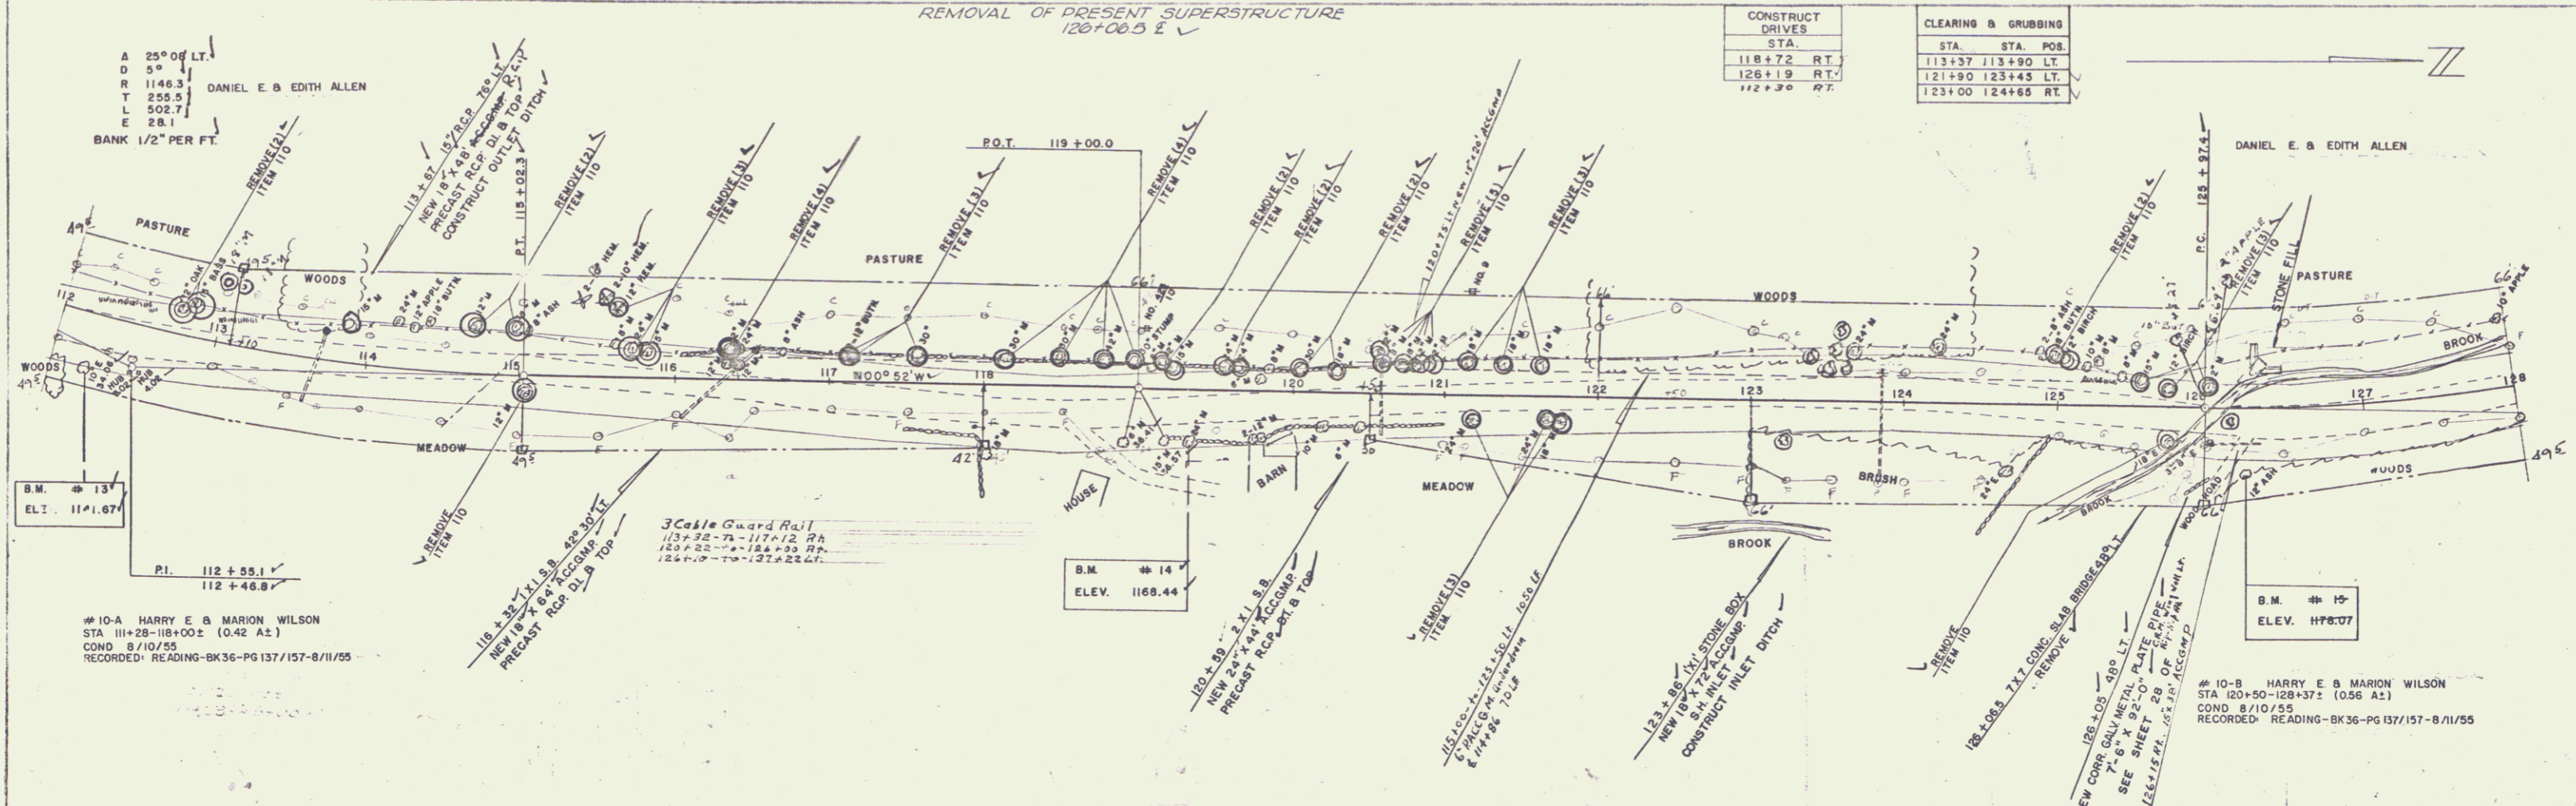

PLAN
JEWETT
WEBSTER-MARTIN INC. 11-54

PLAN
JEWETT
WEBSTER-MARTIN INC. 11-54

READING S 23(3)
SHEET 18 OF 105

10