
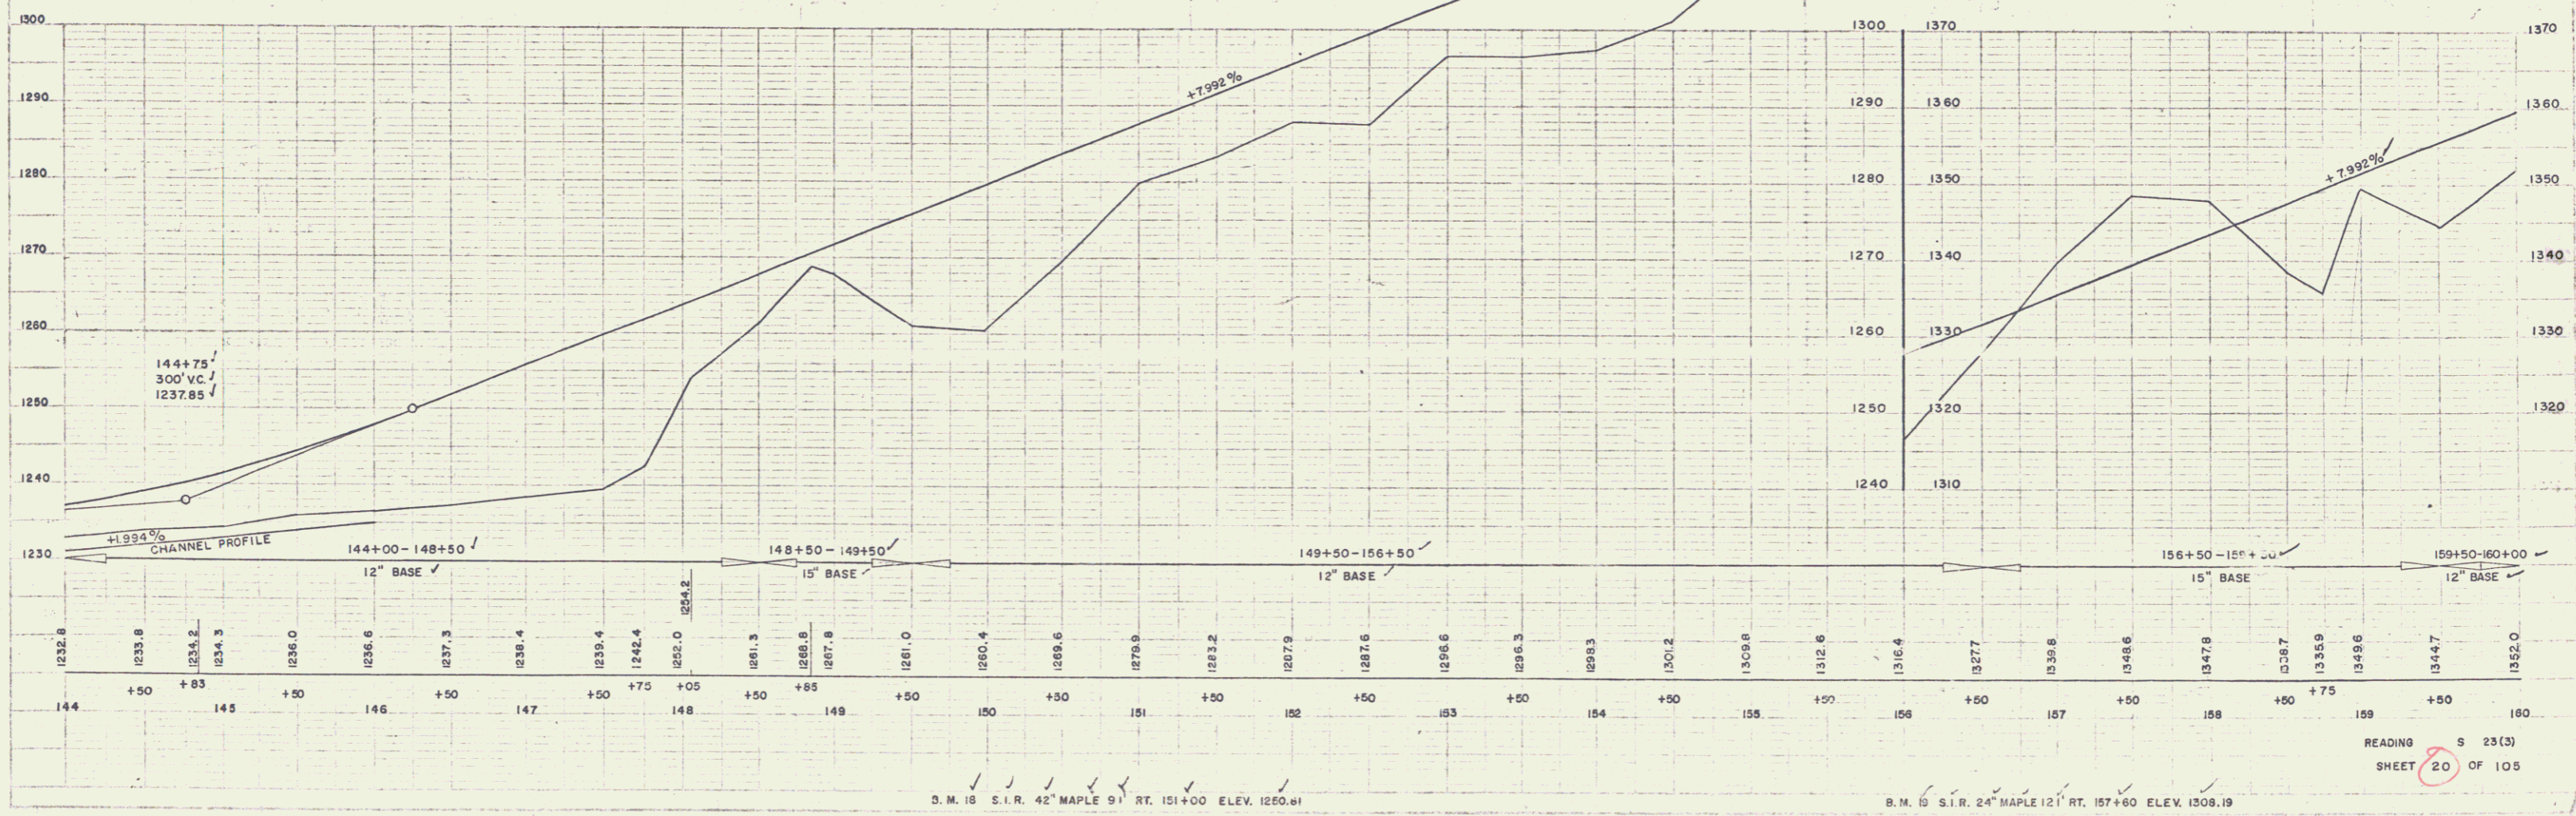


3-95  
11-54  
PALMER  
WEBSTER-MARTIN INC.

3-95  
11-54  
PALMER  
WEBSTER-MARTIN INC.

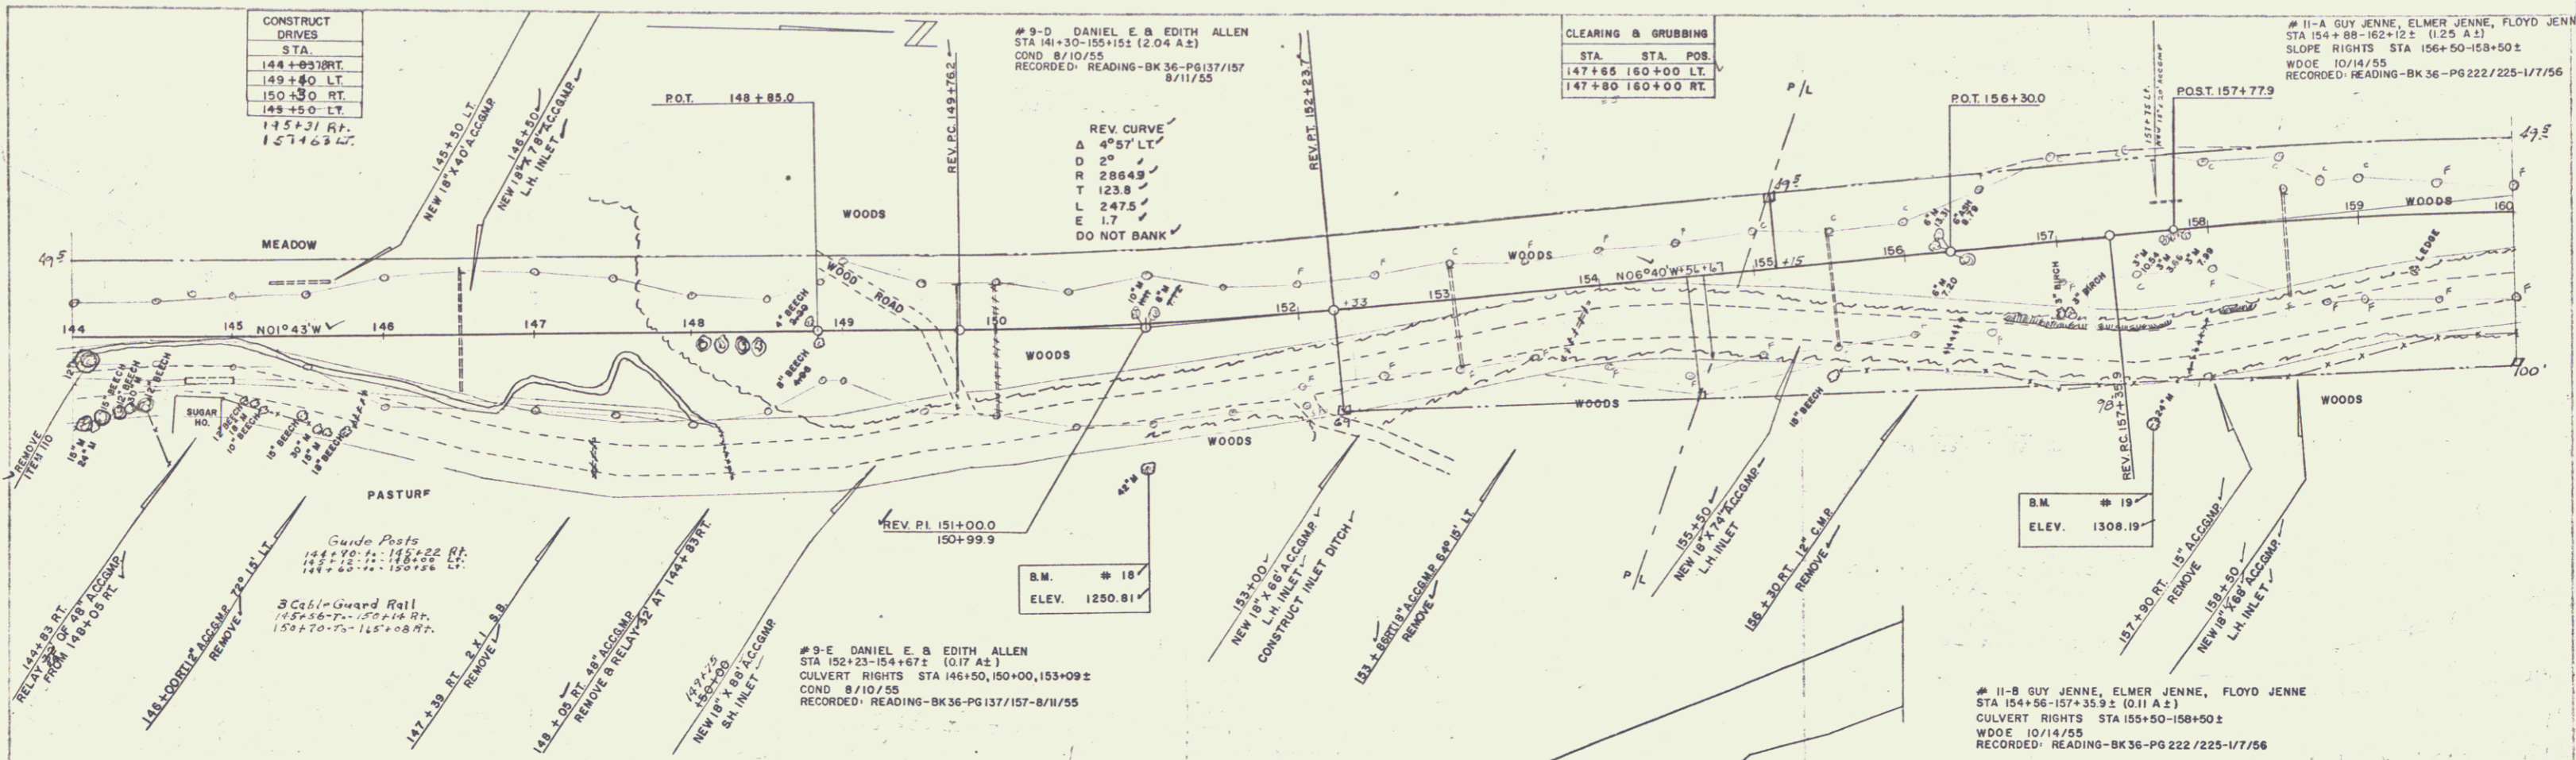

READING S 23(3)  
SHEET 20 OF 105

12