


CURVE #3  
 $\Delta$  21°53' LT.  
 D 5'  
 R 1146.3  
 T 221.6  
 L 437.7  
 E 212

10' CUM P. - Long 36 ft.  
 Di & Top Pt. (Sheet 528)

10' CUM P. - Long 36 ft.  
 Di & Top Pt. (Sheet 528)

10' CUM P. - Long 36 ft.  
 Di & Top Pt. (Sheet 528)

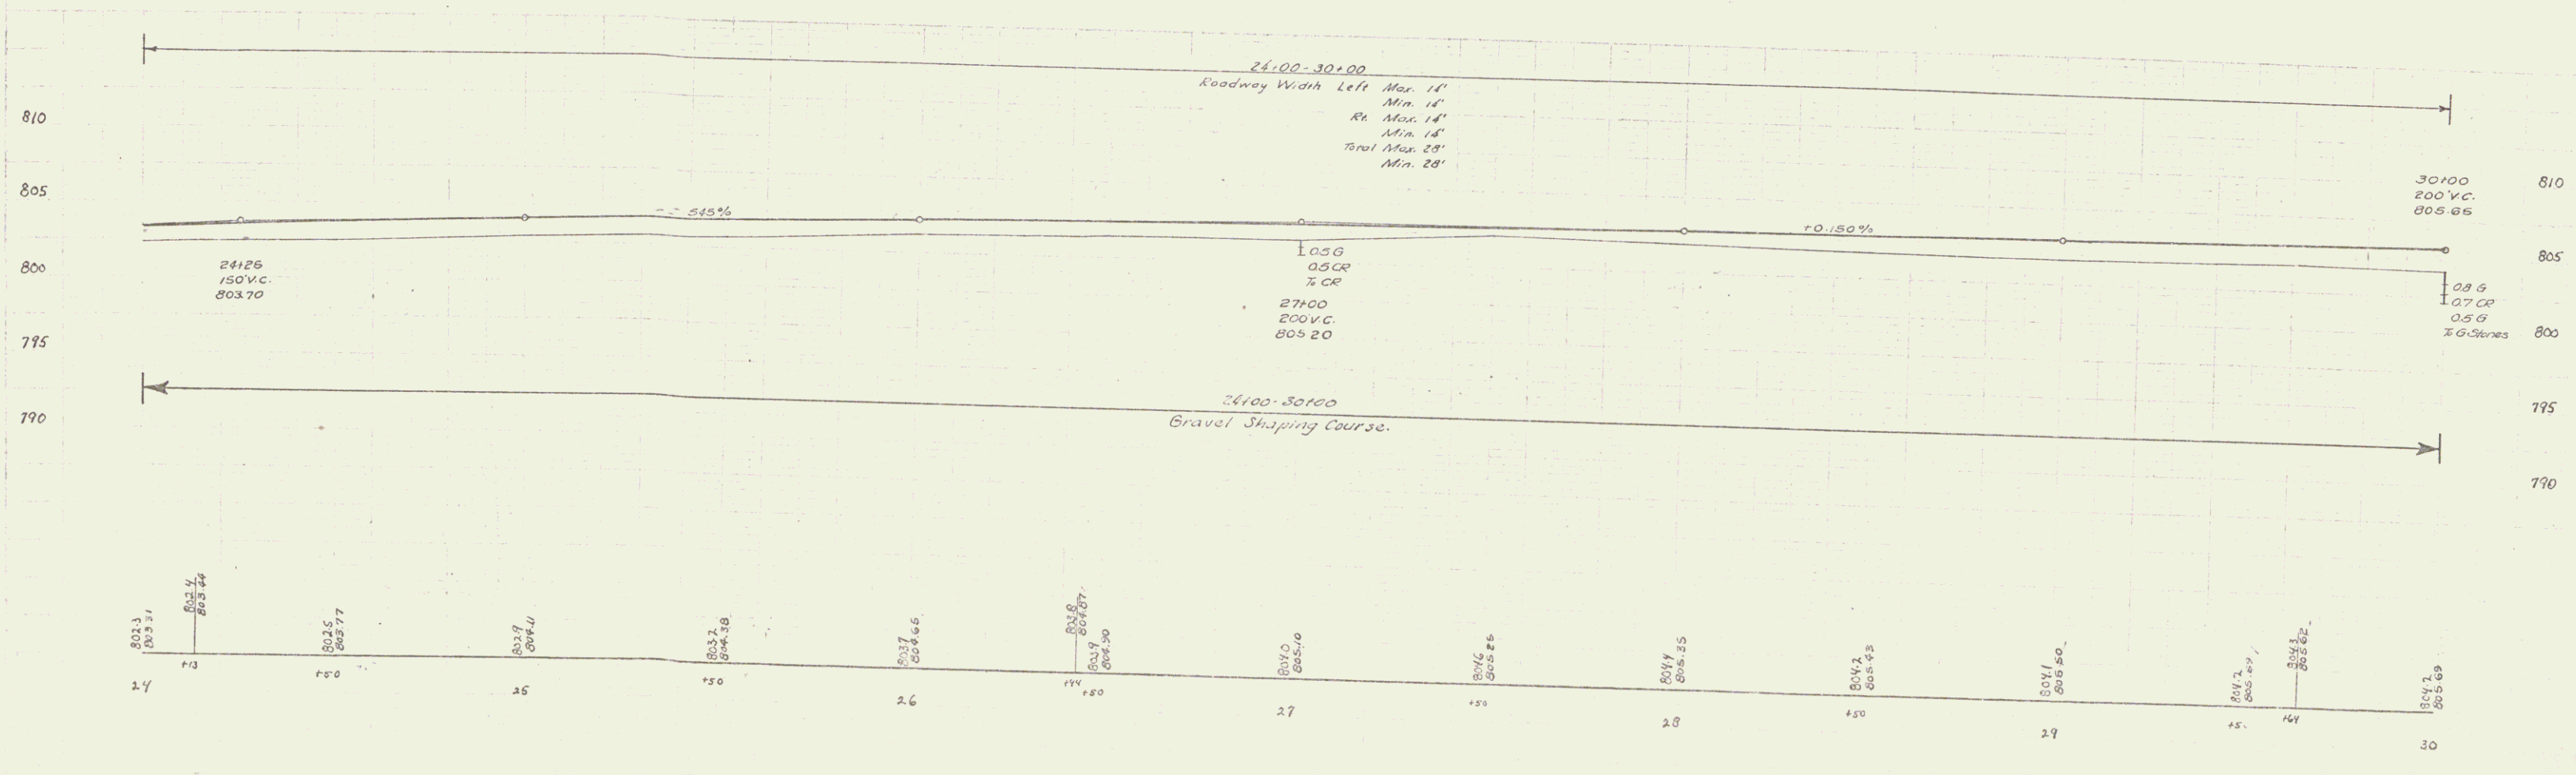

803.3  
 803.4  
 803.5  
 803.7  
 803.8  
 803.9  
 806.0