


Parcel	Kind of Instrument	Date of Instrument	Grantor	Grantee	Recorded Mapbook	Page	Date	Remarks
A	O.C.D.	11-25-35	P.C. KITTREDGE	Sr of W.	34	440	12-6-35	
B	REC'D CIVIL WD	11-23-35	W.E. MERRILL		32	373-4	11-23-35	Cum Sta 24+00

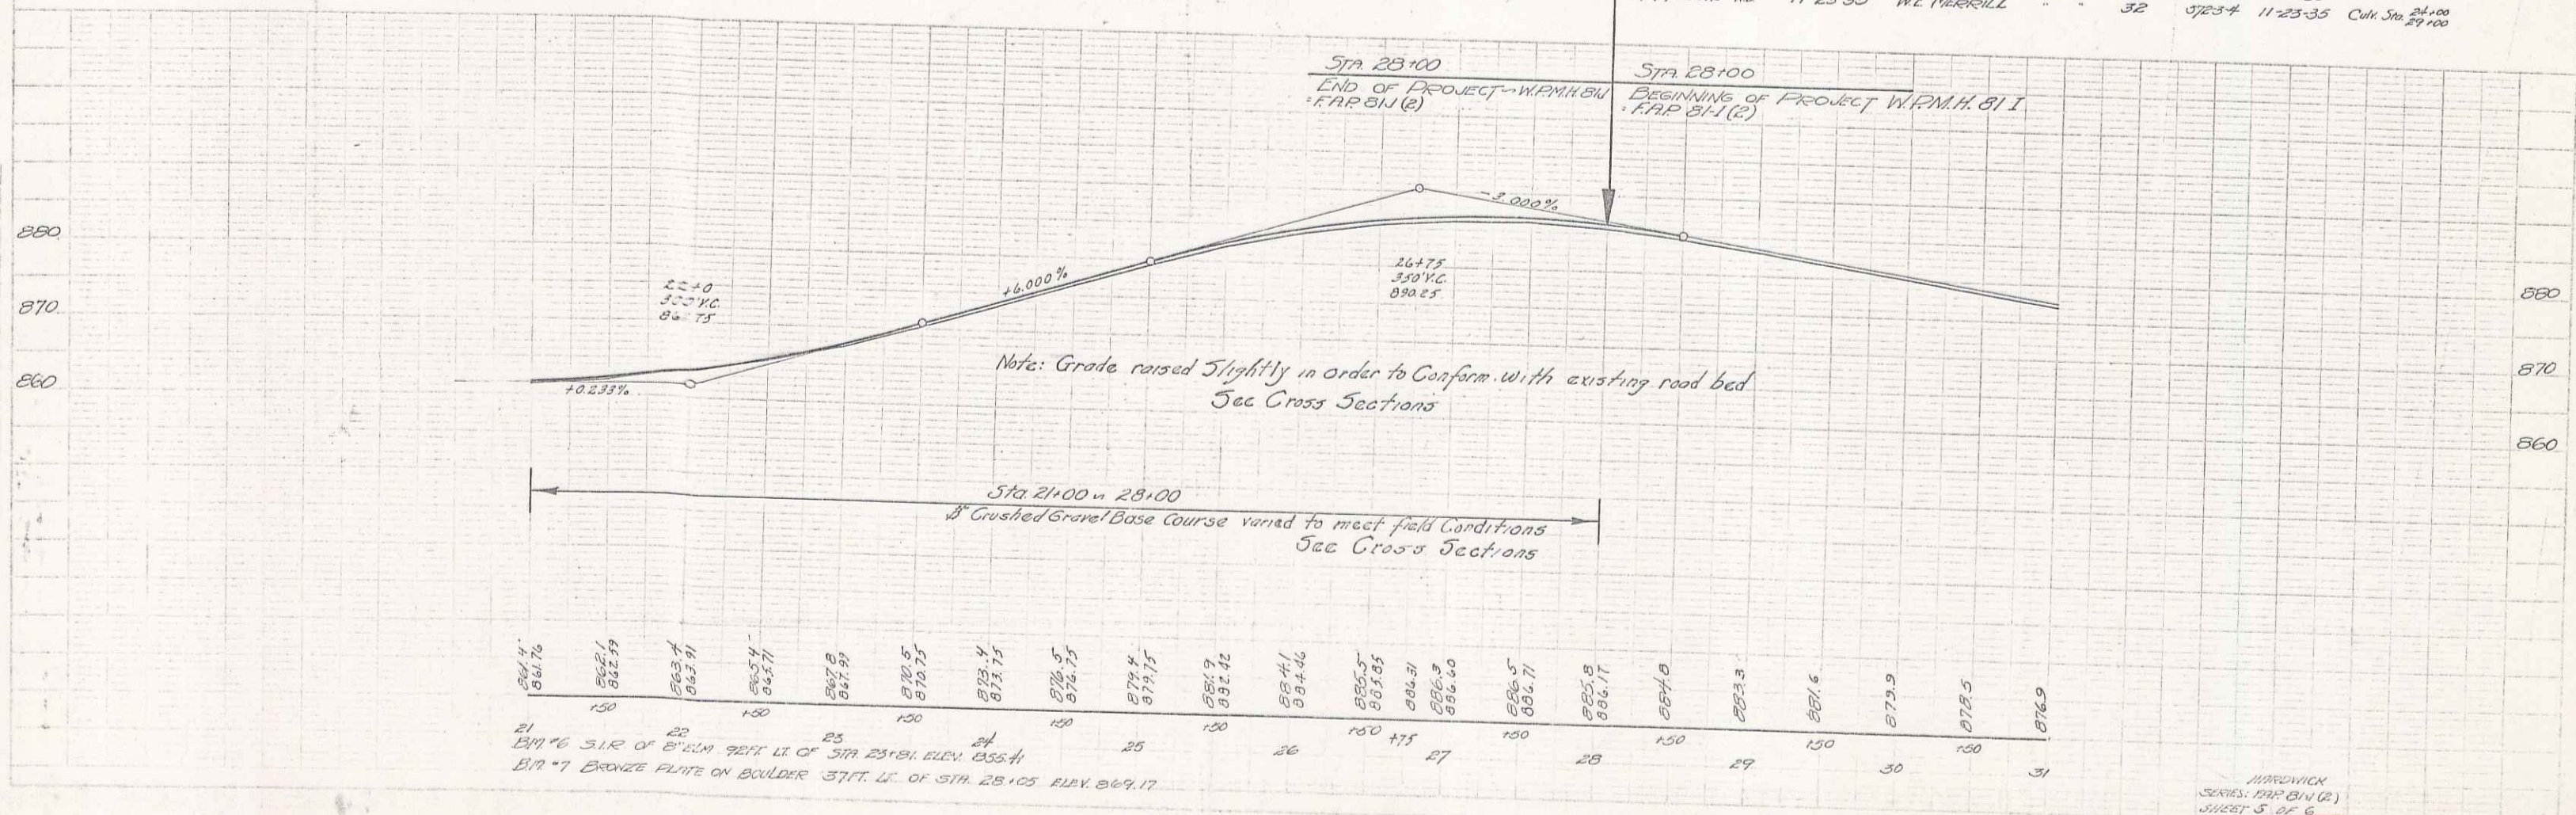

HARDWICK
 SERIES: MAP 81-1 (2)
 SHEET 5 OF 6