


If ordered by the Engineer, during construction, the entire slope shall be covered with gravel to a depth of one foot. This material to be paid for as Sub-base of Gravel (Sheet 12B).

Parcel	Kind of Deed	Date of Grant	Grantor	Grantee	Recorded Instrument	Recorded	Remarks
N	O.C.D.	11-22-35	P.C. Merrill	State of W.V.	Each Page Date	34 446	12-6-35
W.D.	W.D.	11-22-35	W.E. Merrill		32 572-3-A	11-21-35	Cub Sta. 14000

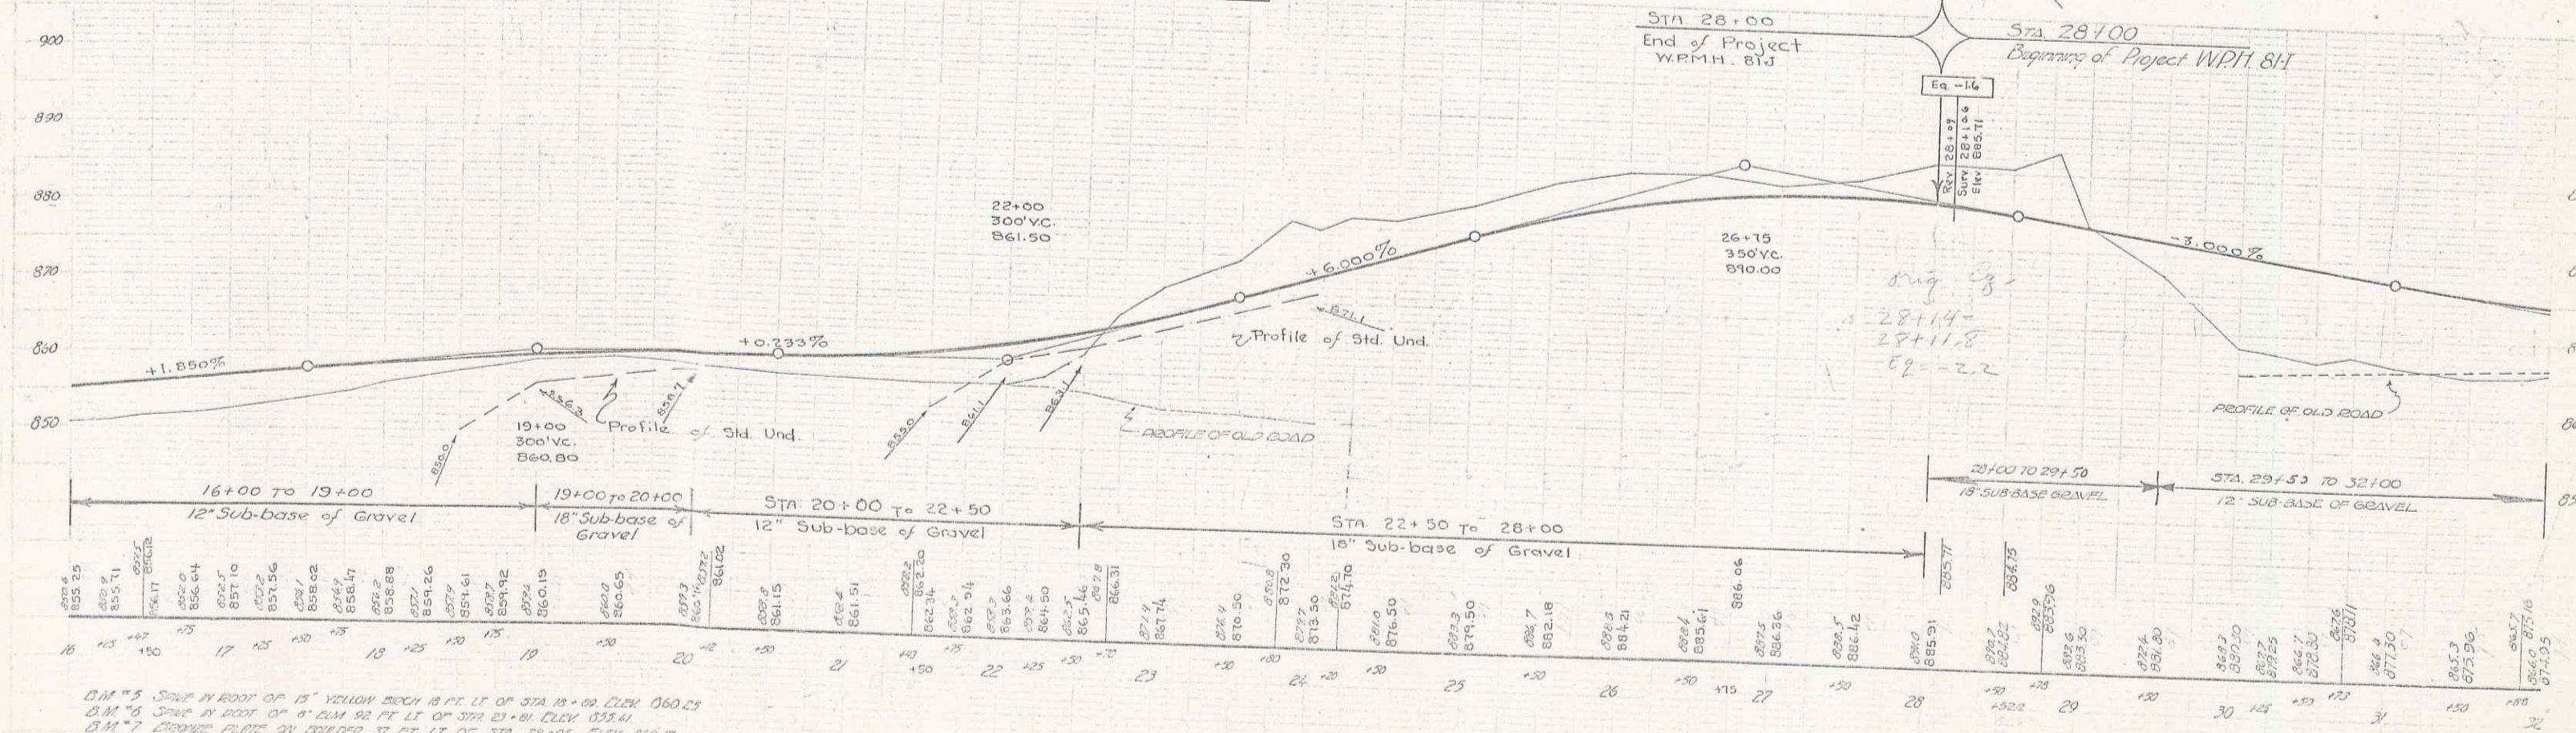

BM #5 Same as roof of 15' yellow brick 18 ft. lt. of STA 18+00. Elev. 860.25  
 BM #6 Same as roof of 4' blue 22 ft. lt. of STA 23+81. Elev. 853.41  
 BM #7 Bridge piers on double 31 ft. lt. of STA 25+05. Elev. 853.17