
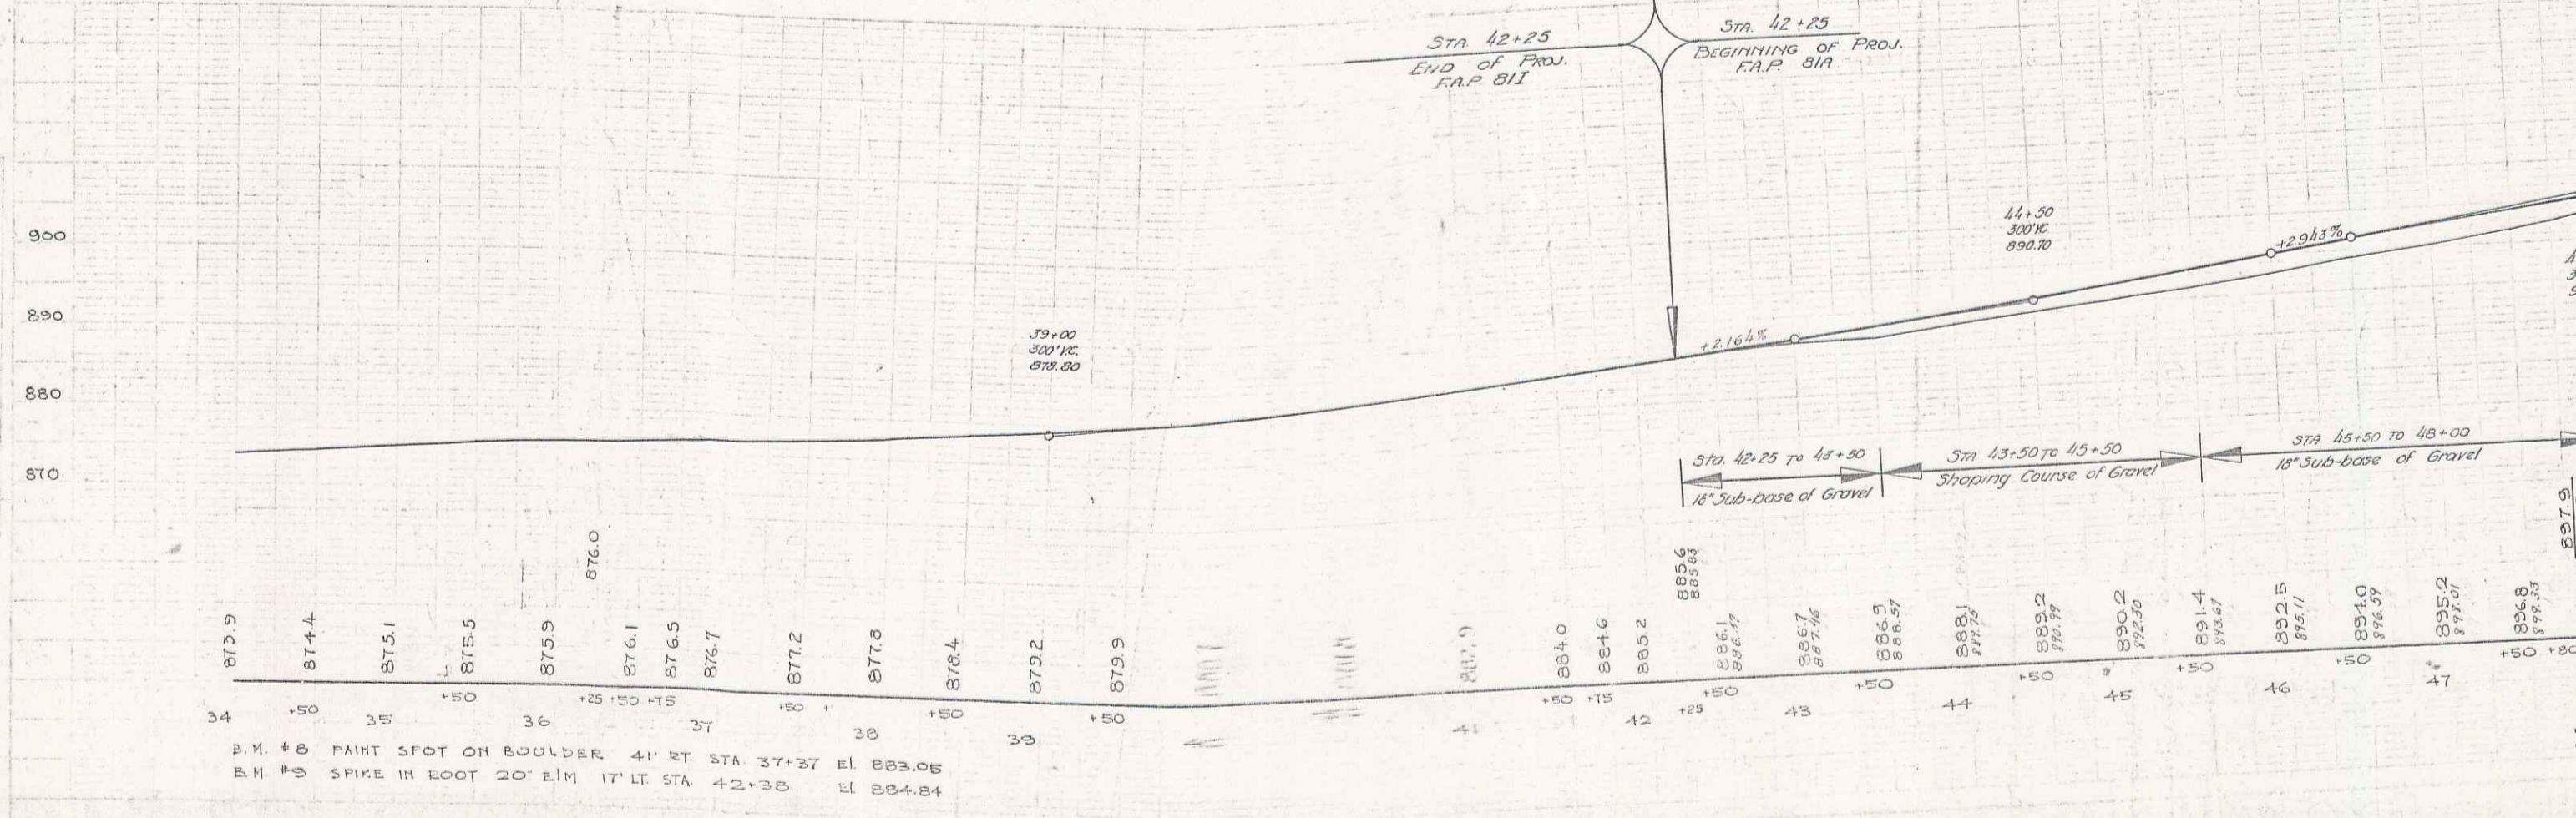


WOOD
D. MACCHI
1937
D. MACCHI

WOOD
D. MACCHI

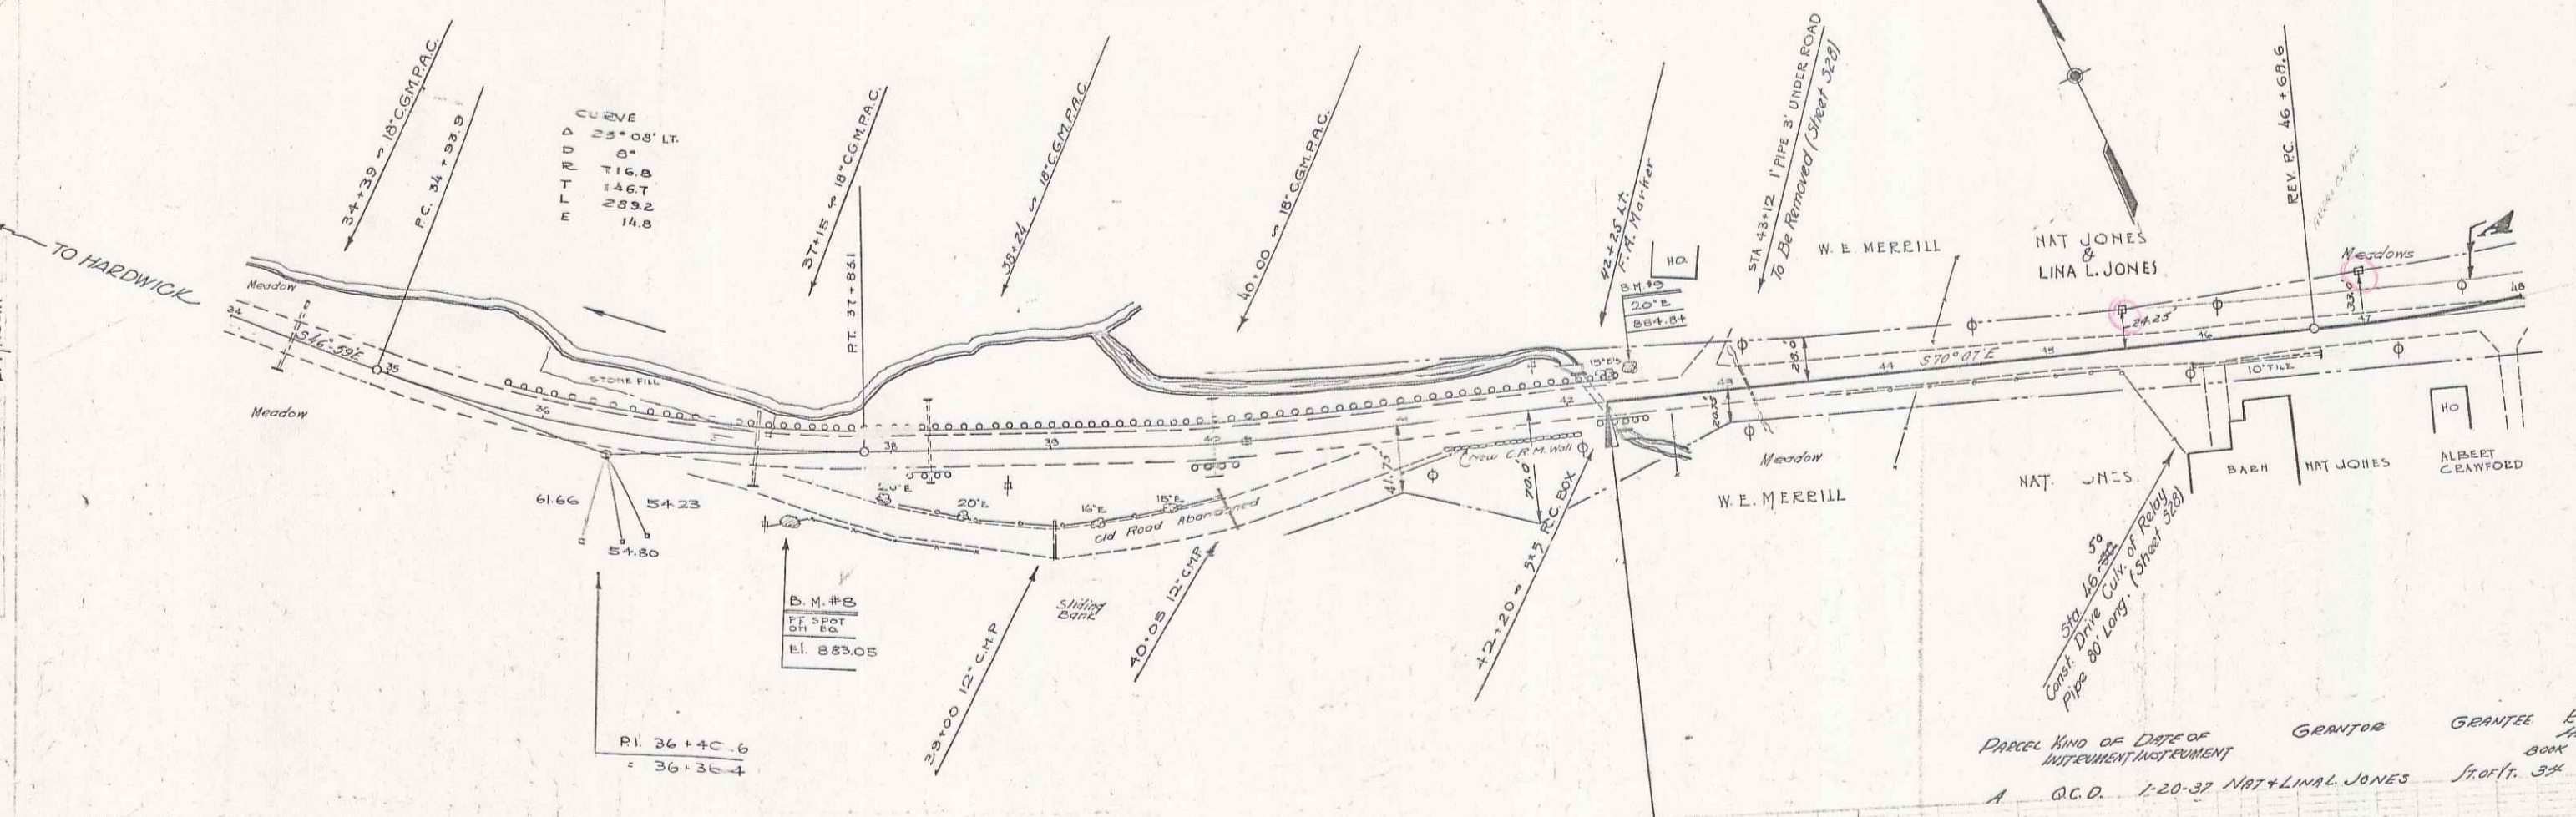

PARCEL	KIND OF IMPROVEMENT	DATE	GRANTOR	GRANTEE	RECORDED BOOK PAGE DATE	REMARKS
A	O.C.D.	1-20-37	NAT + LINA L. JONES	FRONT 34' 460'	1-23-37	

B.M. #6 PAINT SPOT ON BOULDER 41' RT. STA 37+37 EL 883.05
 B.M. #3 SPIKE IN ROOT 20' LIM 17' LT STA 42+38 EL 884.84