



WOODRUFF  
D. MACCHI

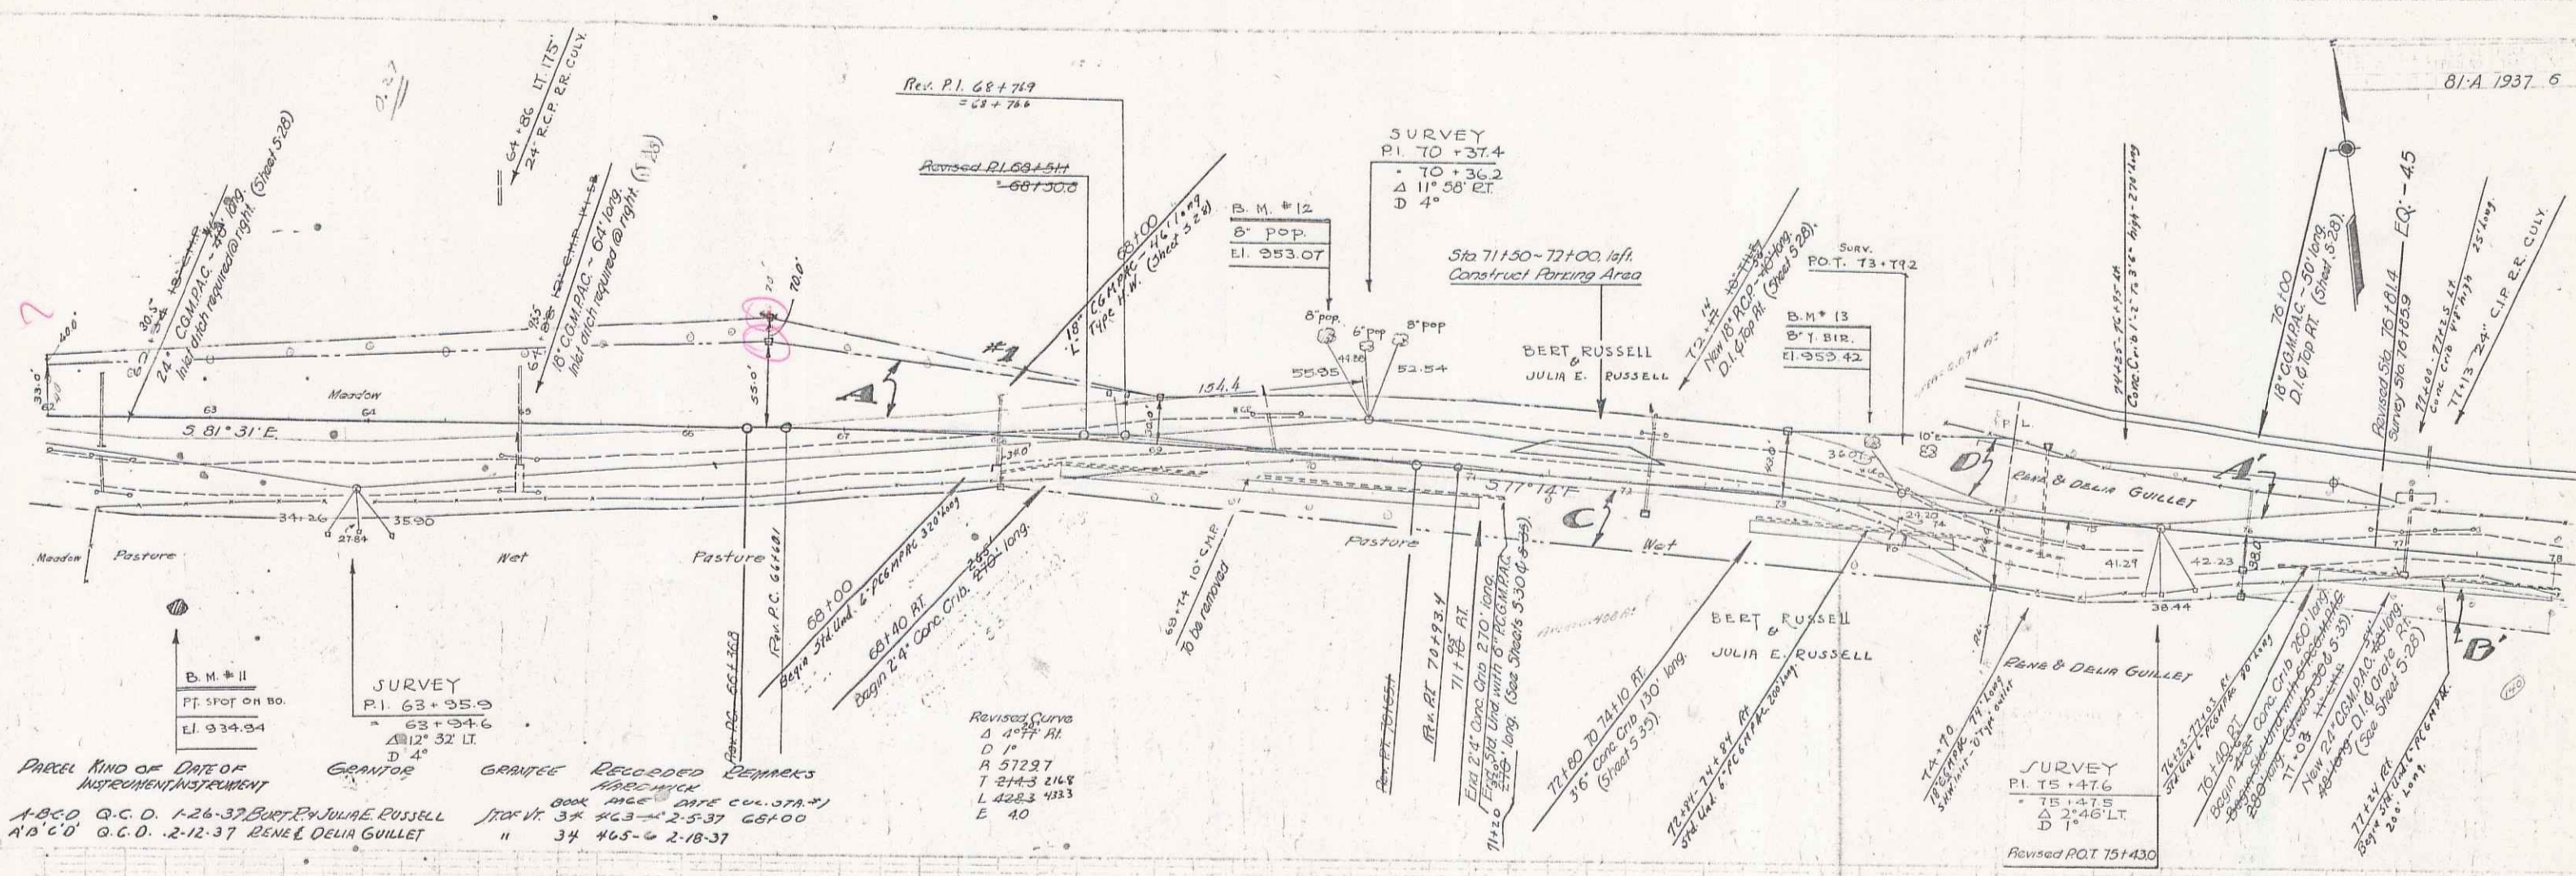

| Parcel  | Kind of Instrument | Date of Instrument | Grantor                 | Grantee | Recorded | Remarks             |
|---------|--------------------|--------------------|-------------------------|---------|----------|---------------------|
| A-B-C-D | O.C.D.             | 1-28-37            | BERT & JULIA E. RUSSELL | ST. W.  | 32       | 463-4 2-5-37 681.00 |
| A-D-C-D | O.C.D.             | 2-12-37            | BERT & DELIA GUILLET    | "       | 34       | 465-6 2-18-37       |

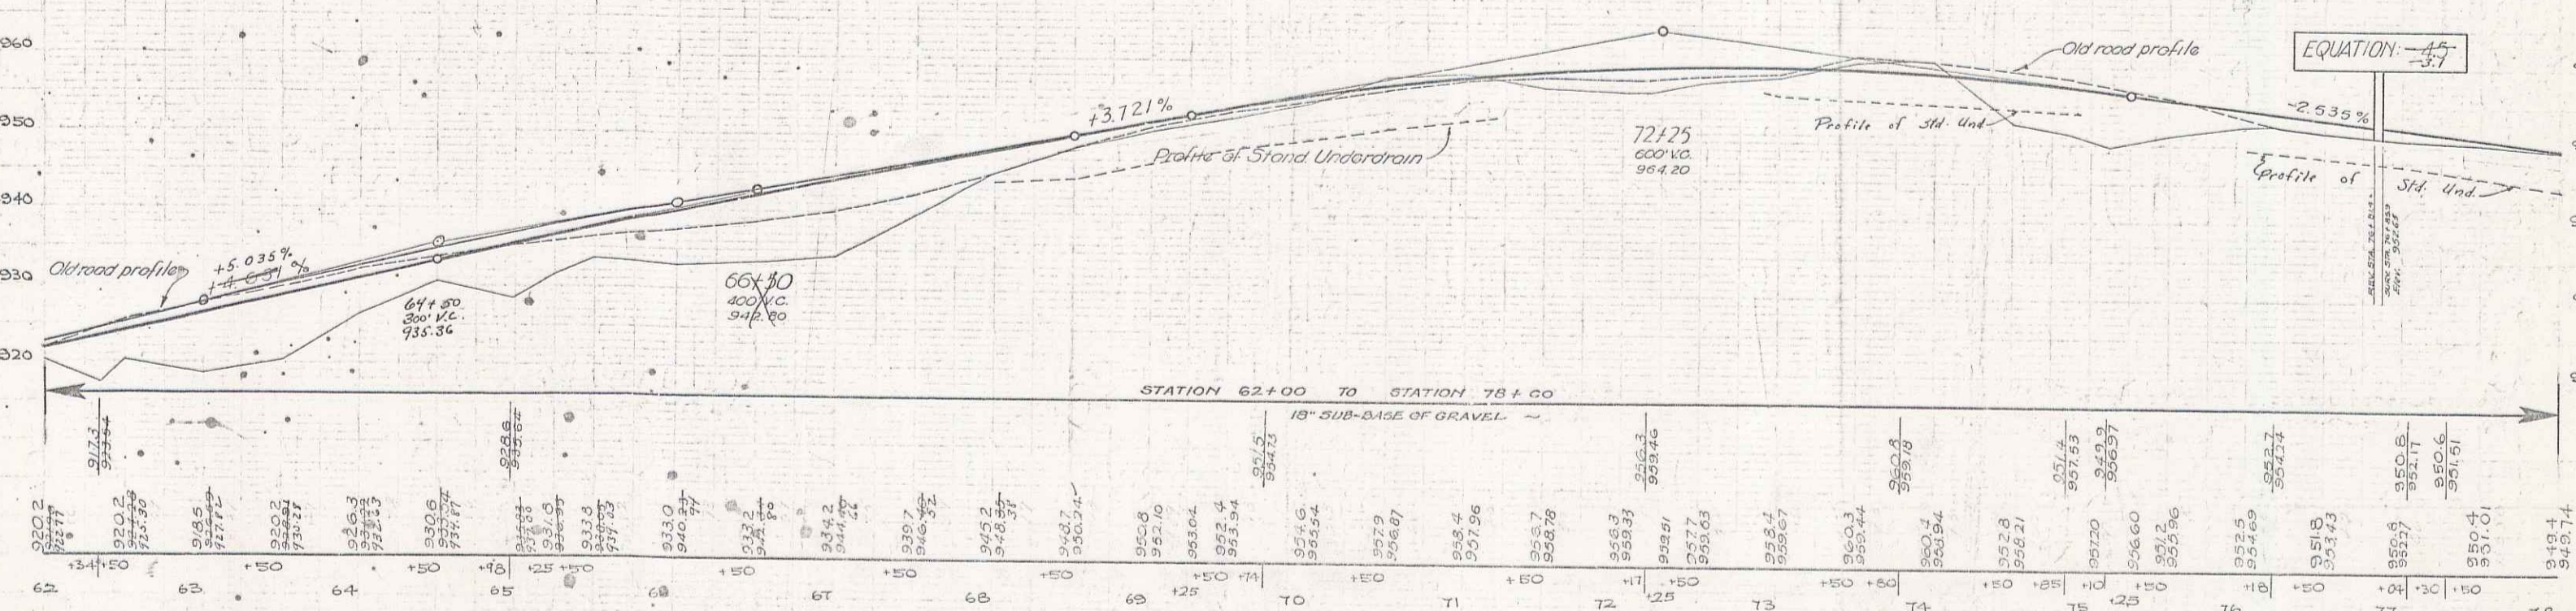

| B.M. #   | Point | Spot on            | Dist. ft. | Sta.       | Elev.        |
|----------|-------|--------------------|-----------|------------|--------------|
| B.M. #11 | Point | Spot on Boulder    | 90 ft.    | Sta. 62+00 | Elev. 934.94 |
| B.M. #12 | Spire | in trunk of Poplar | 57 ft.    | Sta. 70+00 | Elev. 953.07 |
| B.M. #13 | Point | Spot on Birch      | 26 ft.    | Sta. 73+54 | Elev. 955.42 |
| B.M. #14 | Point | Spot on Boulder    | ft.       | Sta.       |              |

Series F.A.P. No. 81-A  
Sheet 6 of 58 Sheets.

4