
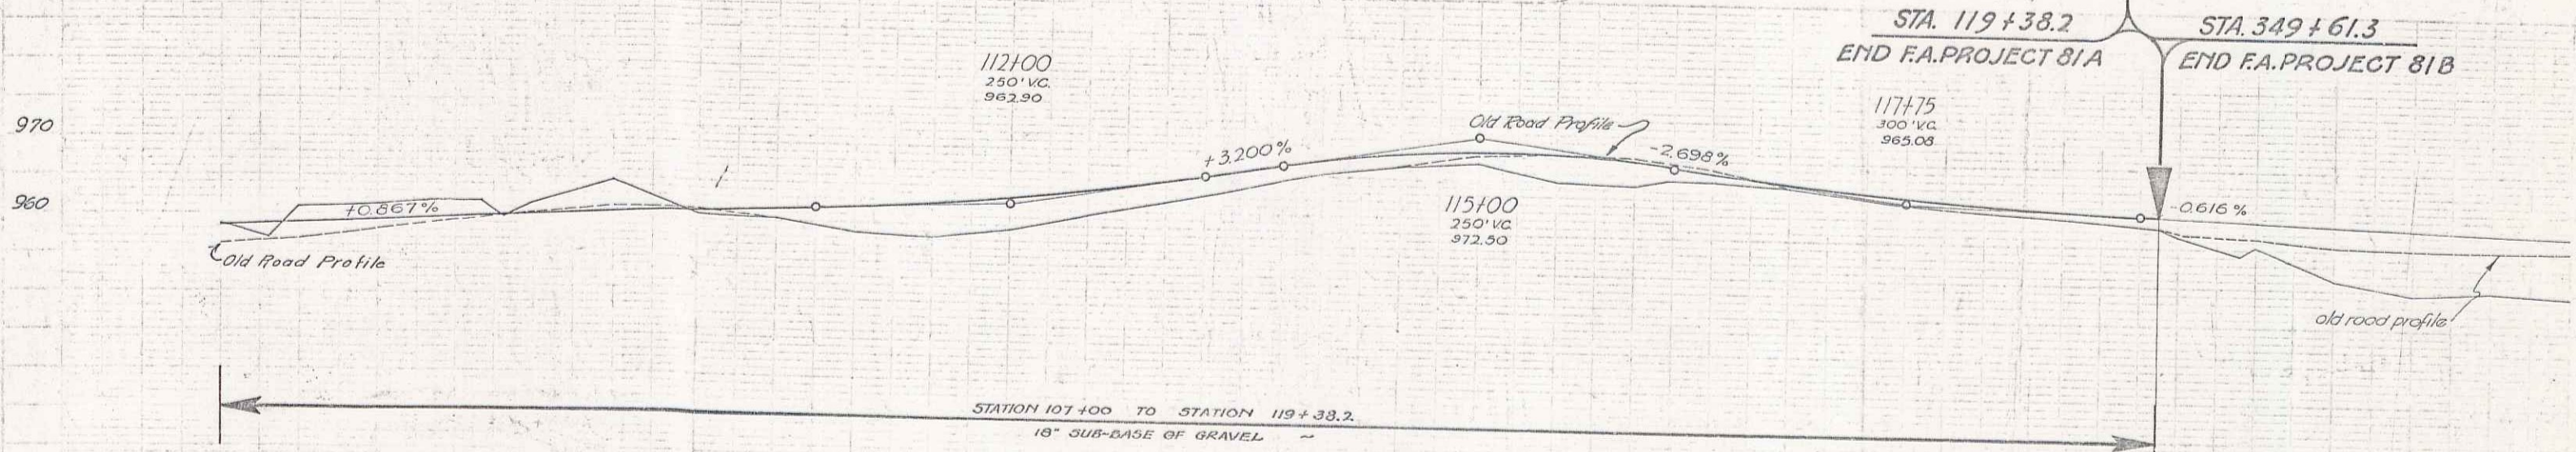


DATE	KIND OF CASE OR INSTRUMENT	GENITOR	GENESSE	RECORDED	REMARKS
A	Q.C.D. 2-12-37	GEO. L. DIANA MENARD	STAY	34	1965 DATE
A'	Q.C.D. 5-26-38	RENE & DELIA GUILLET	"	41	19 2-18-37
A''	Q.C.D. 6-9-38	GEO. L. & DIANA MENARD	"	41	19 6-3-38
				21	6-7-38

STATE OF MISSISSIPPI  
 81-A 1937 9 58

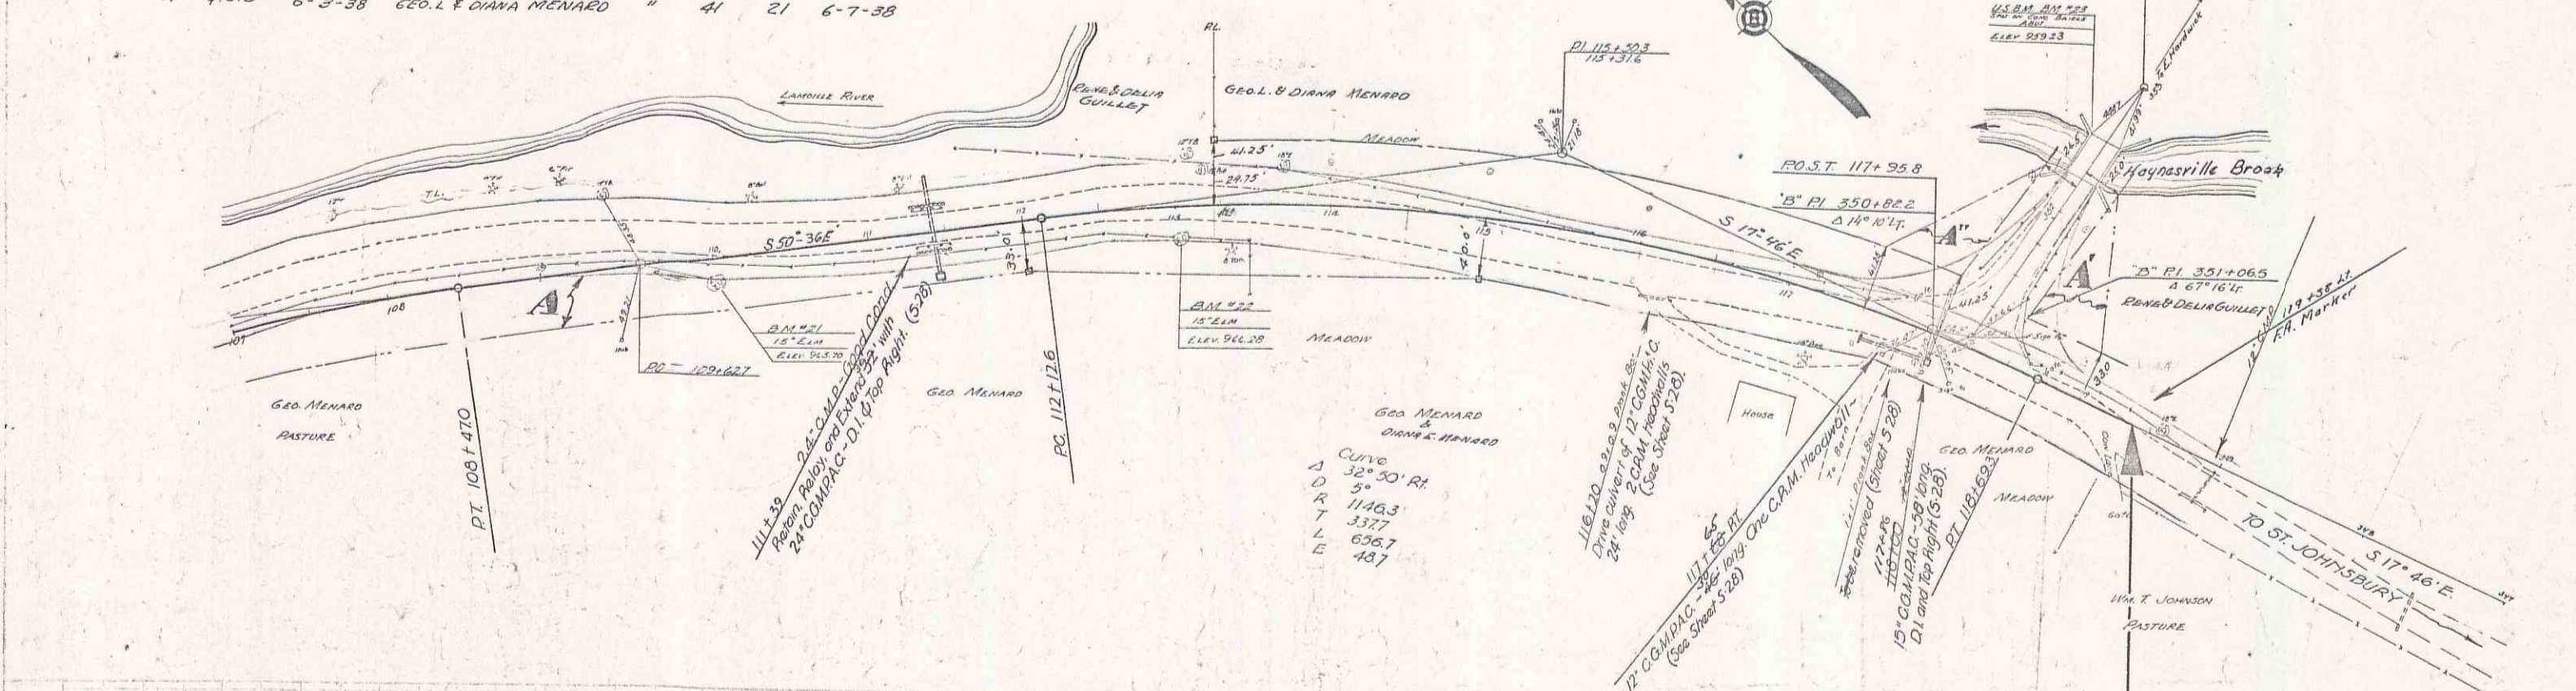

STATION 107+00 TO STATION 119+38.2  
 18" SUB-BASE OF GRAVEL

STATION	ELEVATION
107	959.57
108	956.40
109	955.74
110	956.07
111	956.17
112	956.60
113	956.82
114	956.07
115	956.84
116	956.75
117	956.53
118	956.76
119	956.13
120	956.90
121	956.76
122	956.53
123	956.70
124	956.53
125	956.70
200	956.53

SERIES E.A.P. NO. 81-A  
 SHEETS 1-10

7