


Notes: The existing sub-base of gravel is not to be disturbed except as otherwise noted or as directed by the Engineer. The Crushed Gravel Base Course is to be paid for by shaping course measurement. (See special provisions)

PARCEL	KIND OF DATE OR INSTRUMENT	GRANTOR	GRANTEE	RECORDED HARDWICK BOOK PAGE DATE	REMARKS
A	R.C.D.	1-20-37	Nat & Lina L. Jones	Sr of Vr	34 460 1-23-37

Sta 42+25  
 END OF PROJ. I.P.P. 811(2)

Sta 42+25  
 BEGINNING OF PROJ. I.P.P. 811(2)

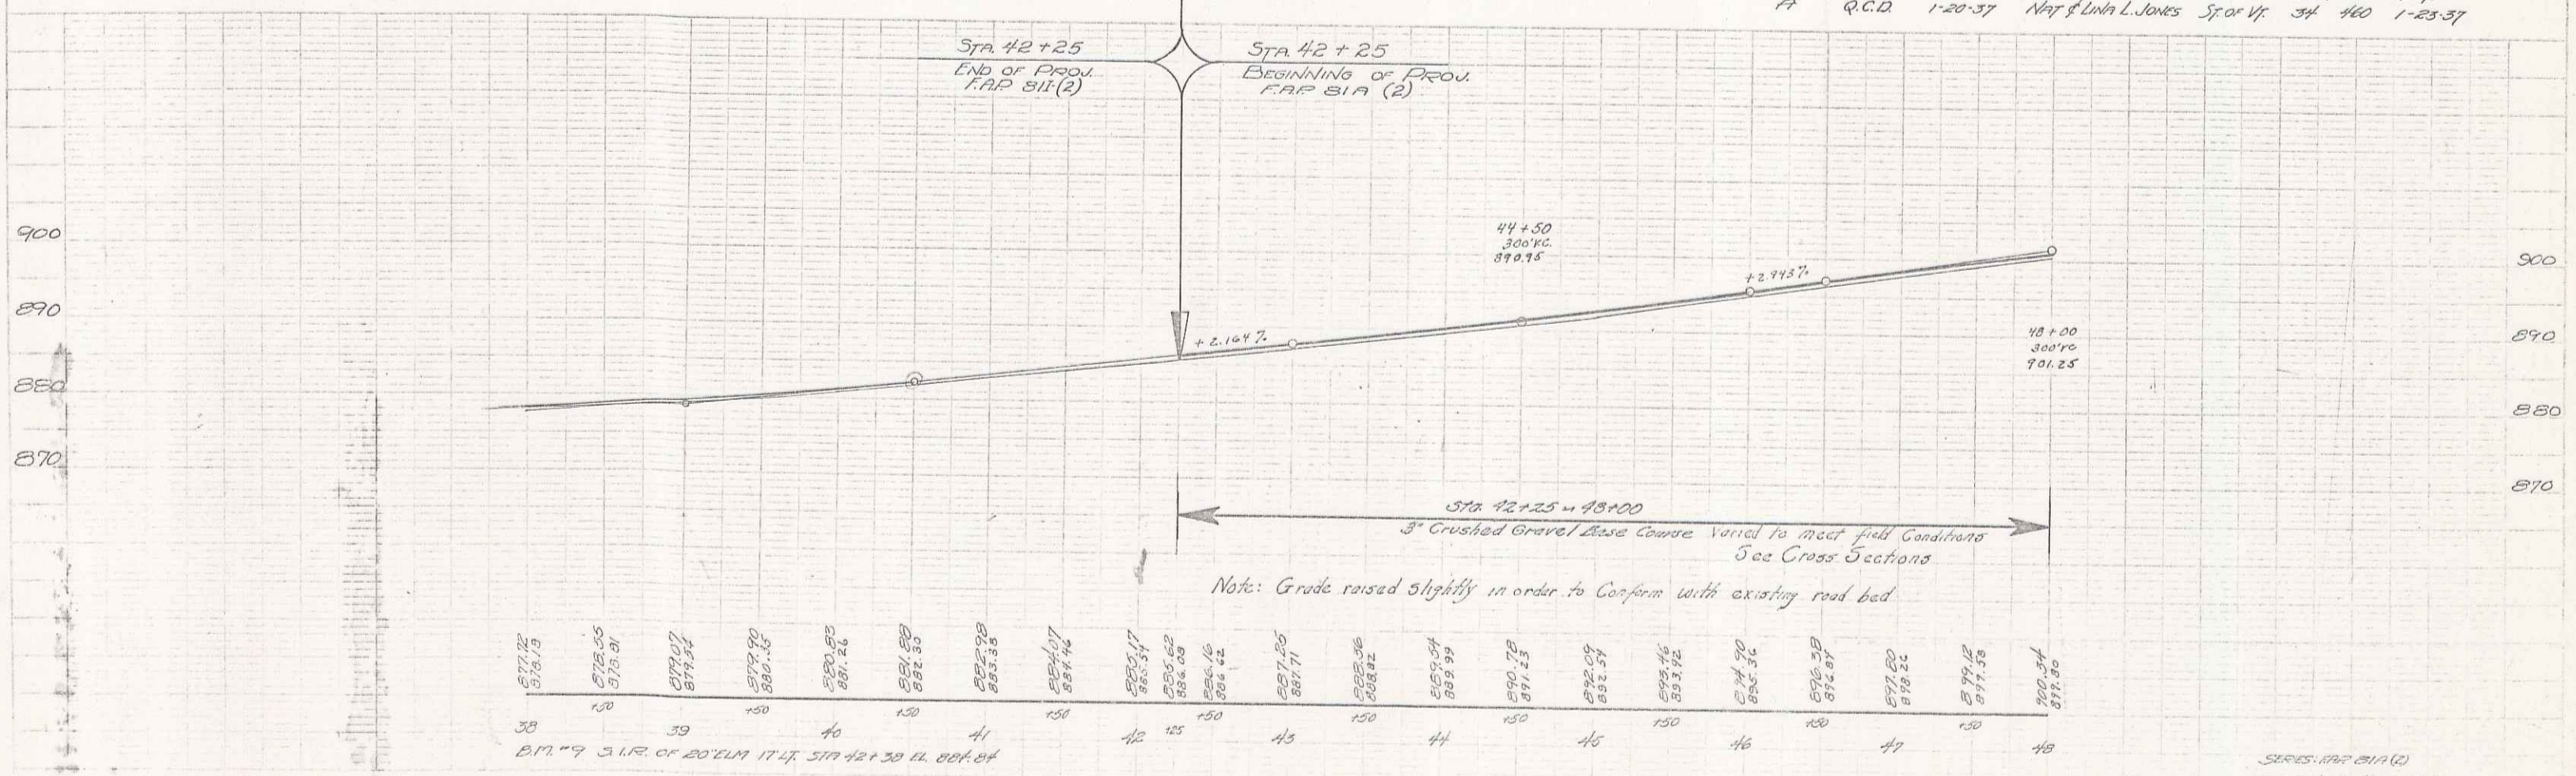

38	877.02	878.13	39	877.90	880.10	40	880.85	881.26	41	881.88	882.30	42	884.07	884.46	43	885.17	885.51	44	887.09	887.54	45	889.46	889.99	46	891.78	891.23	47	892.09	892.54	48	893.46	893.92
	877.02	878.13		877.90	880.10		880.85	881.26		881.88	882.30		884.07	884.46		885.17	885.51		887.09	887.54		889.46	889.99		891.78	891.23		892.09	892.54		893.46	893.92