


PARCEL	KIND OF INSTRUMENT	DATE OF INSTRUMENT	GRANTOR	GRANTEE	RECORDED DATE	REMARKS
A	Q.C.D.	1-20-37	NAT & LINA L. JONES	SF. OF VT. 34	462-4	7-25-37
A B C D	Q.C.D.	1-26-37	BERT R. & JULIA E. RUSSELL	...	463-4	2-5-37
1	Q.C.R.	5-26-38	NAT & LINA L. JONES	...	57-100	6-3-38

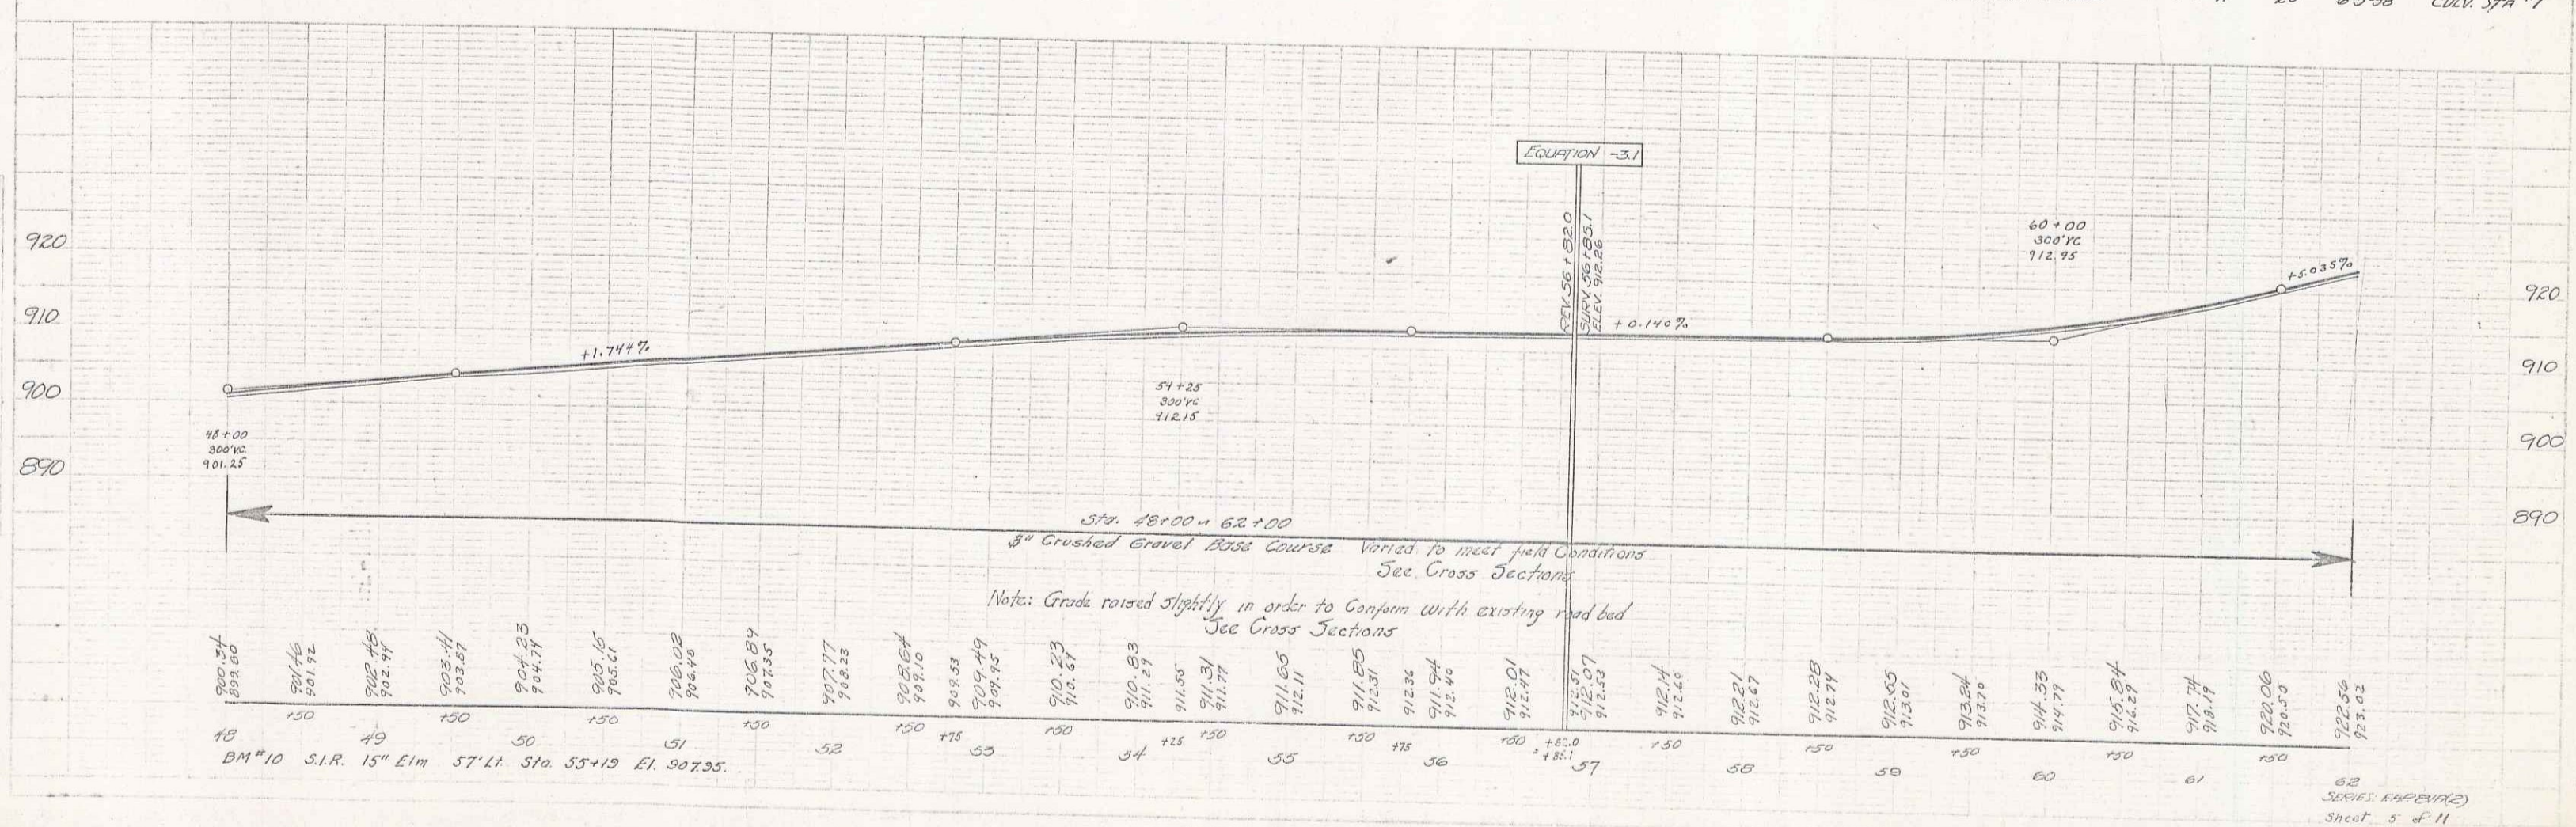

Note: Grade raised slightly in order to conform with existing road bed
See Cross Sections