



Parcel, Kind of Improvement	Date of Survey	Grantor	Grantee	Recorder	Hardwick	Book	Page	Date	Remarks
A	G.C.D.	2-12-37	Geo. L. Diana Menard	St. John	41	167-08	218-37		
A'	G.C.D.	5-26-38	René & Delia Gullet	"	41	19	5-5-38		
A''	G.C.D.	6-3-38	Geo. L. & Diana Menard	"	41	21	6-7-38		

81AW 1940 9 11

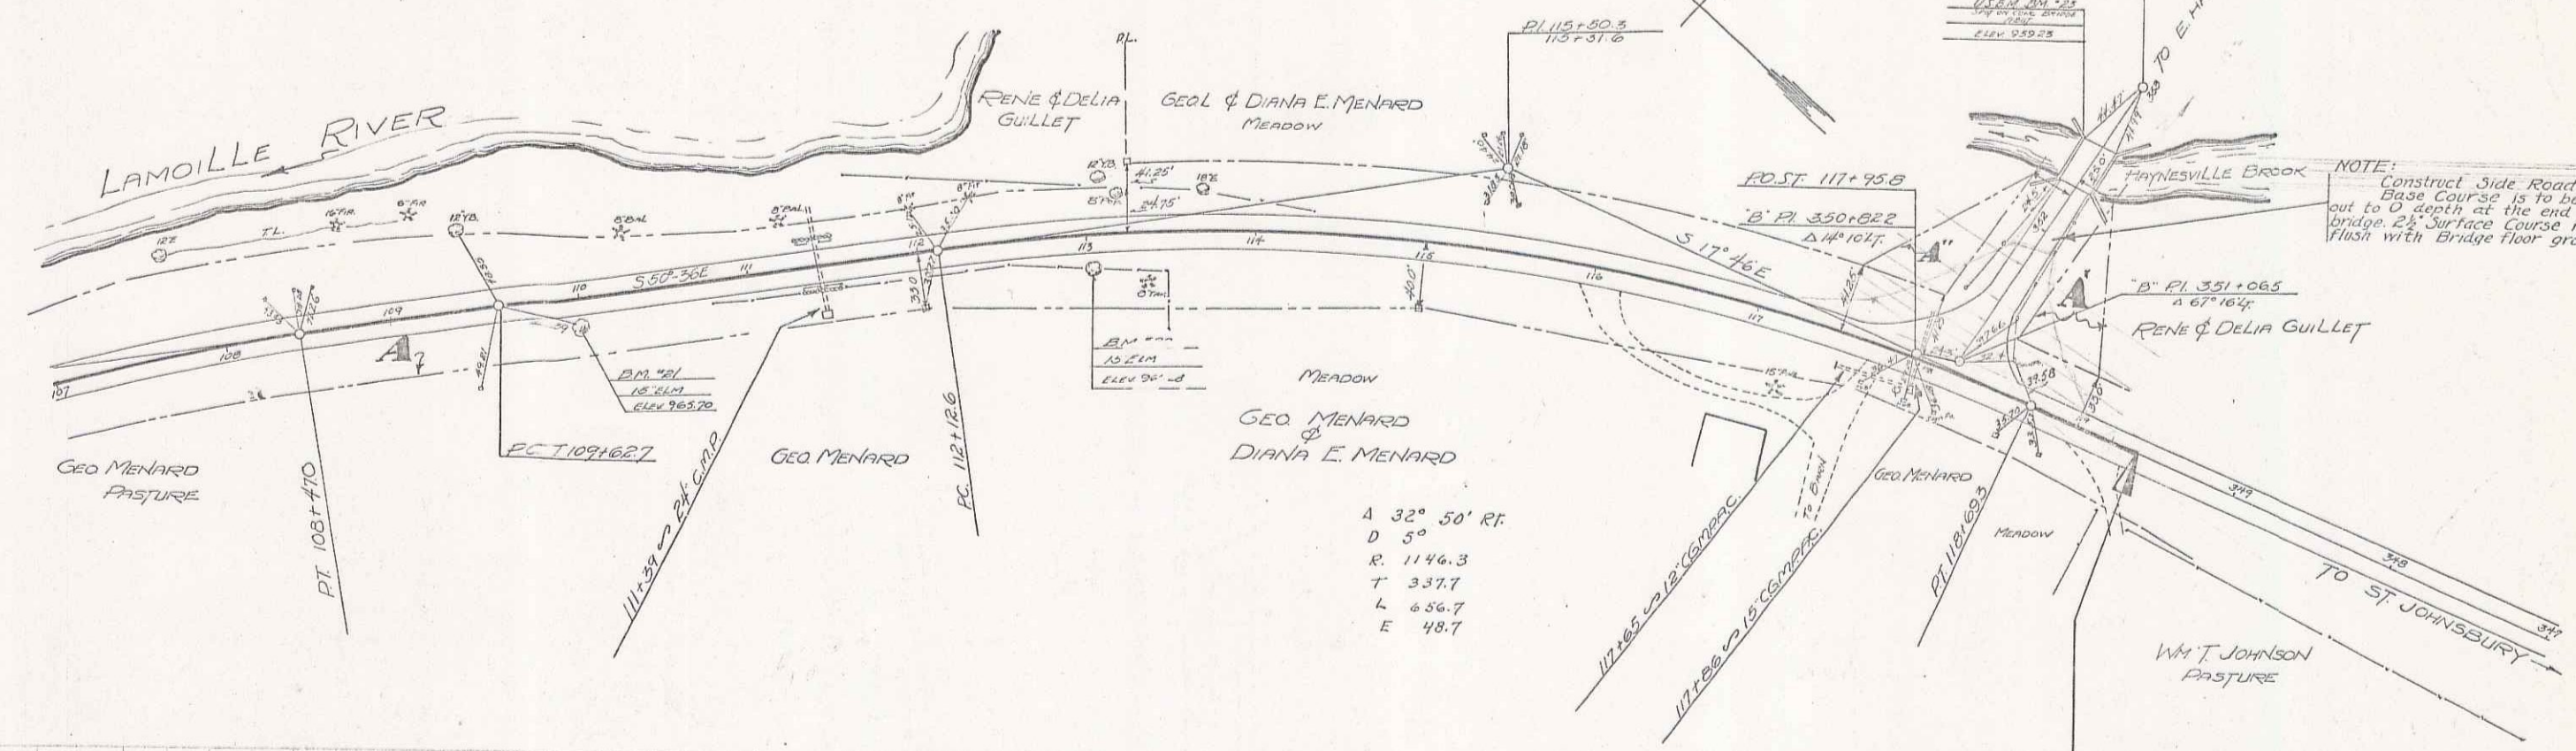

A 32° 50' 00" RT
 D 5°
 R 1146.3
 T 337.7
 L 656.7
 E 48.7

NOTE: Construct Side Road Approach Base Course to be 12' wide out to D aboth at the end of the bridge. 2' Surface Course is to be flush with Bridge floor grade.

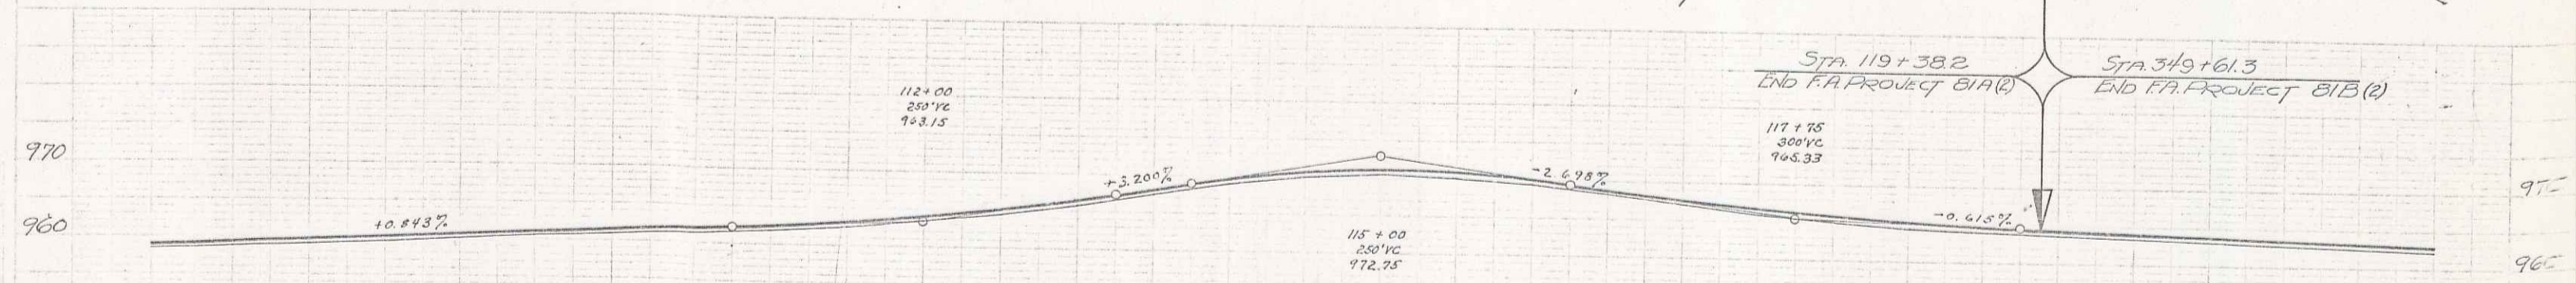

Note: Grade raised slightly in order to conform with existing road bed. See Cross Sections

STA 107+00 - STA 112+50
 Foundation 1/2" 3" Crushed Gravel Base course varied to meet field conditions. See Cross Sections

STA 112+50 - STA 119+382
 1/2" Crushed Gravel Base Course Varied to meet field conditions. See Cross Sections

Station	Elevation	Station	Elevation	Station	Elevation	Station	Elevation	Station	Elevation	Station	Elevation	Station	Elevation	Station	Elevation	Station	Elevation	Station	Elevation	Station	Elevation
107	968.16	110	960.02	113	965.92	116	967.08	119	966.37	122	963.8	125	962.8	128	962.7	131	962.7	134	962.7	137	962.7
108	968.77	111	960.53	114	967.15	117	967.54	120	966.09	123	963.8	126	962.8	129	962.7	132	962.7	135	962.7	138	962.7
109	969.23	112	961.01	115	967.49	118	967.87	121	966.32	124	963.8	127	962.8	130	962.7	133	962.7	136	962.7	139	962.7
110	969.55	113	961.49	116	967.75	119	968.14	122	966.57	125	963.8	128	962.8	131	962.7	134	962.7	137	962.7	140	962.7
111	969.87	114	961.97	117	968.03	120	968.52	123	966.90	126	963.8	129	962.8	132	962.7	135	962.7	138	962.7	141	962.7
112	970.19	115	962.45	118	968.31	121	968.80	124	967.28	127	963.8	130	962.8	133	962.7	136	962.7	139	962.7	142	962.7
113	970.51	116	962.93	119	968.59	122	969.08	125	967.56	128	963.8	131	962.8	134	962.7	137	962.7	140	962.7	143	962.7
114	970.83	117	963.45	120	968.87	123	969.36	126	967.84	129	963.8	132	962.8	135	962.7	138	962.7	141	962.7	144	962.7
115	971.15	118	963.97	121	969.15	124	969.64	127	968.12	130	963.8	133	962.8	136	962.7	139	962.7	142	962.7	145	962.7
116	971.47	119	964.49	122	969.43	125	969.92	128	968.40	131	963.8	134	962.8	137	962.7	140	962.7	143	962.7	146	962.7
117	971.79	120	965.01	123	969.71	126	970.20	129	968.68	132	963.8	135	962.8	138	962.7	141	962.7	144	962.7	147	962.7
118	972.11	121	965.53	124	970.03	127	970.47	130	968.96	133	963.8	136	962.8	139	962.7	142	962.7	145	962.7	148	962.7
119	972.43	122	966.05	125	970.31	128	970.74	131	969.24	134	963.8	137	962.8	140	962.7	143	962.7	146	962.7	149	962.7
120	972.75	123	966.57	126	970.59	129	971.02	132	969.52	135	963.8	138	962.8	141	962.7	144	962.7	147	962.7	150	962.7
121	973.07	124	967.09	127	970.87	130	971.30	133	969.80	136	963.8	139	962.8	142	962.7	145	962.7	148	962.7	151	962.7
159	985.23	162	986.85	165	981.51	168	981.94	171	980.44	174	963.8	177	962.8	180	962.7	183	962.7	186	962.7	189	962.7
160	985.55																				