


PLAN  
 DATE  
 DRAWN BY  
 CHECKED BY

1924  
 1923  
 DATE  
 DRAWN BY  
 CHECKED BY

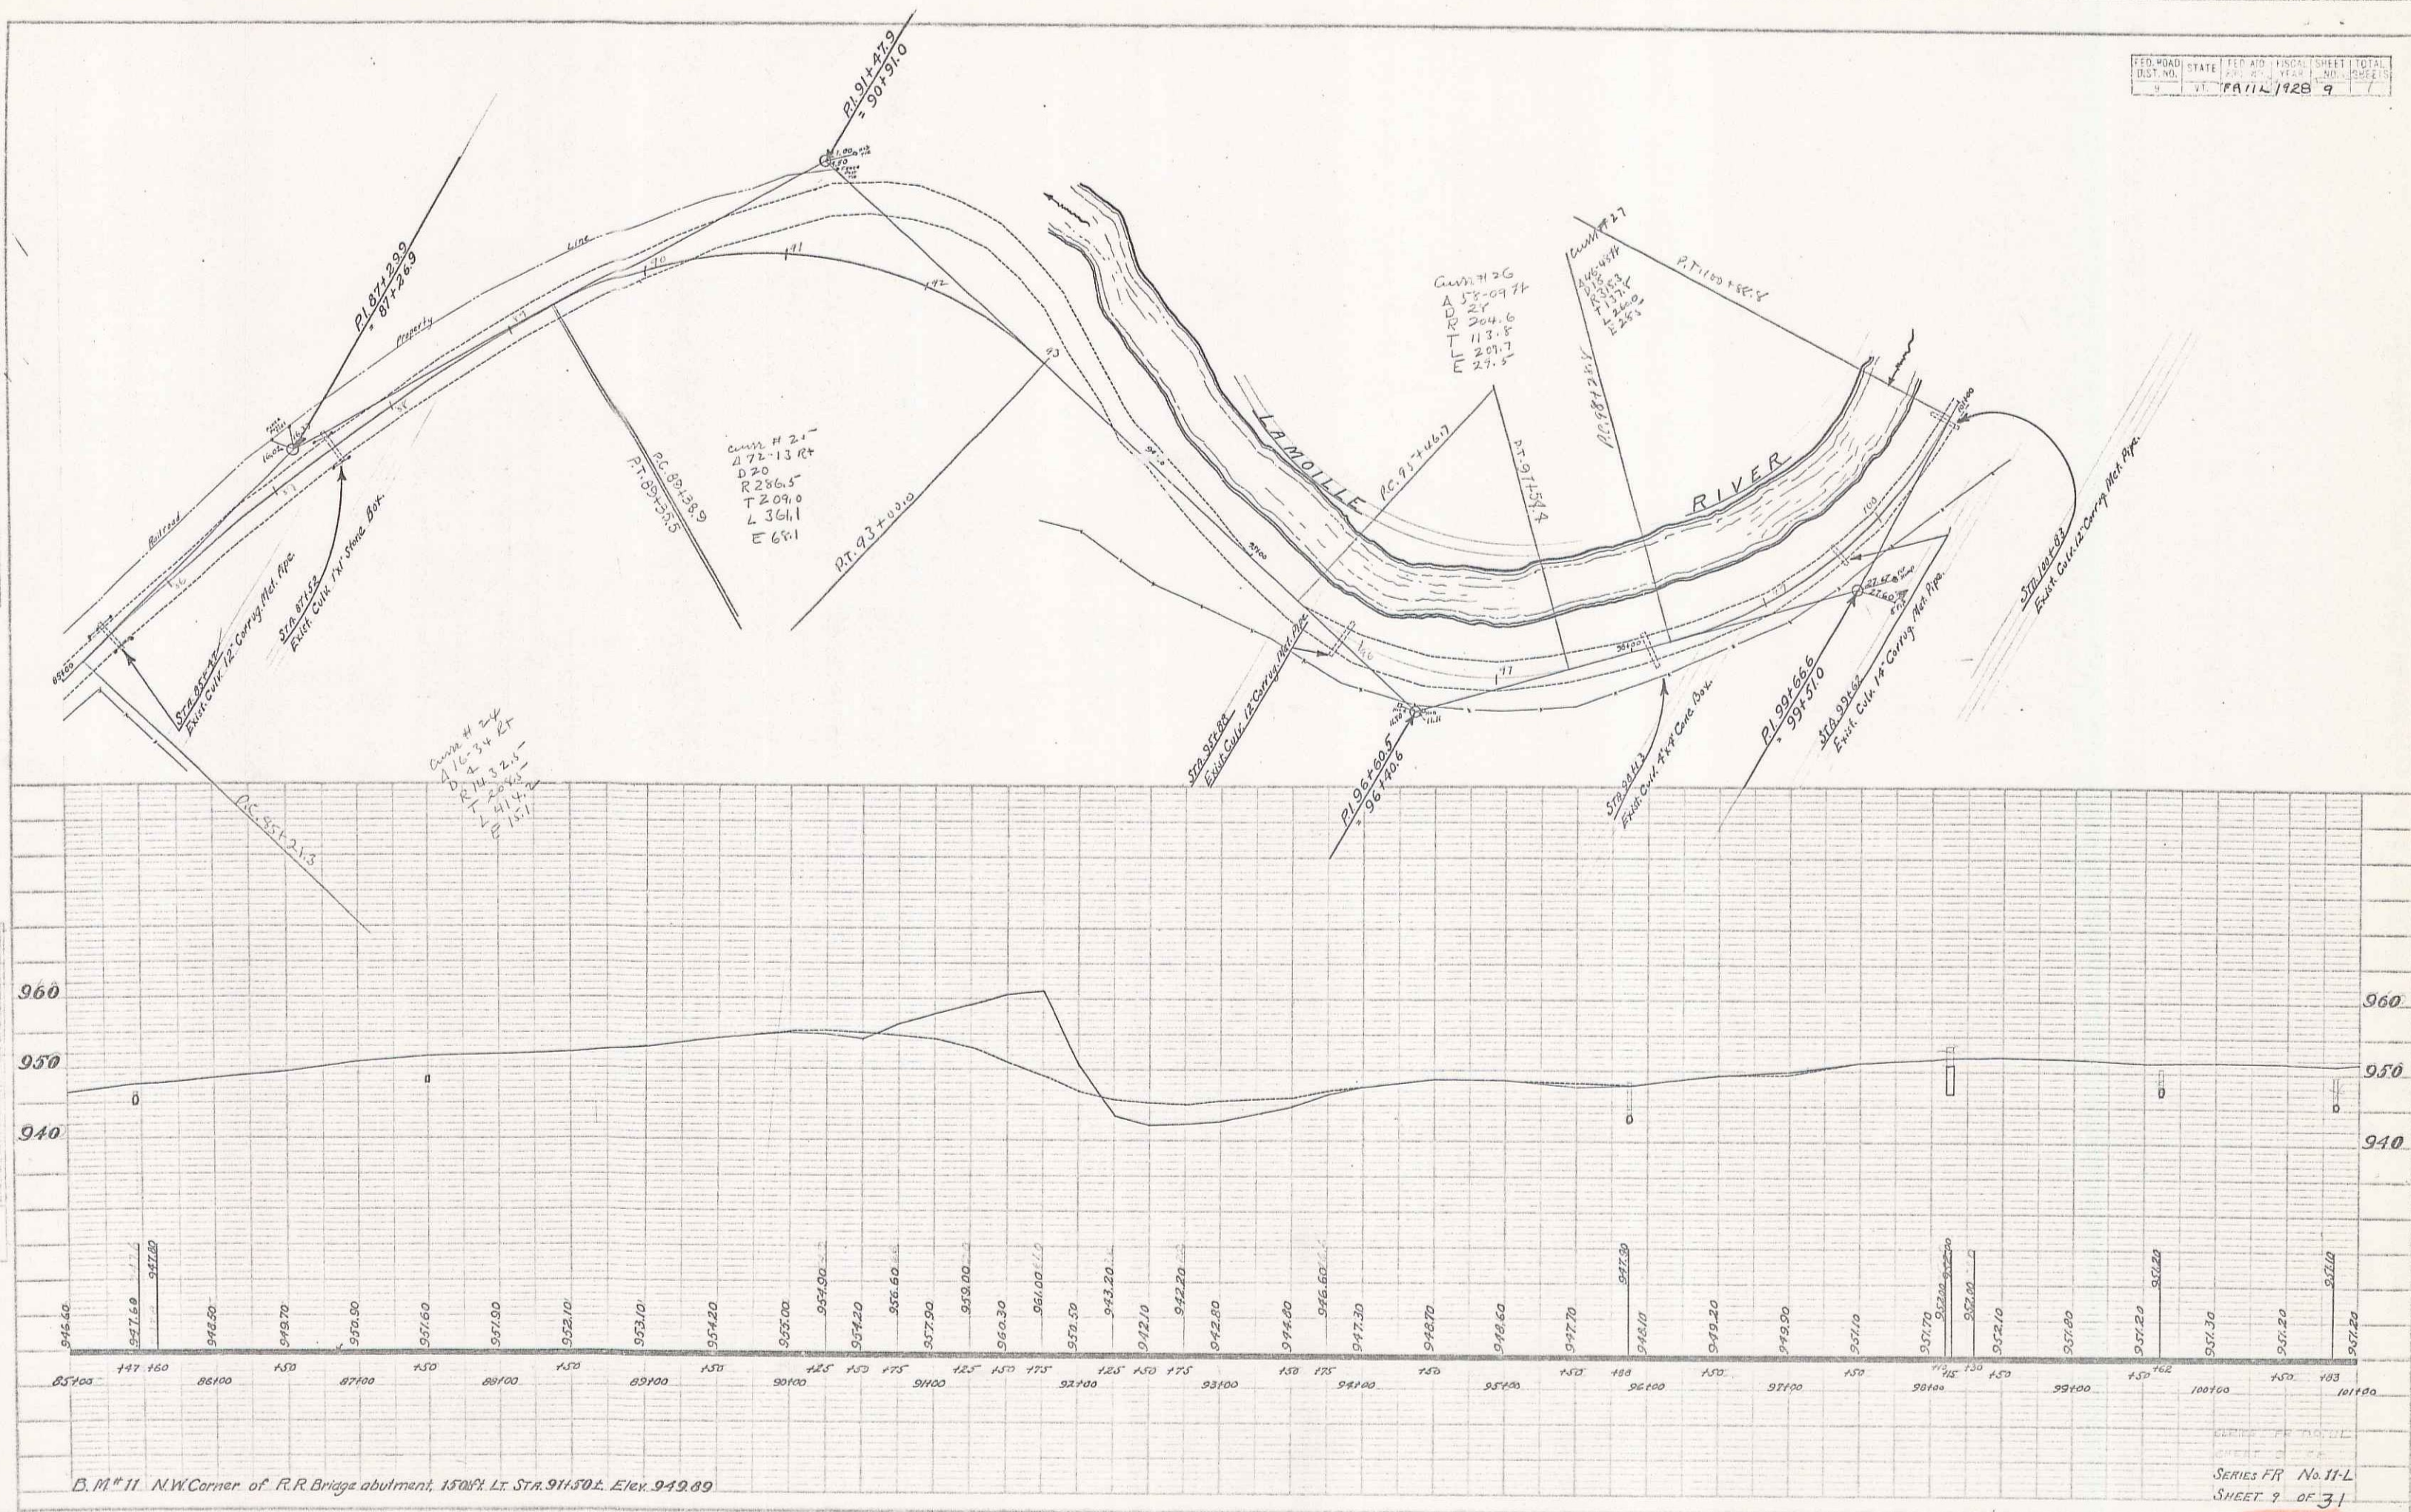

B. M. 11 N.W. Corner of R.R. Bridge abutment, 15087 Lt. Sta. 91130 L. Elev. 949.89

SERIES FR No. 11-L  
 SHEET 9 OF 31