


**-NEW WOOD GUARD RAIL REQUIRED-**  
 -ON DIANT-  
 Sta 128+13 to Sta 128+37 Length 24 FT  
 " 129+67 " " 129+91 " 24 "  
 " 133+93 " " 134+17 " 24 "  
 " 137+63 " " 137+87 " 24 "  
 " 138+53 " " 138+77 " 24 "  
 " 141+72 " " 141+96 " 24 "  
 -ON LEFT-  
 Sta 141+72 to Sta 141+96 Length 24 FT  
 TOTAL OFF SHEET 168 FT.

**-NEW CABLE GUARD RAIL REQUIRED-**  
 -ON LEFT-  
 Sta 128+00 to Sta 129+99 Length 199 FT  
 Sta 130+71 to Sta 130+77 " 600 "  
 TOTAL OFF SHEET 994 FT.

113 ROAD DIST. NO. STATE ILL. 2nd DIST. SHEET TOTAL SHEETS  
 9 113 FR 111, 122, 8, 12, 31

**-NEW CULVERTS REQUIRED-**  
 Sta 128+25 Construct New 18" Rein Concrete Pipe Length 321  
 Concrete Class BU(2:2:3) 3.1 Cu Yds.  
 Reinforcing Steel 33 Lbs.  
 Sta 129+79 Construct New 36" Box Culvert  
 Concrete Class AU(2:2:4) 15.7 Cu Yds.  
 Reinforcing Steel 1018 Lbs.  
 Sta 134+05 Construct New 24" Rein Concrete Pipe Length 361  
 Concrete Class AU(2:2:4) 2.6 Cu Yds.  
 Reinforcing Steel 39 Lbs.  
 Sta 137+75 Construct New 18" Rein Concrete Pipe Length 30  
 Concrete Class AU(2:2:4) 1.9 Cu Yds.  
 Reinforcing Steel 29 Lbs.  
 Sta 141+89 Construct New 24" Rein Concrete Pipe Length 201  
 Concrete Class AU(2:2:4) 2.6 Cu Yds.  
 Reinforcing Steel 34 Lbs.

**-NEW CULVERT REPAIRS REQUIRED-**  
 Sta 138+70 Present Structure 3'0" x 3'6" Conc. Box  
 Construct 7 FT Extension on Left

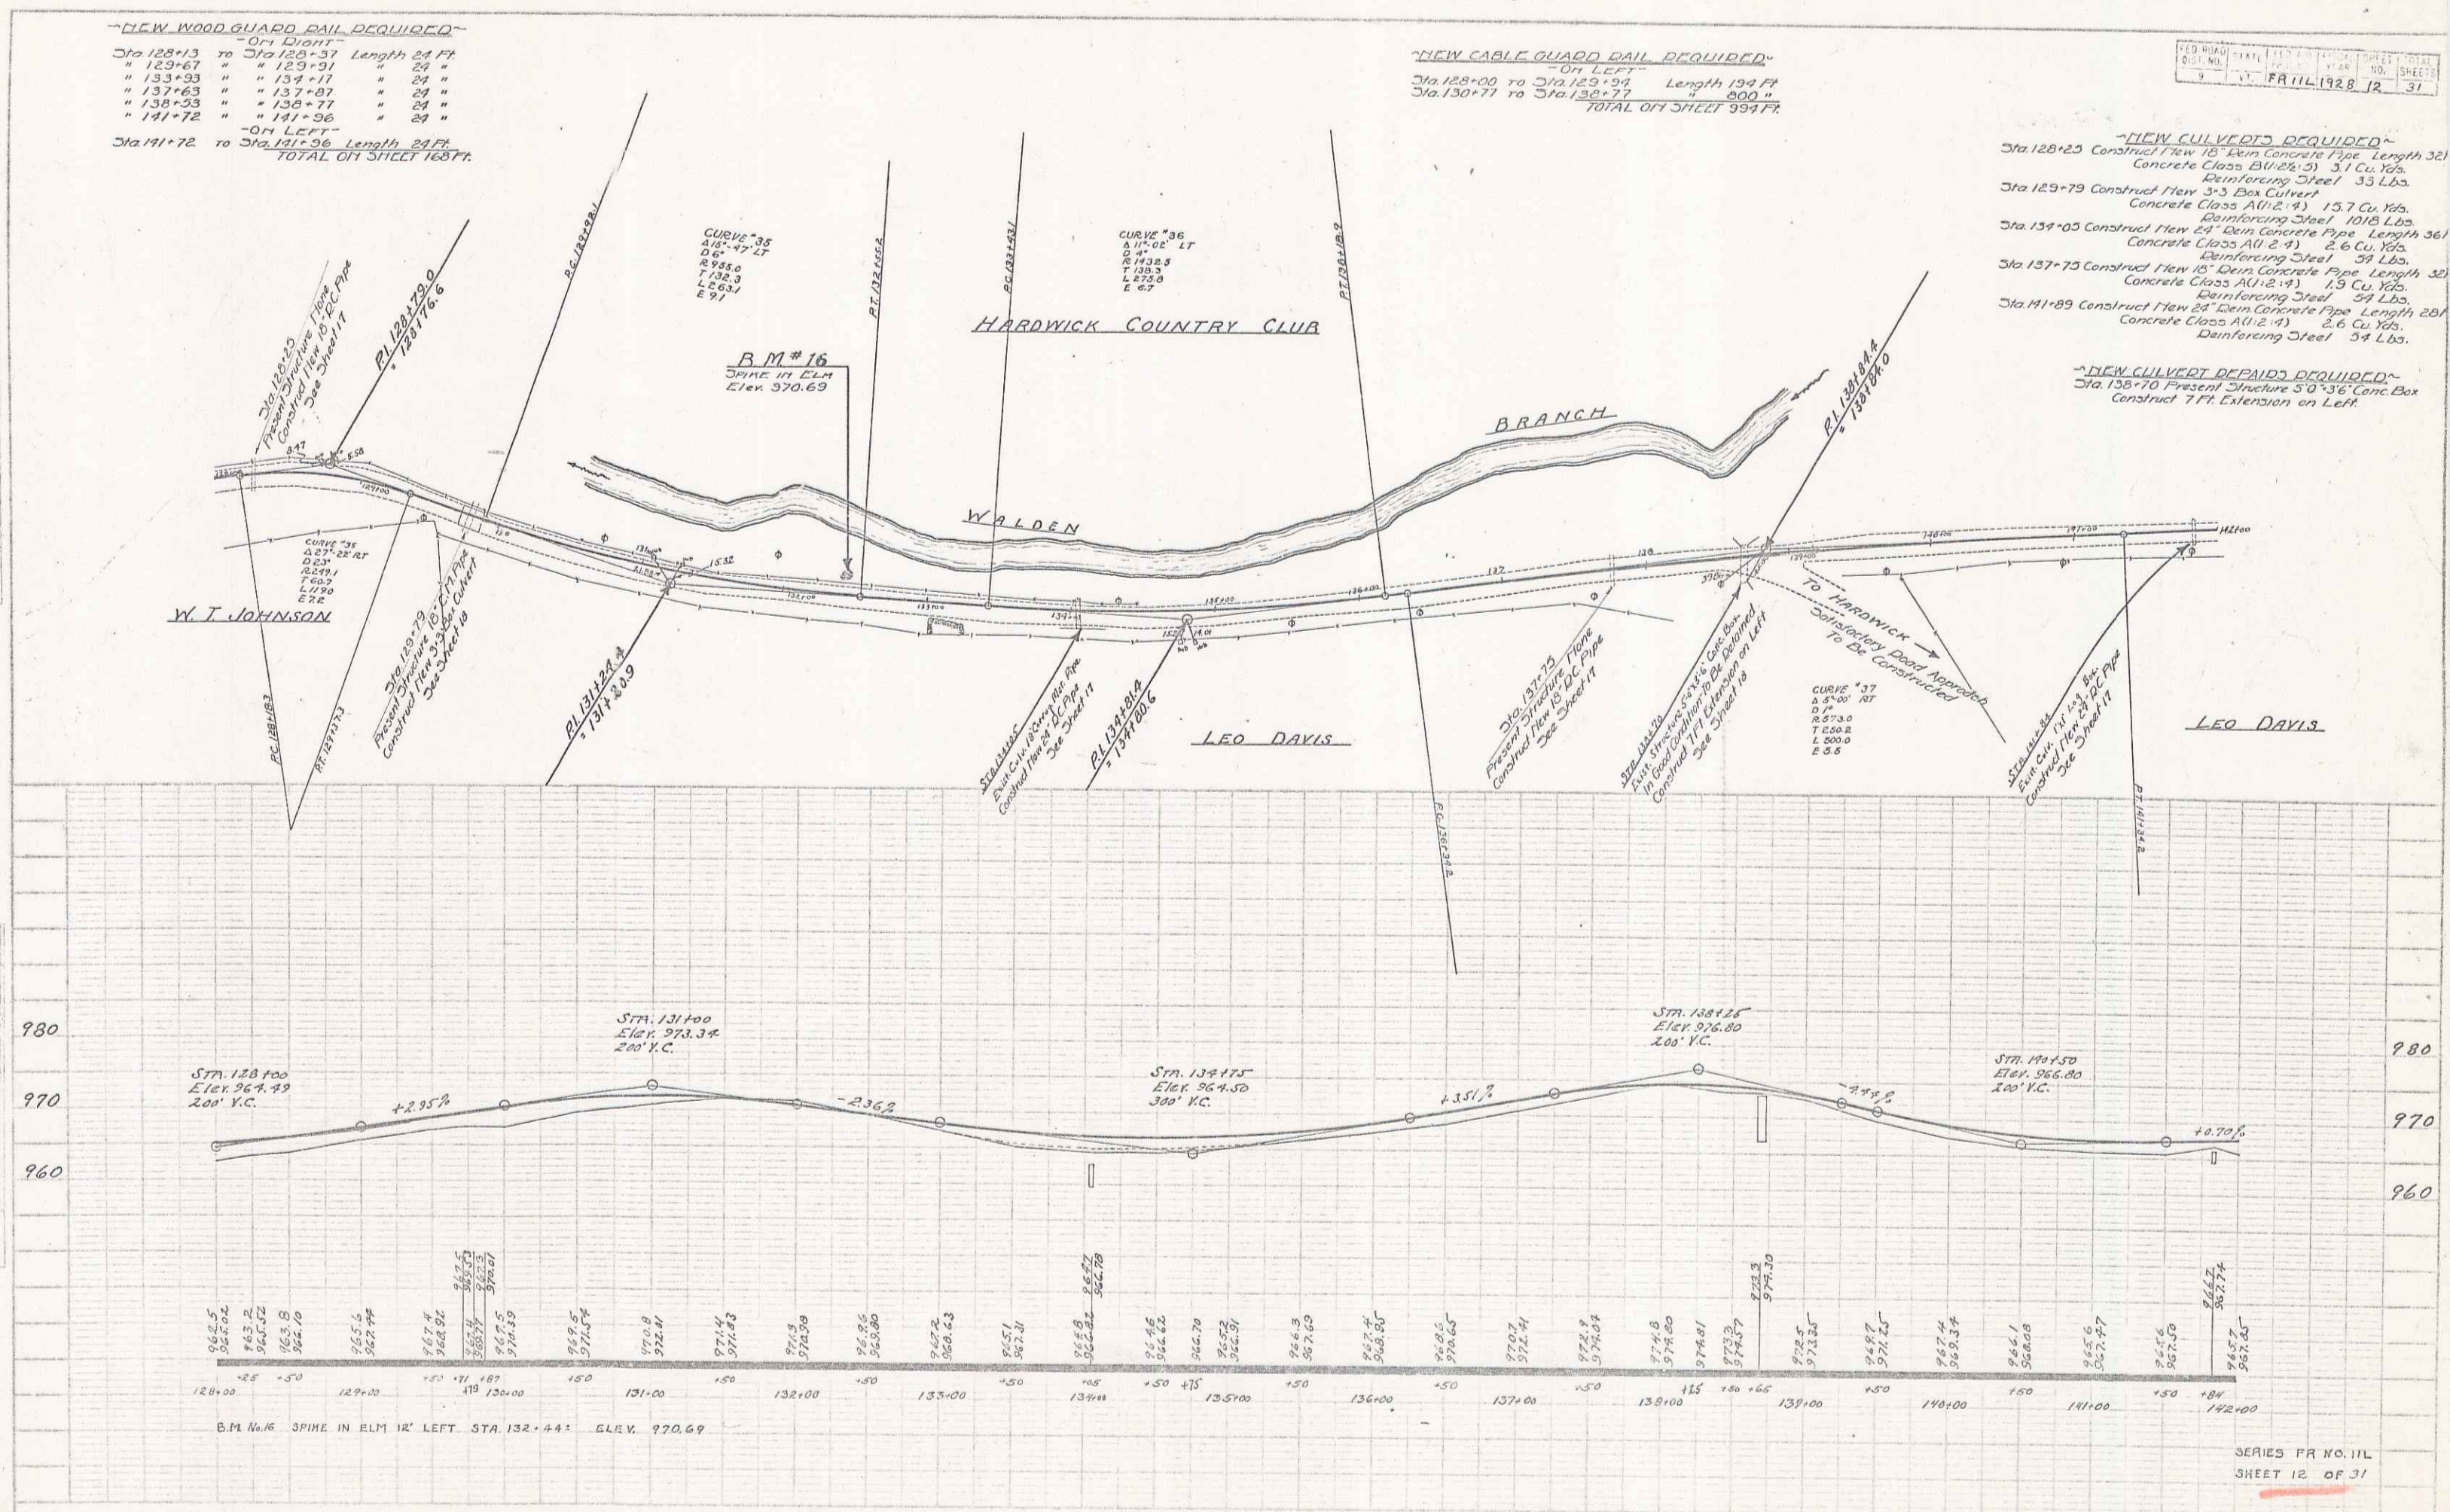

next sheet sheet #13 missing

10

SERIES PR NO. 111  
 SHEET 12 OF 31