
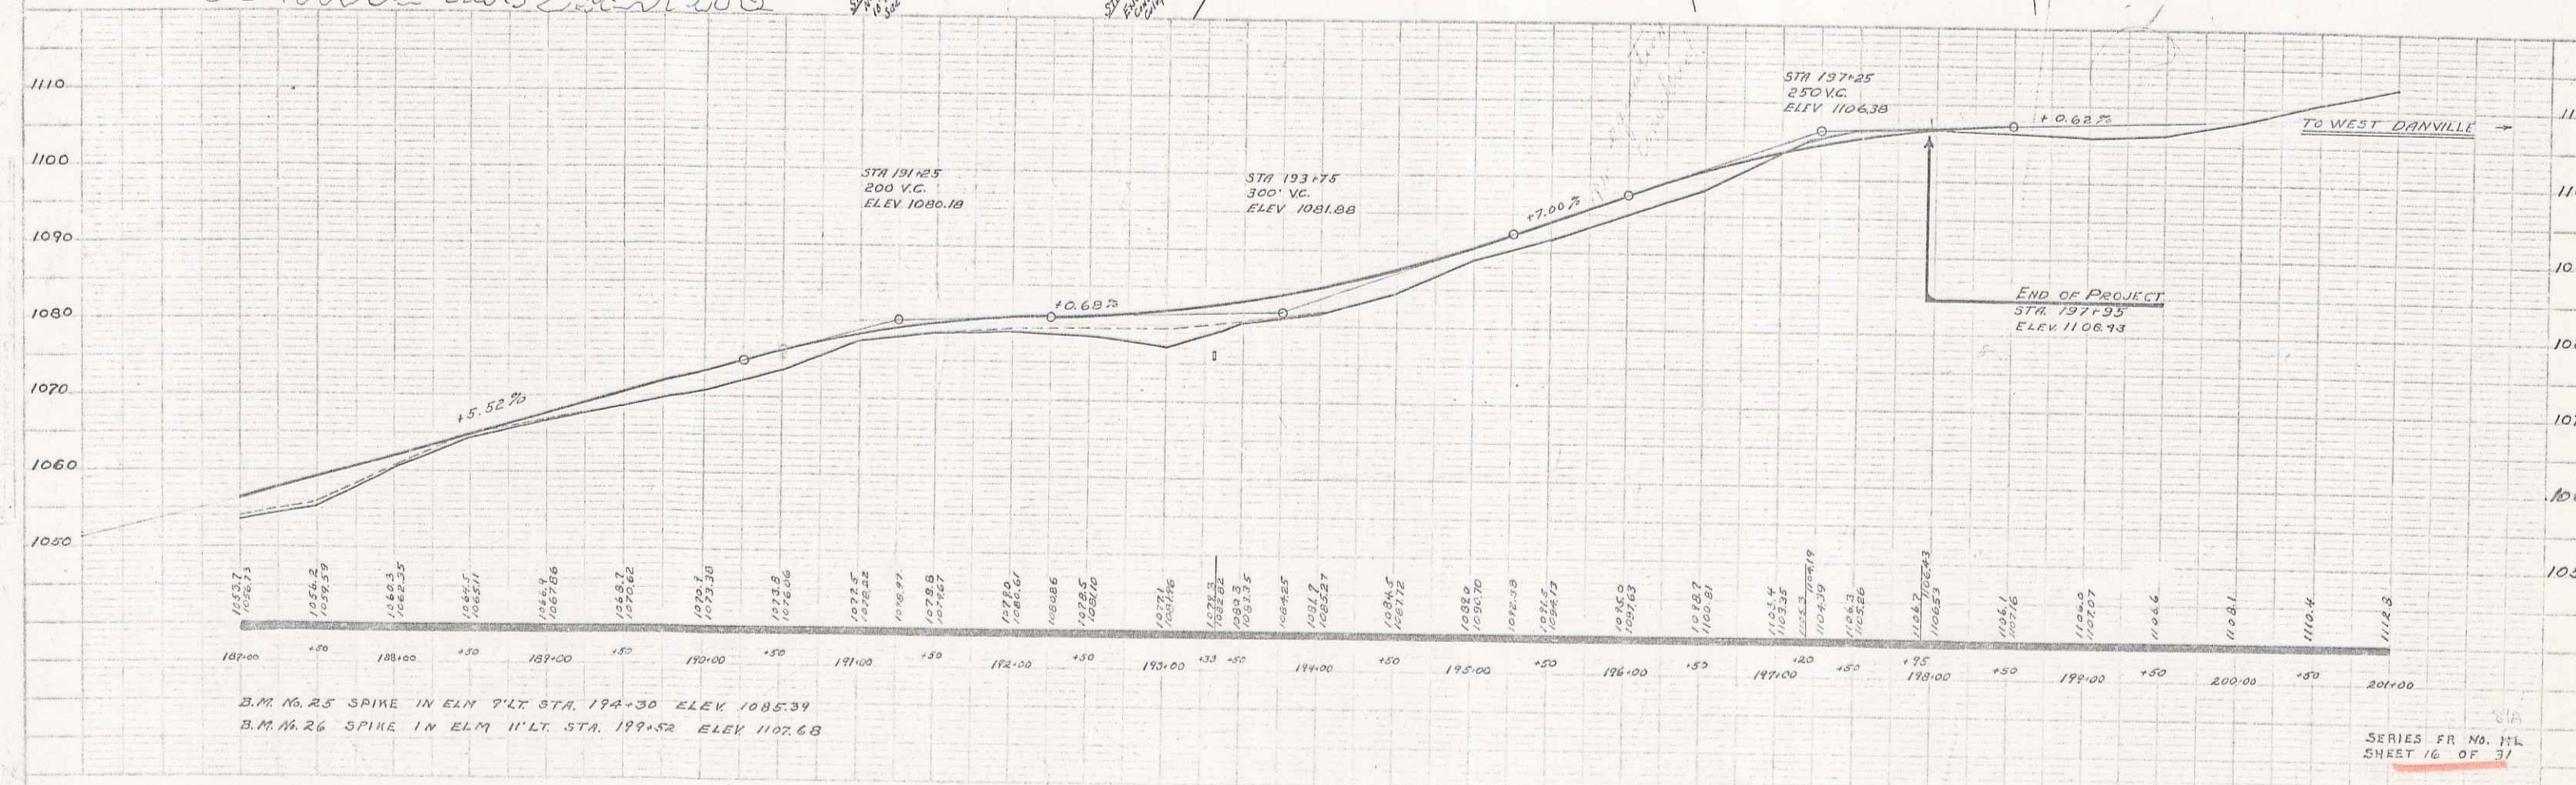


NEW CABLE GUARD RAIL REQUIRED
 ON LEFT
 Sta. 191+80 to Sta. 193+48 Length 268 FT.

NEW WOOD GUARD RAIL REQUIRED
 ON RIGHT
 Sta. 189+13 to Sta. 193+37 Length 424 FT.
 Sta. 193+21 to Sta. 193+93 " 72"
 ON LEFT
 Sta. 189+13 to Sta. 193+37 Length 244 FT.
 TOTAL OF SHEET 72 FT.

NEW CULVERTS REQUIRED
 Sta. 189+25 18" Round Conc. Pipe, 40 ft. long,
 Conc. Class B (1-2x-5) 3.1 cu yds.
 Reinf. Steel, 33 lbs.
 Sta. 193+25 24" Round Conc. Pipe, 36 ft. long,
 Conc. Class A (1-2-4) 2.6 cu yds.
 Reinf. Steel, 54 lbs.

FED. ROAD DIST. NO. STATE PROJECT NO. SHEET TOTAL
 FRUIT 1928 16 31

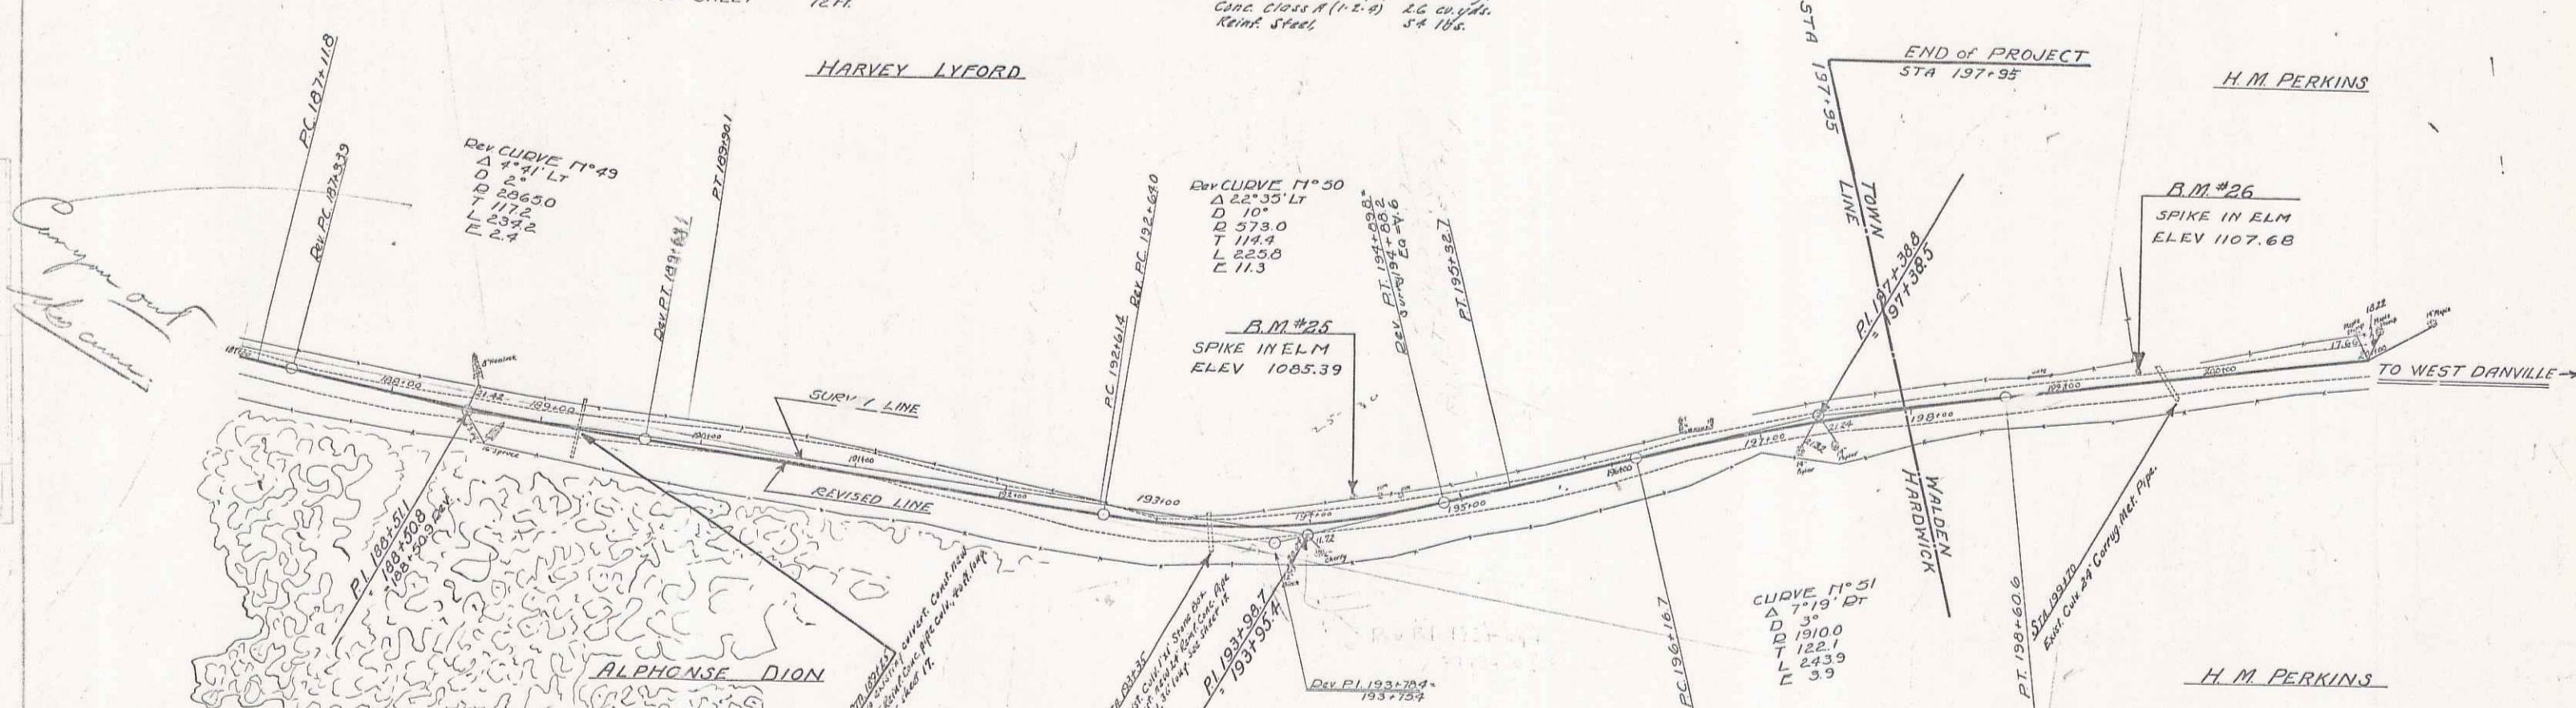

B.M. #25 SPIKE IN ELM 7' LT. STA. 194+30 ELEV 1085.39
 B.M. #26 SPIKE IN ELM 11' LT. STA. 199+52 ELEV 1107.68

SERIES FR NO. 11L
 SHEET 16 OF 31