



PLAN  
 SHEET NO. 4  
 DATE 1907

PLAN  
 SHEET NO. 4  
 DATE 1907

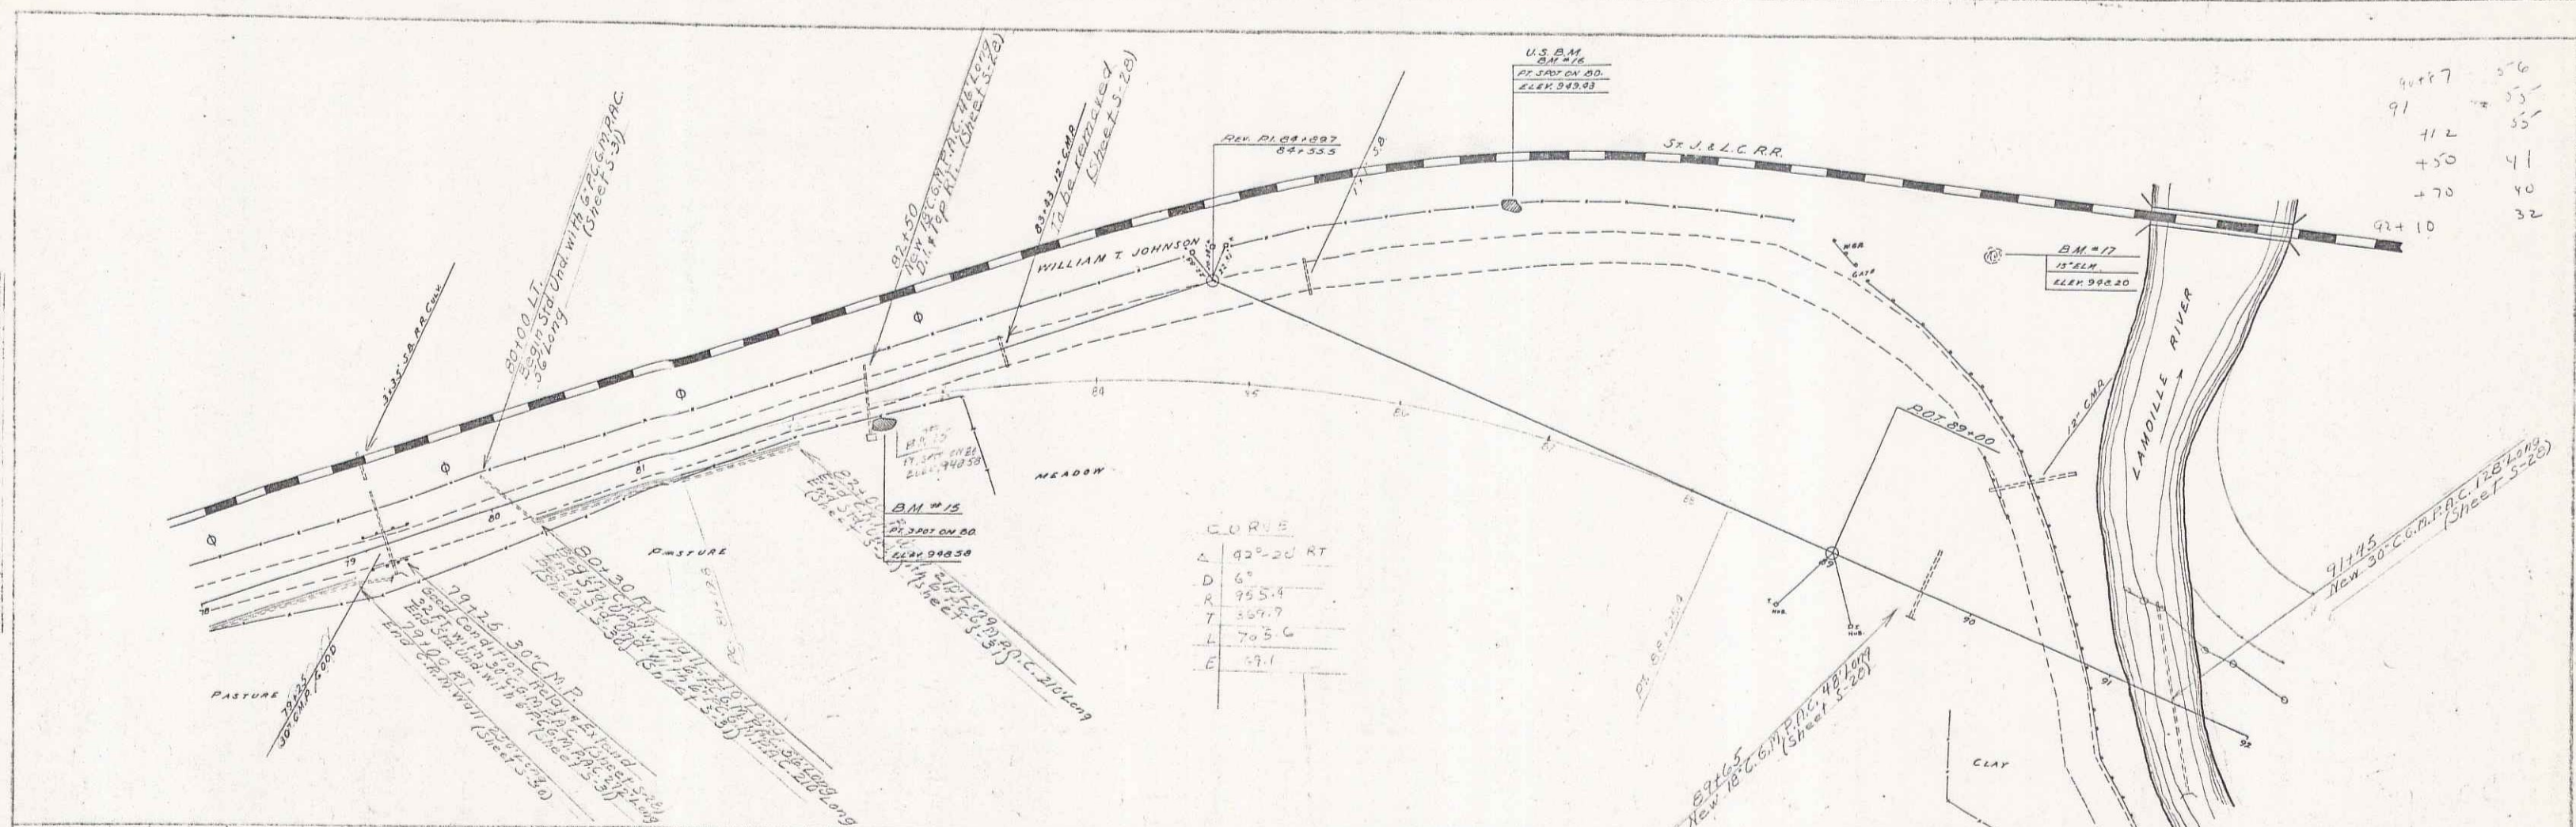

91+7	56
91	55
+50	41
+70	40
92+10	32

CURVE  
 Δ 42° 20' RT  
 D 6'  
 R 955.4  
 T 59.7  
 L 703.6  
 E 57.1

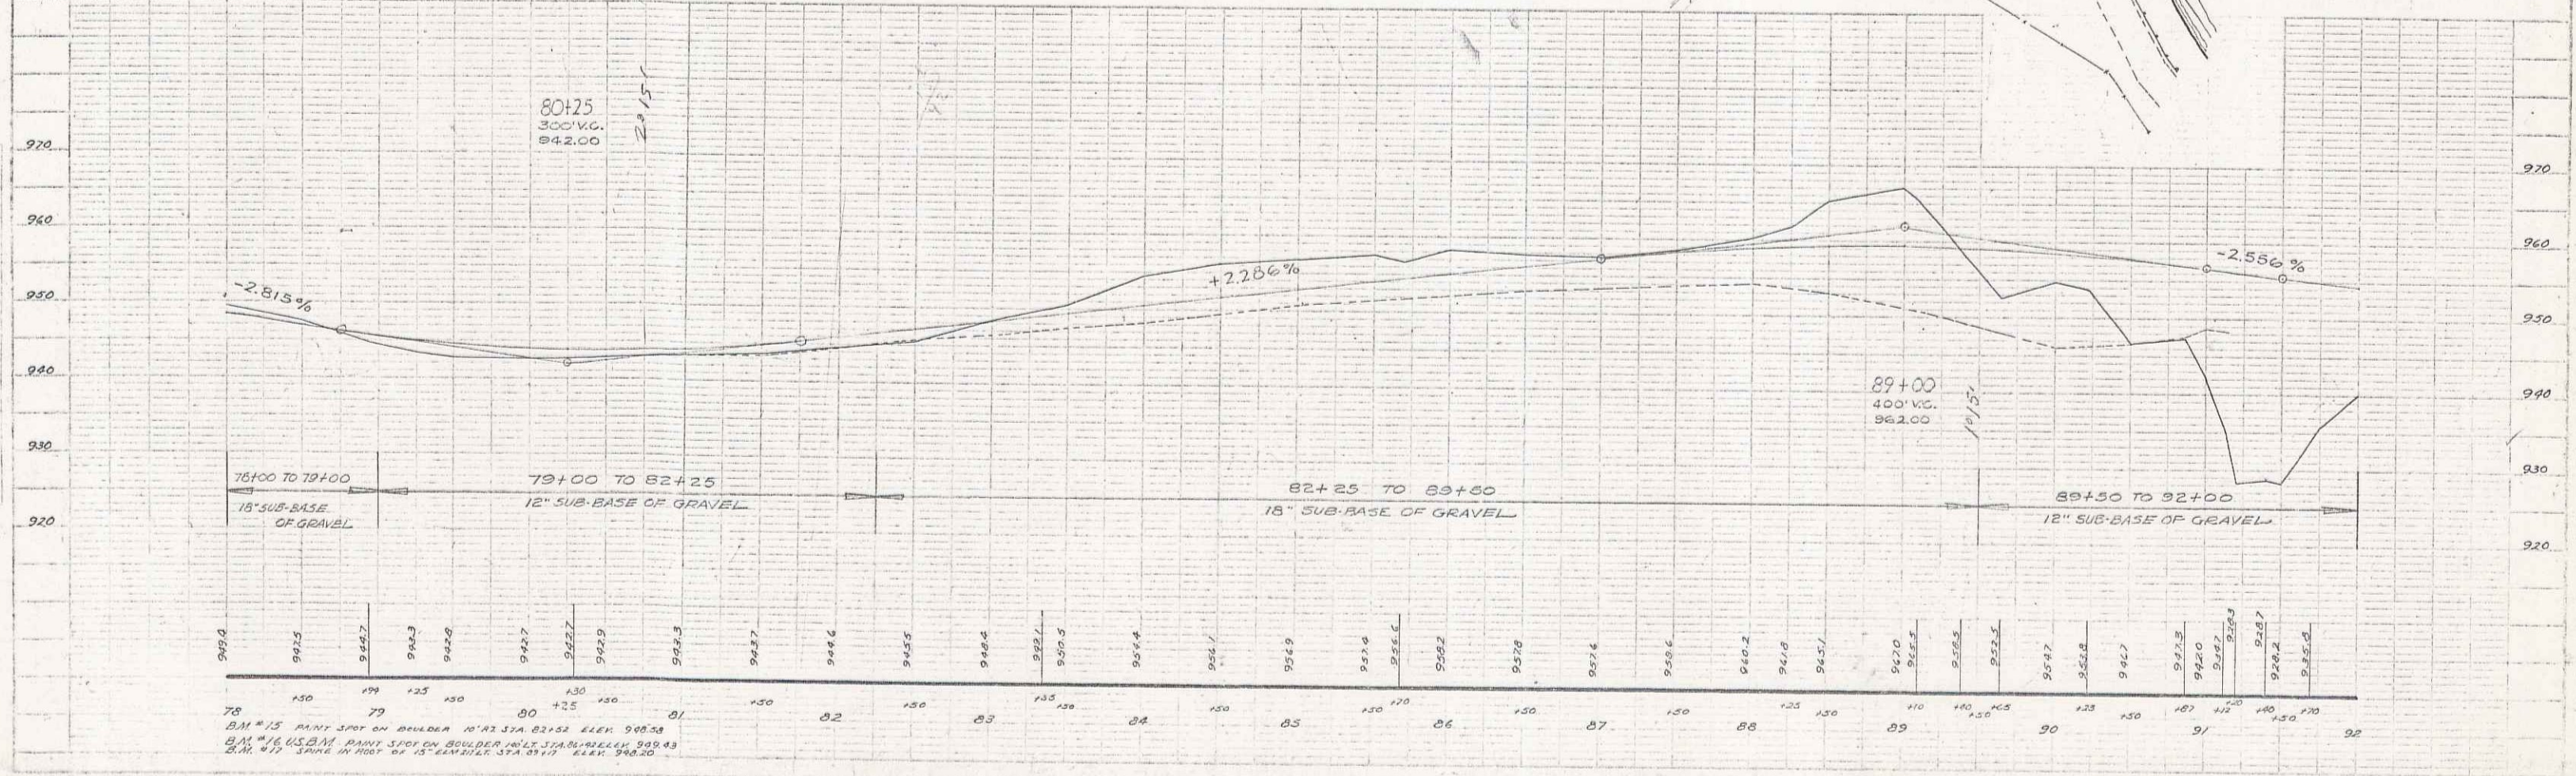

75+00 TO 79+00 15' SUB-BASE OF GRAVEL  
 79+00 TO 82+25 12' SUB-BASE OF GRAVEL  
 82+25 TO 89+60 18' SUB-BASE OF GRAVEL  
 89+60 TO 92+00 12' SUB-BASE OF GRAVEL

4 of 6 4