


CURBS
 A 32'-31.87'
 D 7'
 R 0.000
 T 2.572
 L 569.8
 E 52.2

24" Black Iron Pipe
 Used as a vent for water
 pipe crossing the road.
 4' Under & grade. 42' long.

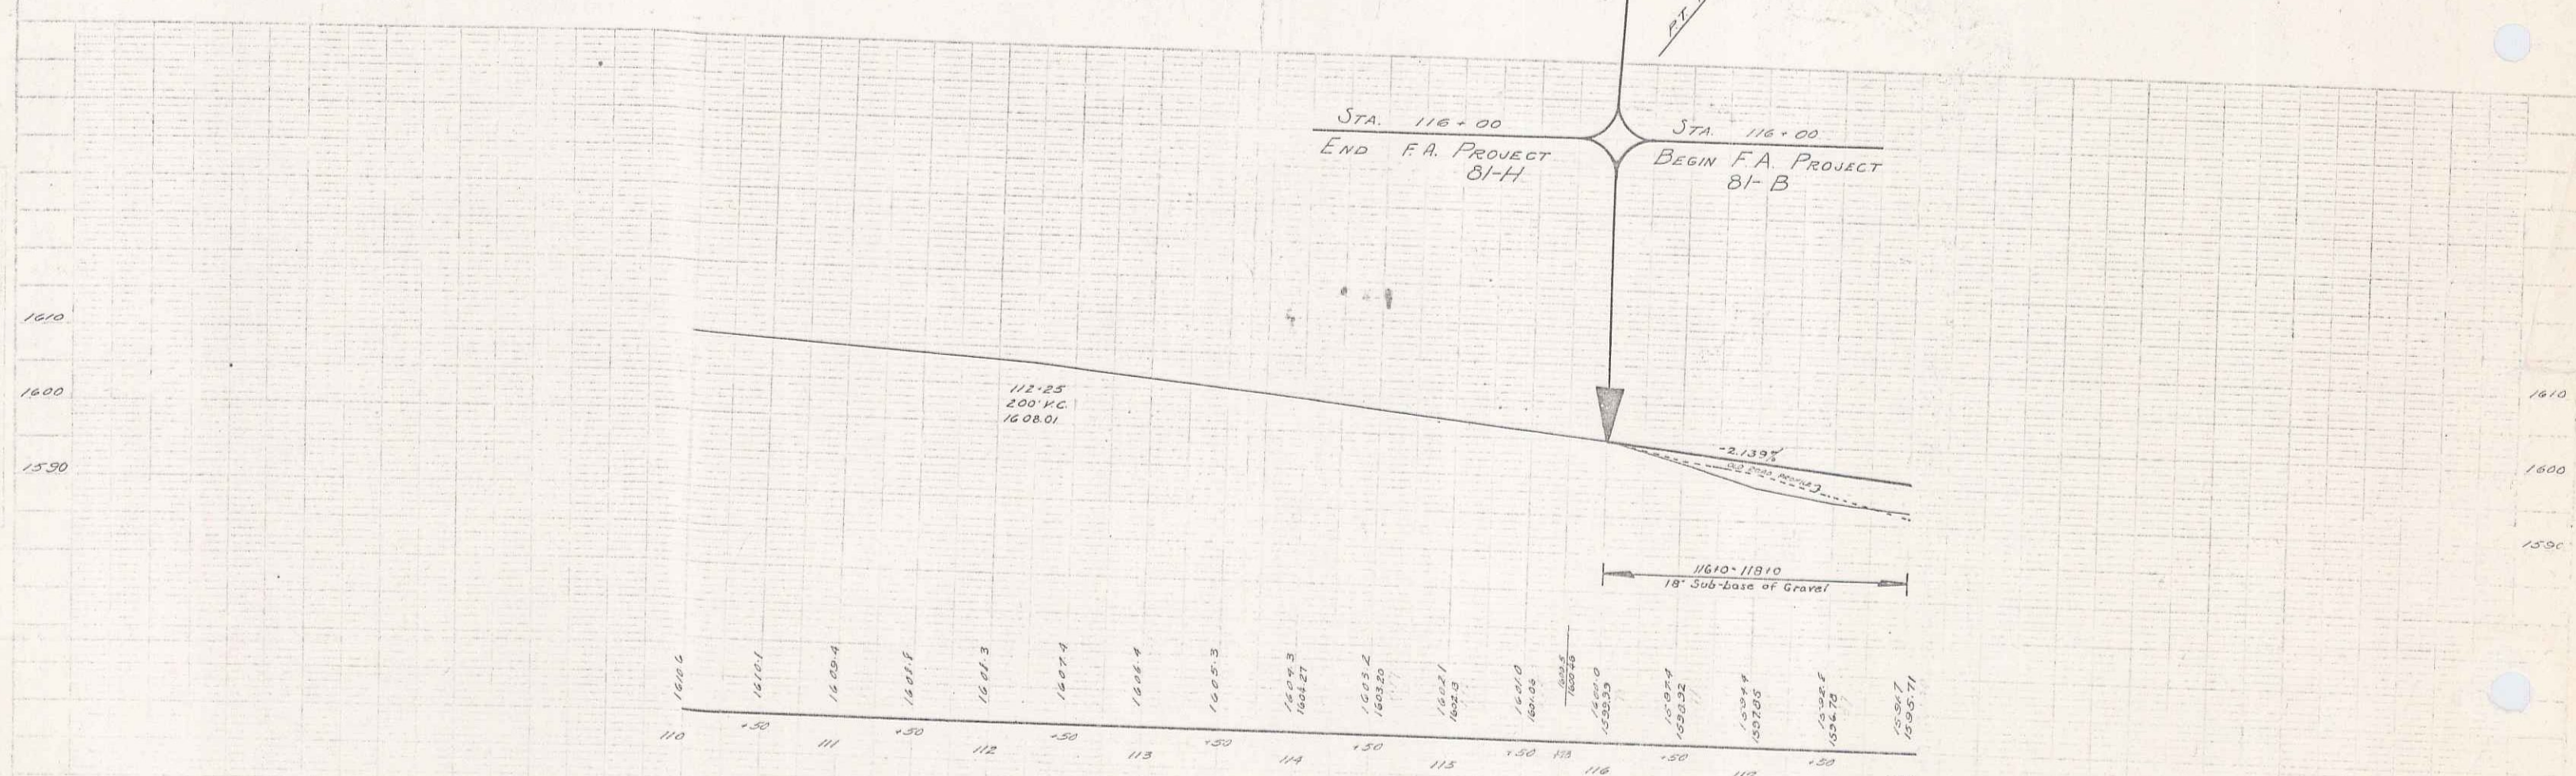

TITLE
 SHEET
 DATE

2