
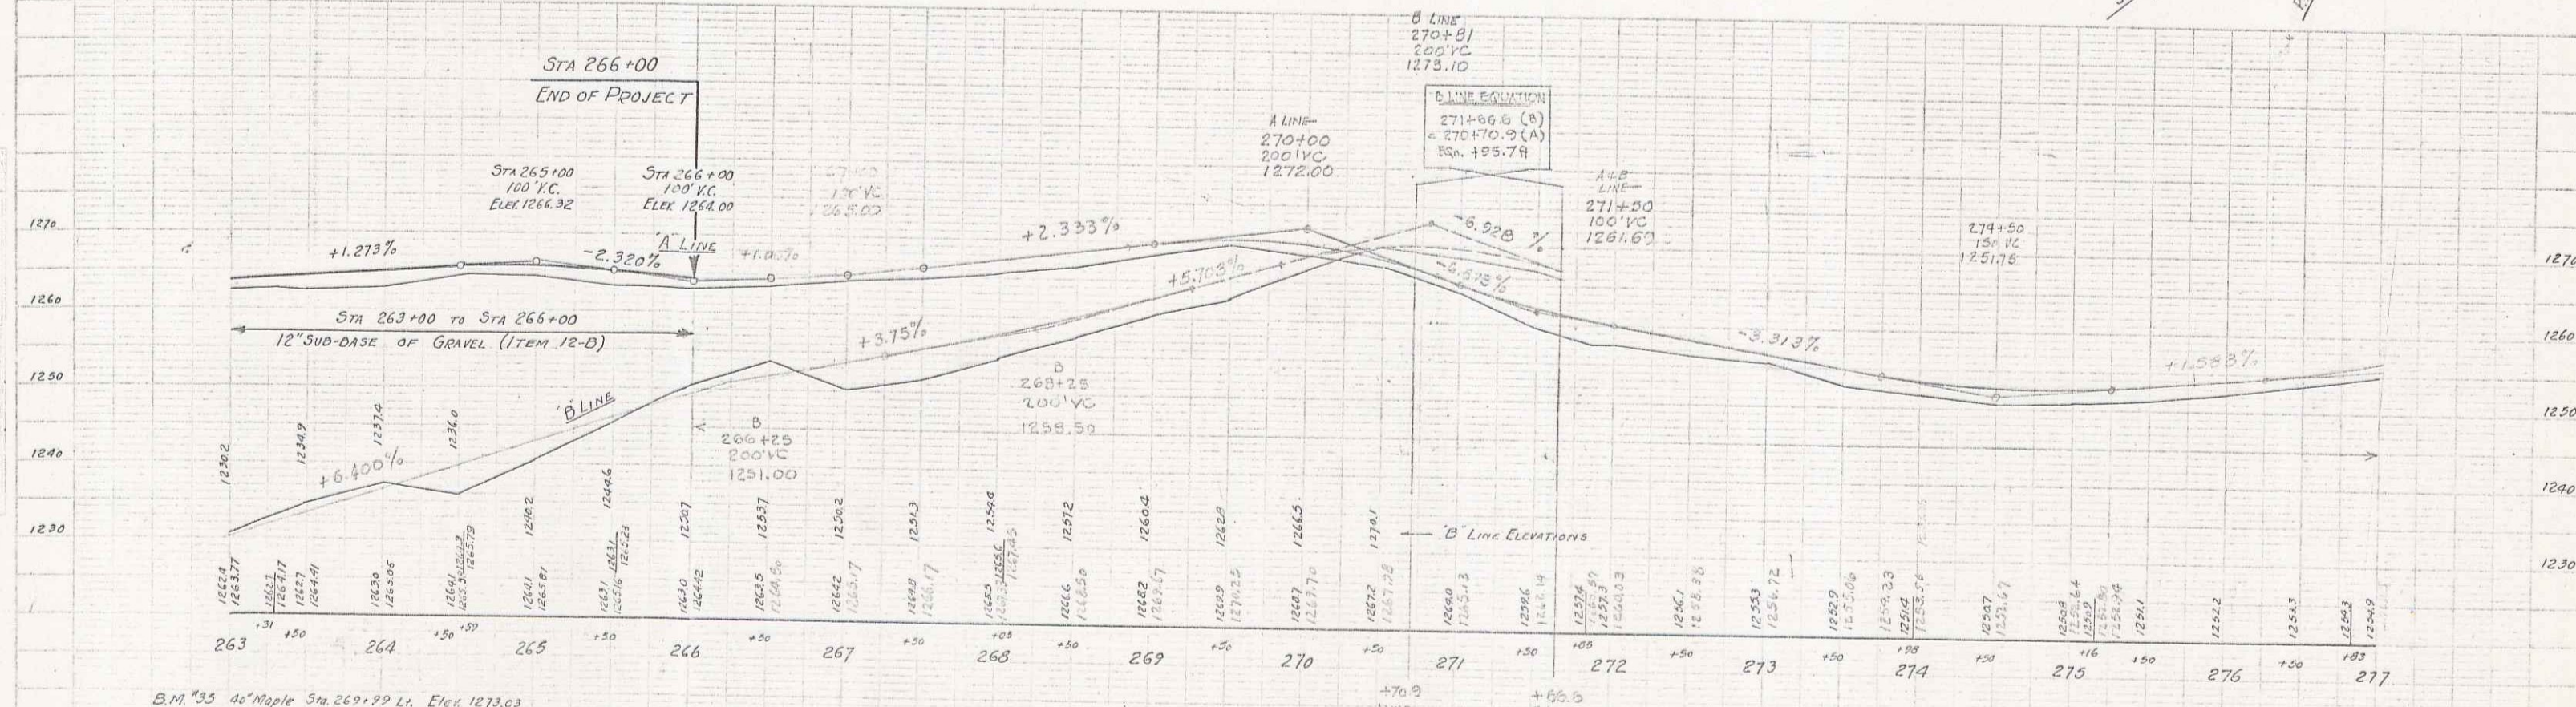


WOOD GUARD RAIL REQUIRED			CABLE GUARD RAIL REQUIRED			NEW CORR GALV METAL PIPE CONCRETS PROVIDED			CONCRETE REPAIRS REQUIRED				
CULVERT STATION	LEFT	RIGHT	STA. TO STA.	LEFT	RIGHT	STATION	SIZE	LENGTH	CONCRETE REPAIRS	STATION	NATURE OF REPAIRS	C.G.M.P.	CEMENT ROADS
263+31	24'	24'	264+25-266+25	-	200'	263+31	14"	28'	2.7 cu yds.	268+05	Reset + extend 8 ft.	12"	2.3 cu yds.
B'LINE 264+50	24'	-				264+50	14"	36'	2.5 cu yds. B'LINE				
265+05	24'	24'				265+53	12"	32'	2.3 cu yds.				
B'LINE 267+00	24'	24'				267+00	18"	36'	3.3 cu yds. B'LINE				
268+05	24'	24'				268+05	12"	8'	2.3 cu yds.				
271+85	24'	-				271+85	16"	48'	2.7 cu yds.				

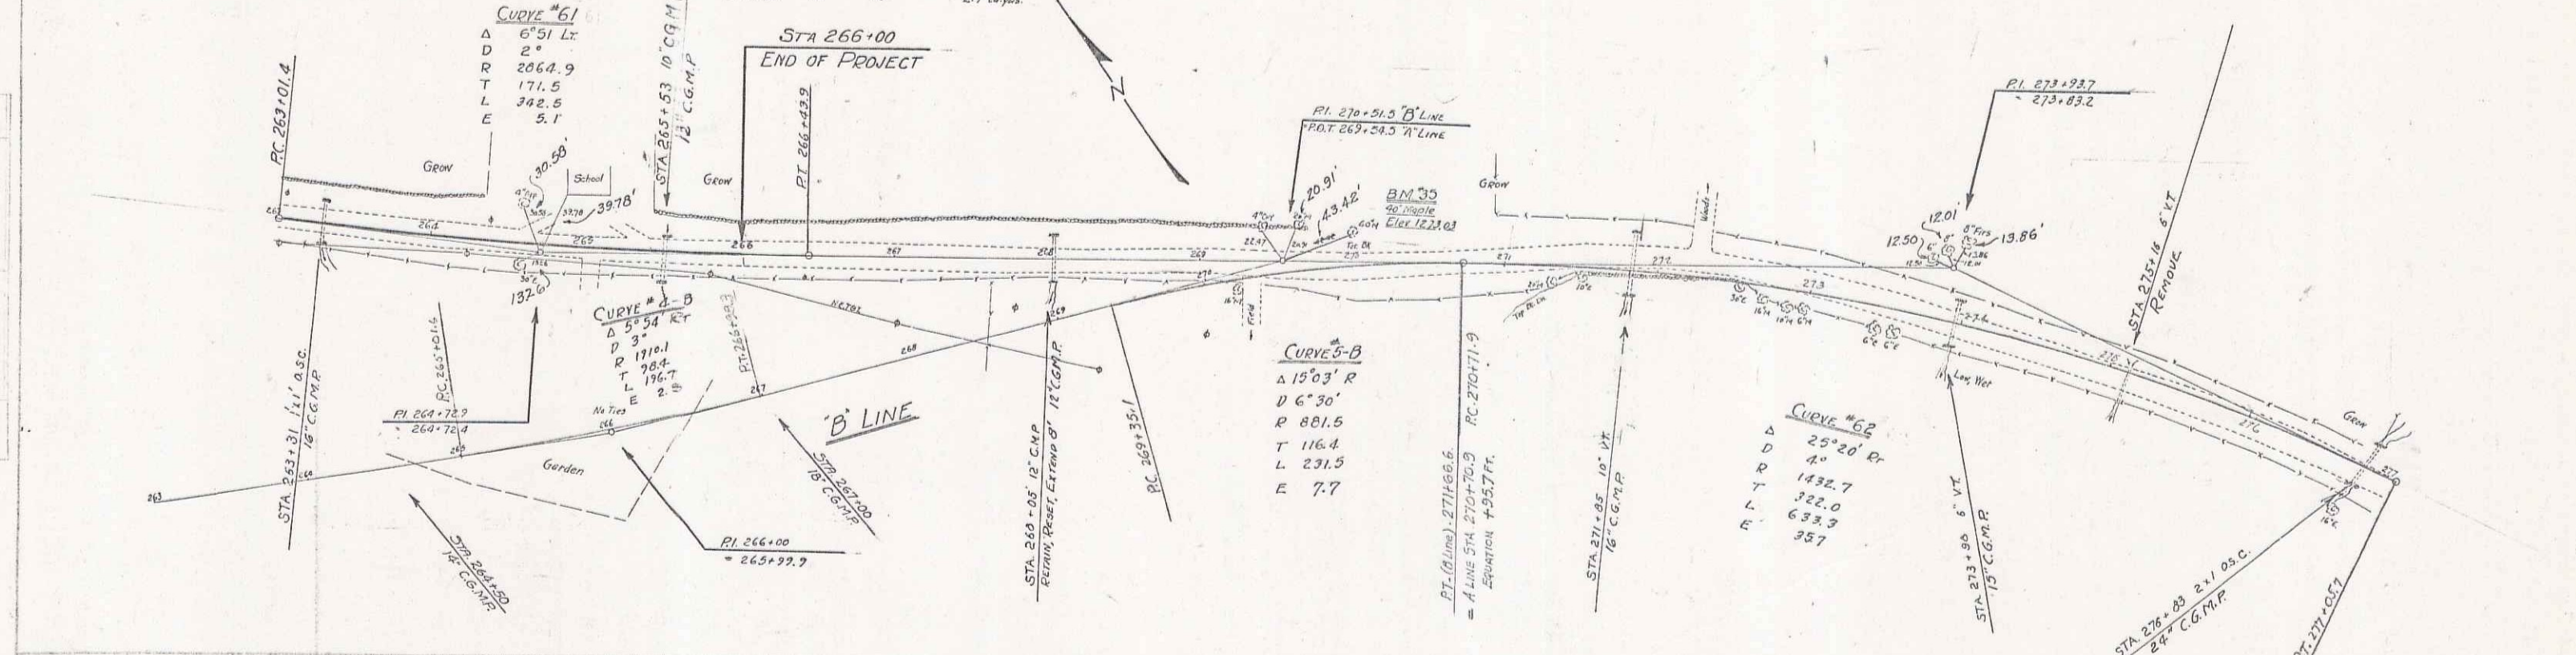

PLAN
DATE
BY
CHECKED
DATE

PLAN
DATE
BY
CHECKED
DATE

B.M. 35 46 Maple Sta. 269+99 L.H. Elev. 1273.03