

WOODEN GUARD RAIL REQUIRED
ON LEFT
Sta 2700 to 2810 Length 110 FT
ON RIGHT
Sta 2810 to 2817 Length 7 FT


NEW CULVERTS REQUIRED
Sta 2815 3x3 Reinforced Concrete Box
1-2'4" Concrete 37 cu yd
1-2'6" Concrete 12.0
Reinforcing Steel 130 lb

SUB-BASE REQUIRED
Sta 2700 to Sta 3310 Length 610 FT

PLAN	SECTION	ADJUSTED	FOOTING	SHEET	TOTAL
1	1	1	1	5	45

E.P. WELCH
 D.L. LUND
 3/12/23

E.P. WELCH
 R.H. PHIPPS
 3/12/23

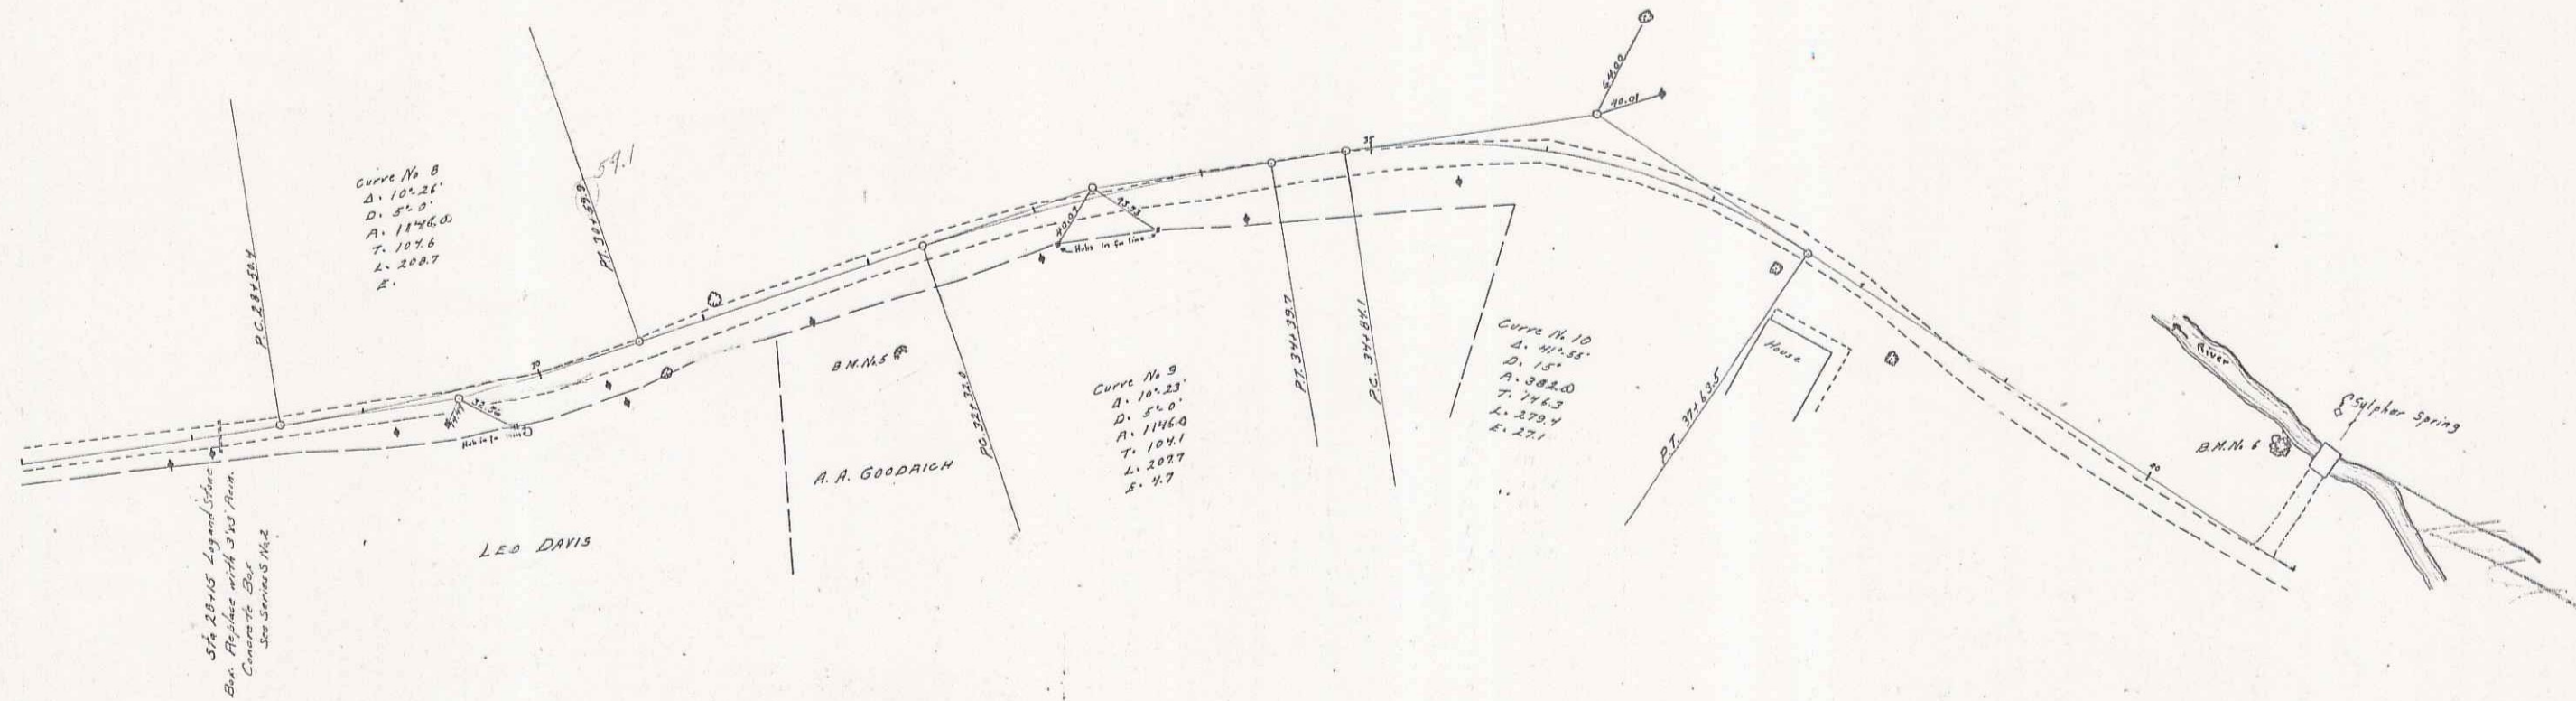

Series No. 011
 Sheet 5 of 5
 5145