

WOODEN GUARD RAIL REQUIRED

ON LEFT			
Sta.	To Sta.	Length	24 FT.
57166	57190	24	
59152	60496	144	
61116	63726	258	
70400	73700	300	

ON RIGHT			
Sta.	To Sta.	Length	24 FT.
57166	57190	24	
60492	60496	4	
64100	64123	23	

TOTAL THIS SHEET 956 FT.



NEW CULVERTS REQUIRED

Sta. 57178	18" Cor. Iron Pipe Length 30 FT.
Sta. 60184	24" Reinforced Concrete Box 1-2-4 Concrete 3.3 cu yd. 1-2-5 Concrete 2.1 Reinforcing Steel 124 lb.
Sta. 65111	36" Reinforced Concrete Box 1-2-4 Concrete 4.4 cu yd. 1-2-5 Concrete 13.5 Reinforcing Steel 219 lb.

DATE	BY	SCALE	SHEET
8/11		1" = 40'	7

ERWING
D. L. LIND
3/19/23

ERWING
D. L. LIND
3/19/23

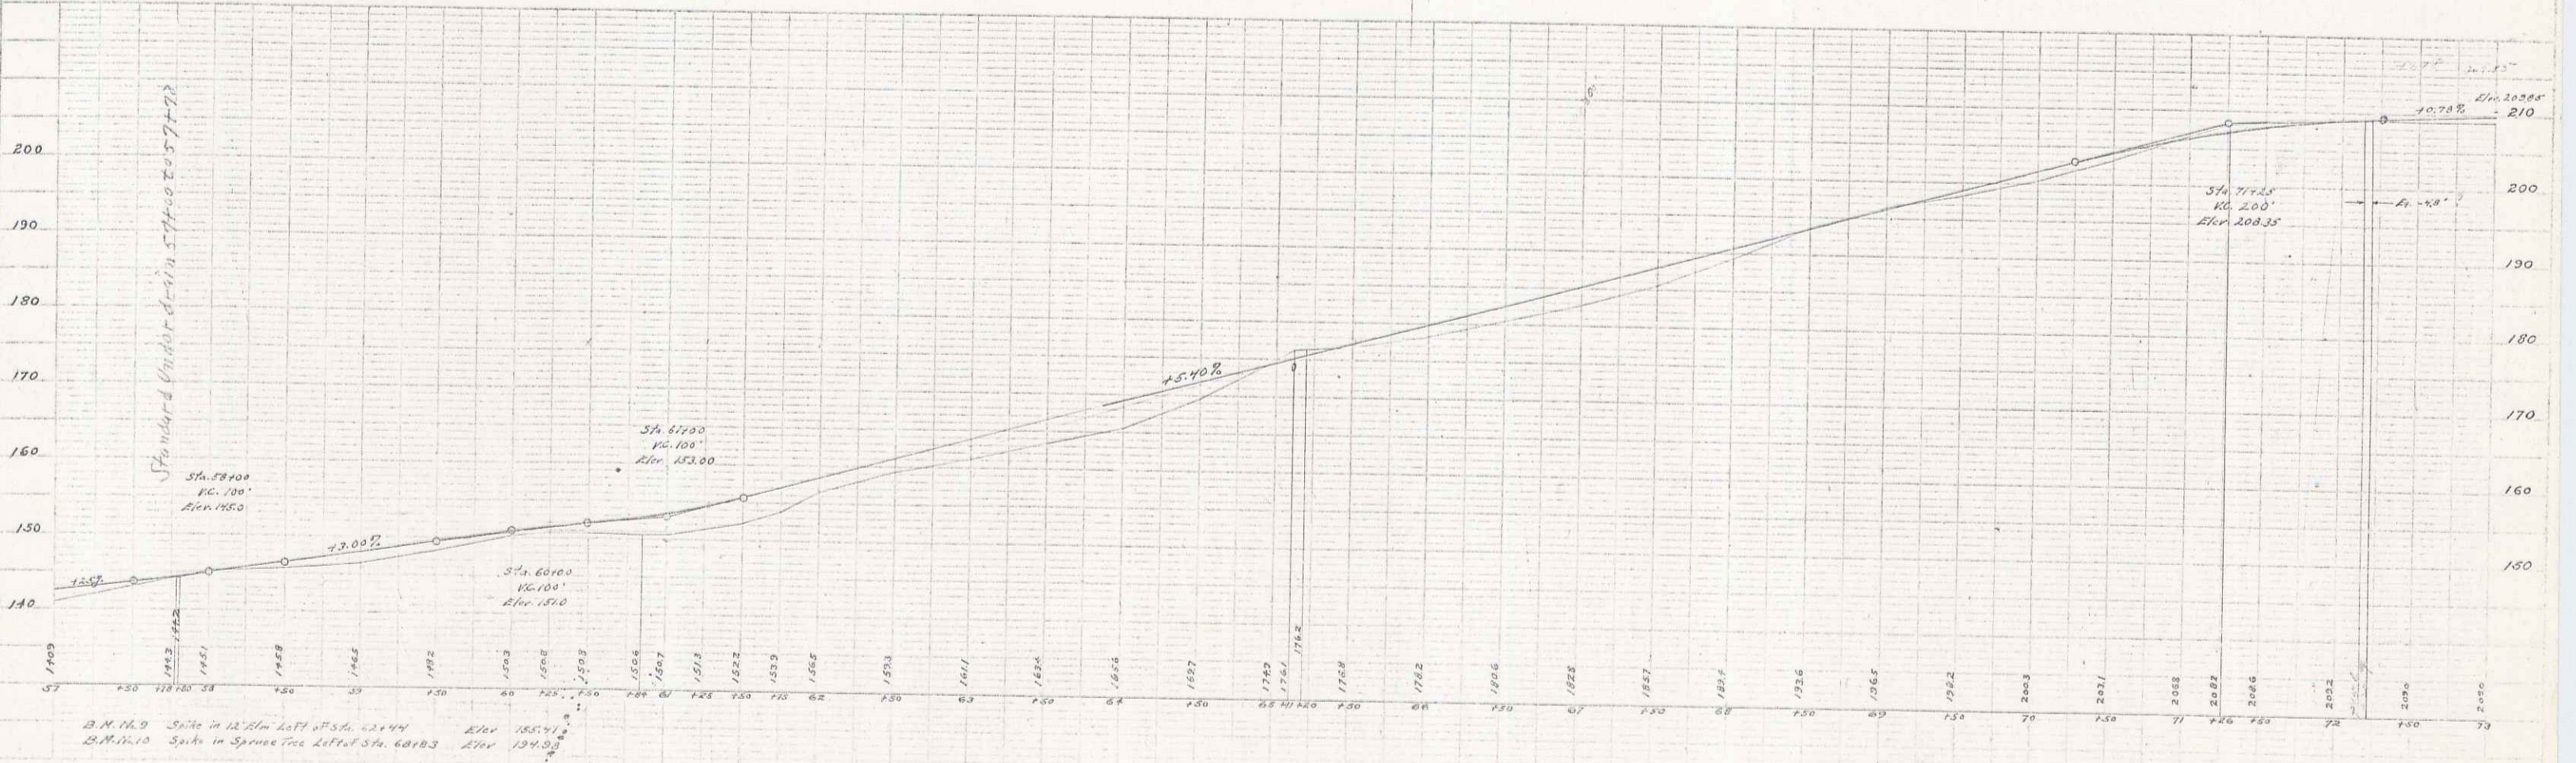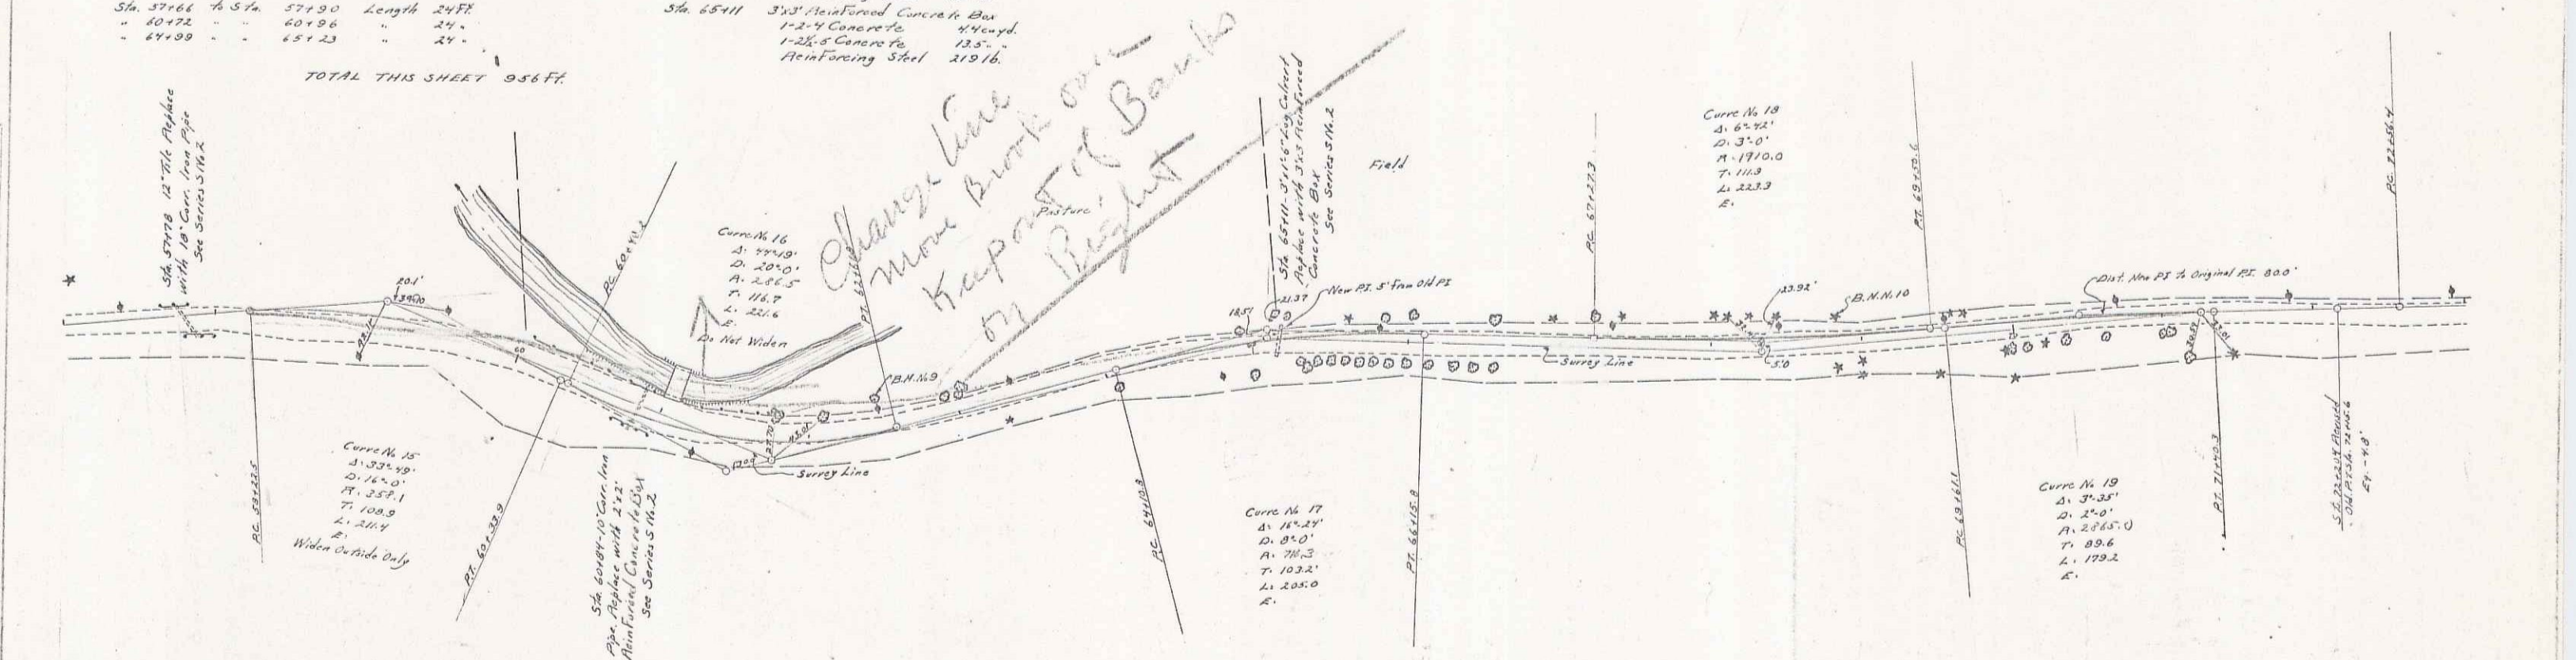

Series F.M. 918
Sheet 7 of 145