
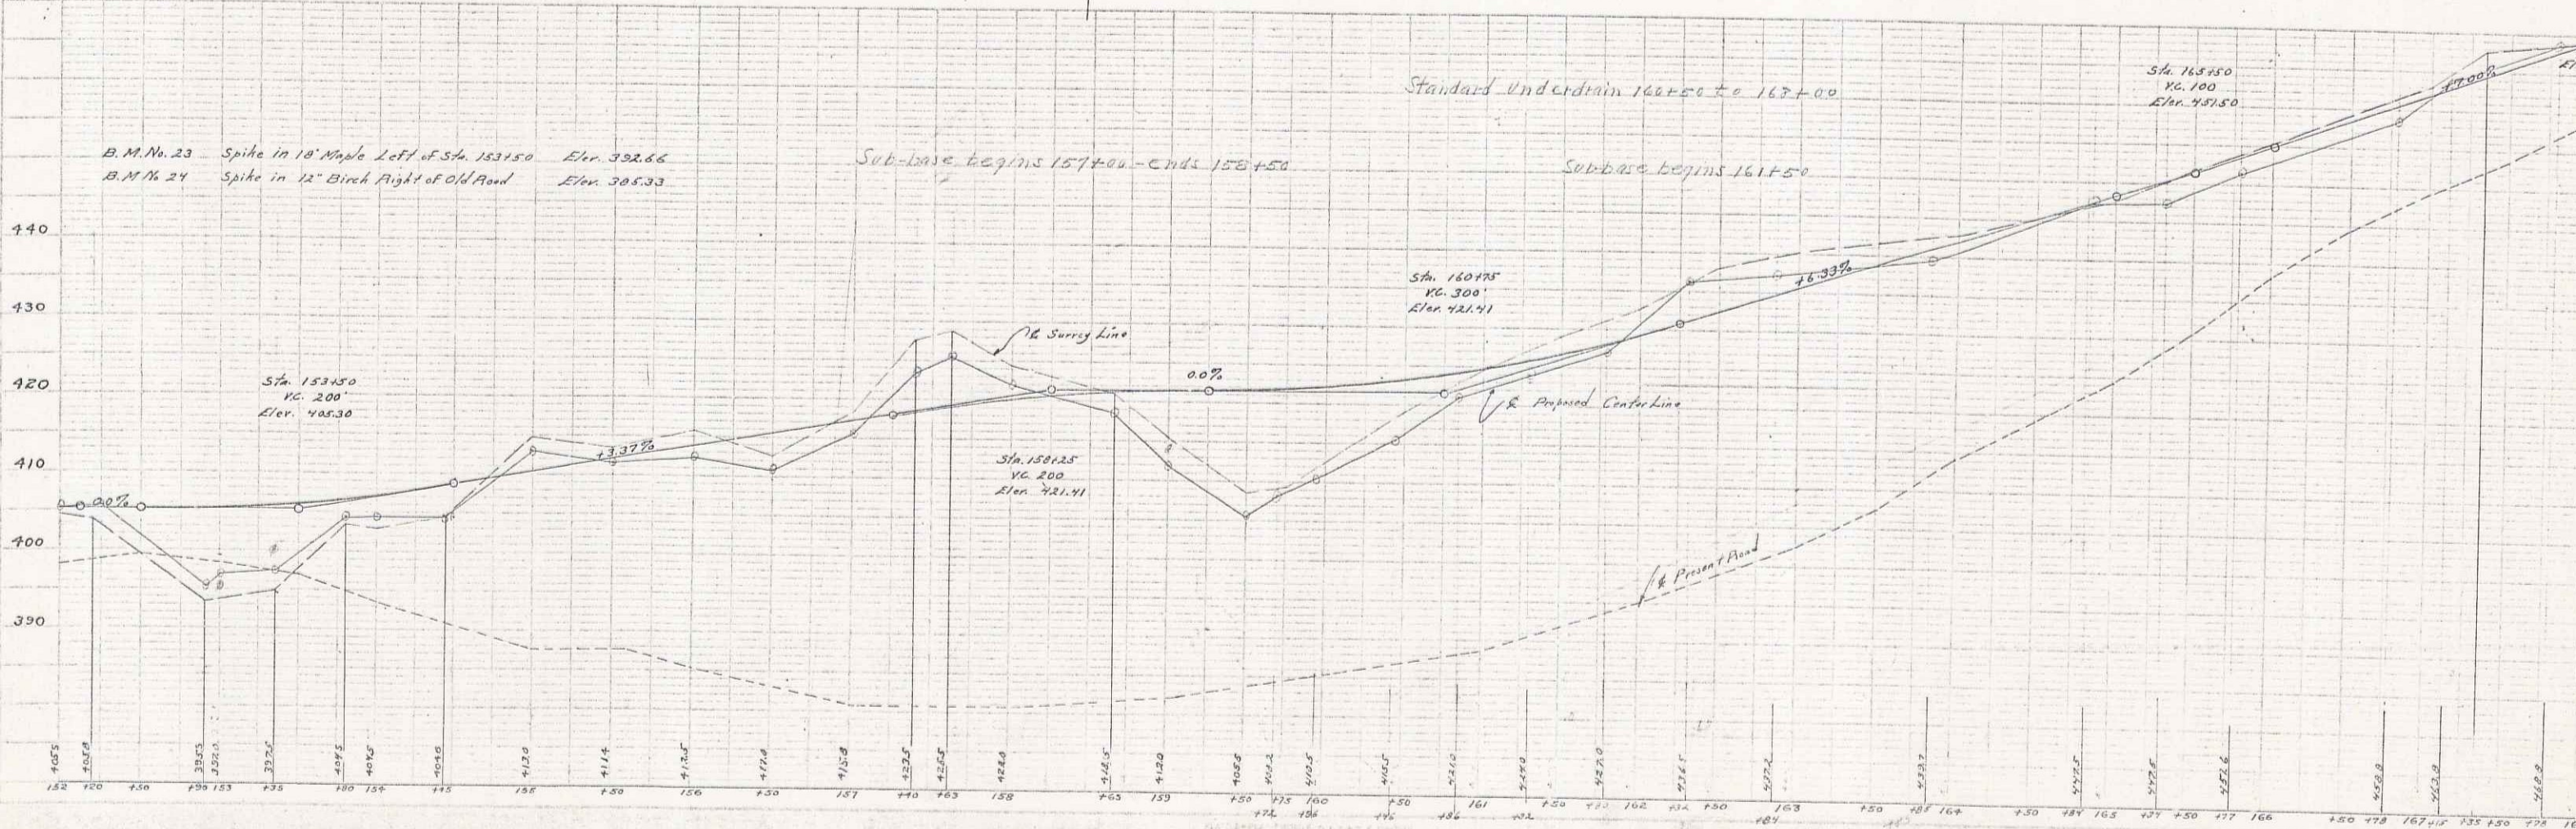


PLAN
 E. R. GAW
 S. L. LIND
 11/17/23

PROFILE
 E. R. GAW
 S. L. LIND
 G. H. COOK
 11/17/23

FEED	ROAD	STATES	FEED	ADJ	PIED	TO	ADJ	TOTAL
157+00	157+00	157+00	157+00	157+00	157+00	157+00	157+00	157+00

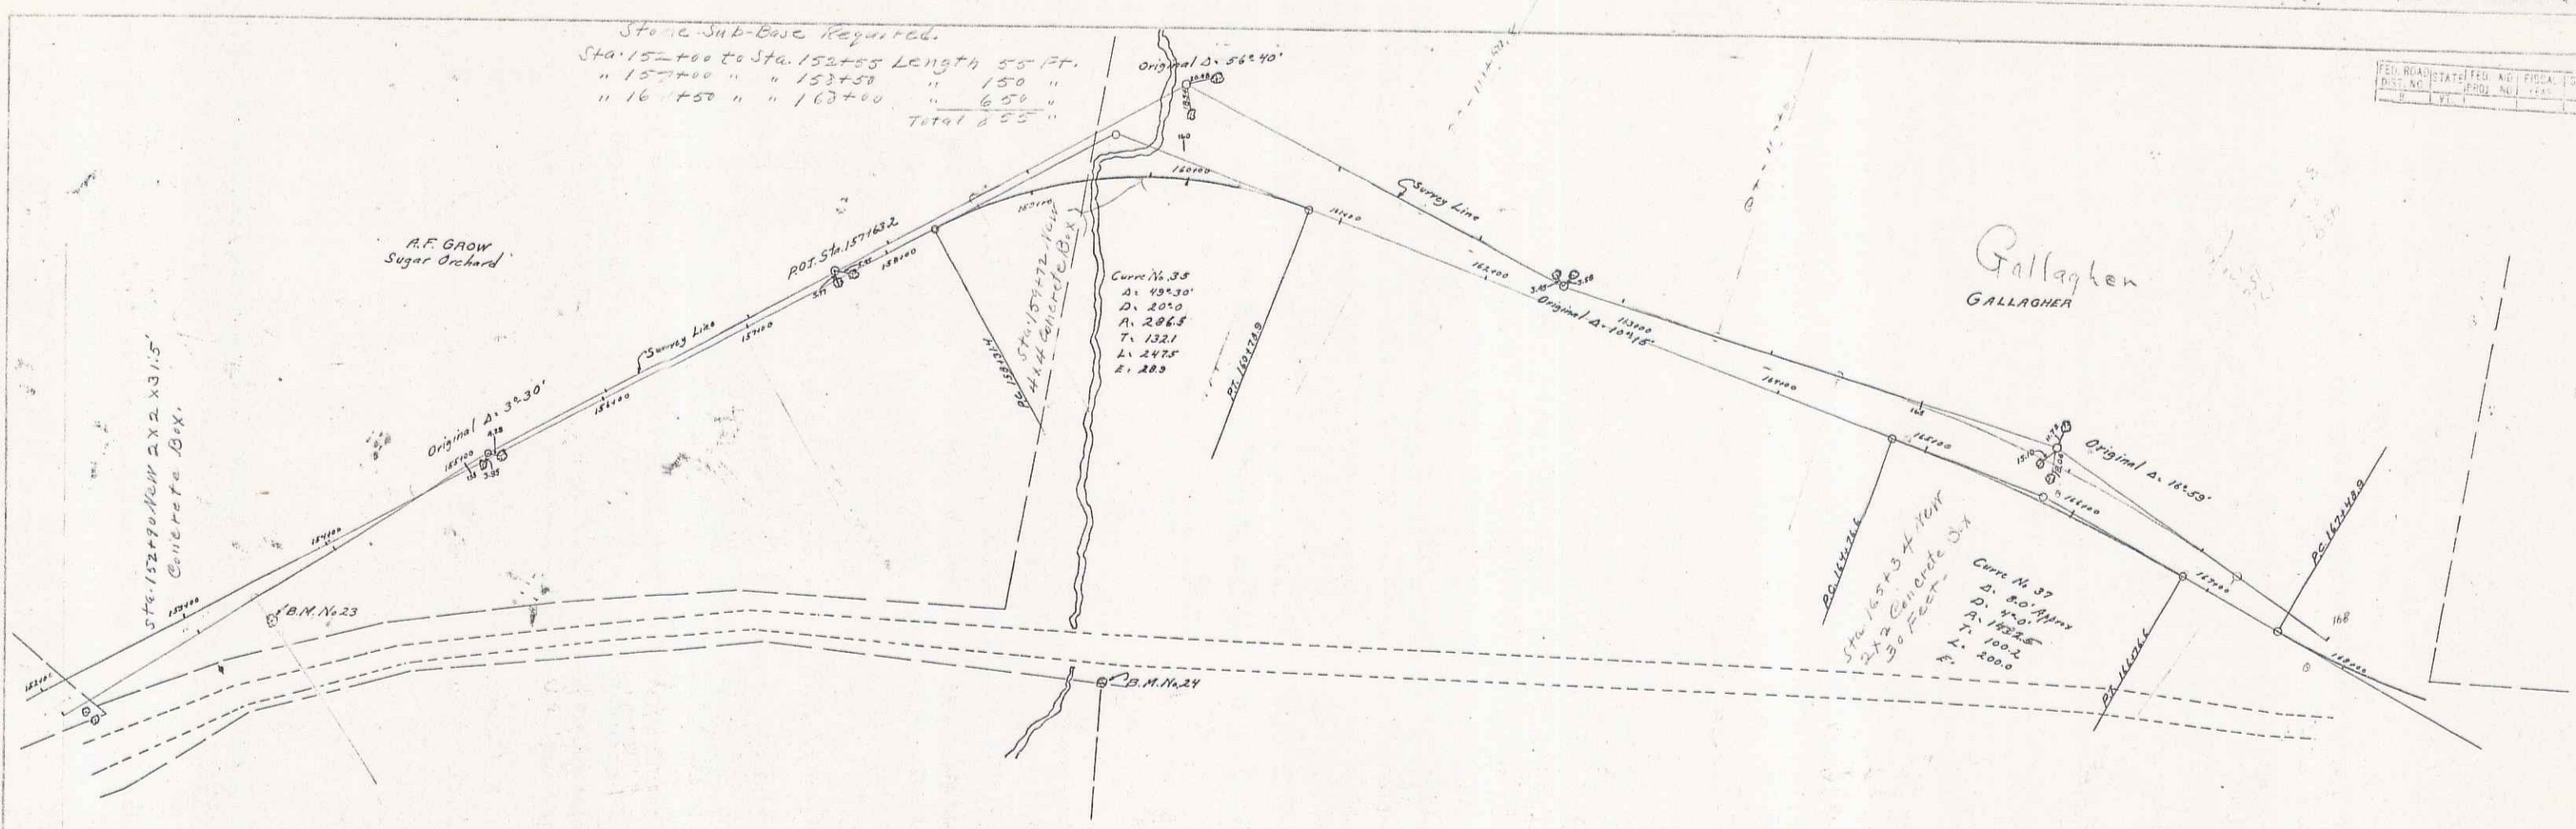

13 of 45 41