


PARCEL	KIND OF INSTRUMENT	DATE OF INSTRUMENT	GRANTOR	GRANTEE	RECORDED WALDEN	REMARKS
ABCD	RCD	2-19-37	MAREL W. WHITE	ST. OF VT	BOOK PAGE DATE 23 197-B 7-1-37	CUL 7 STA 135+00

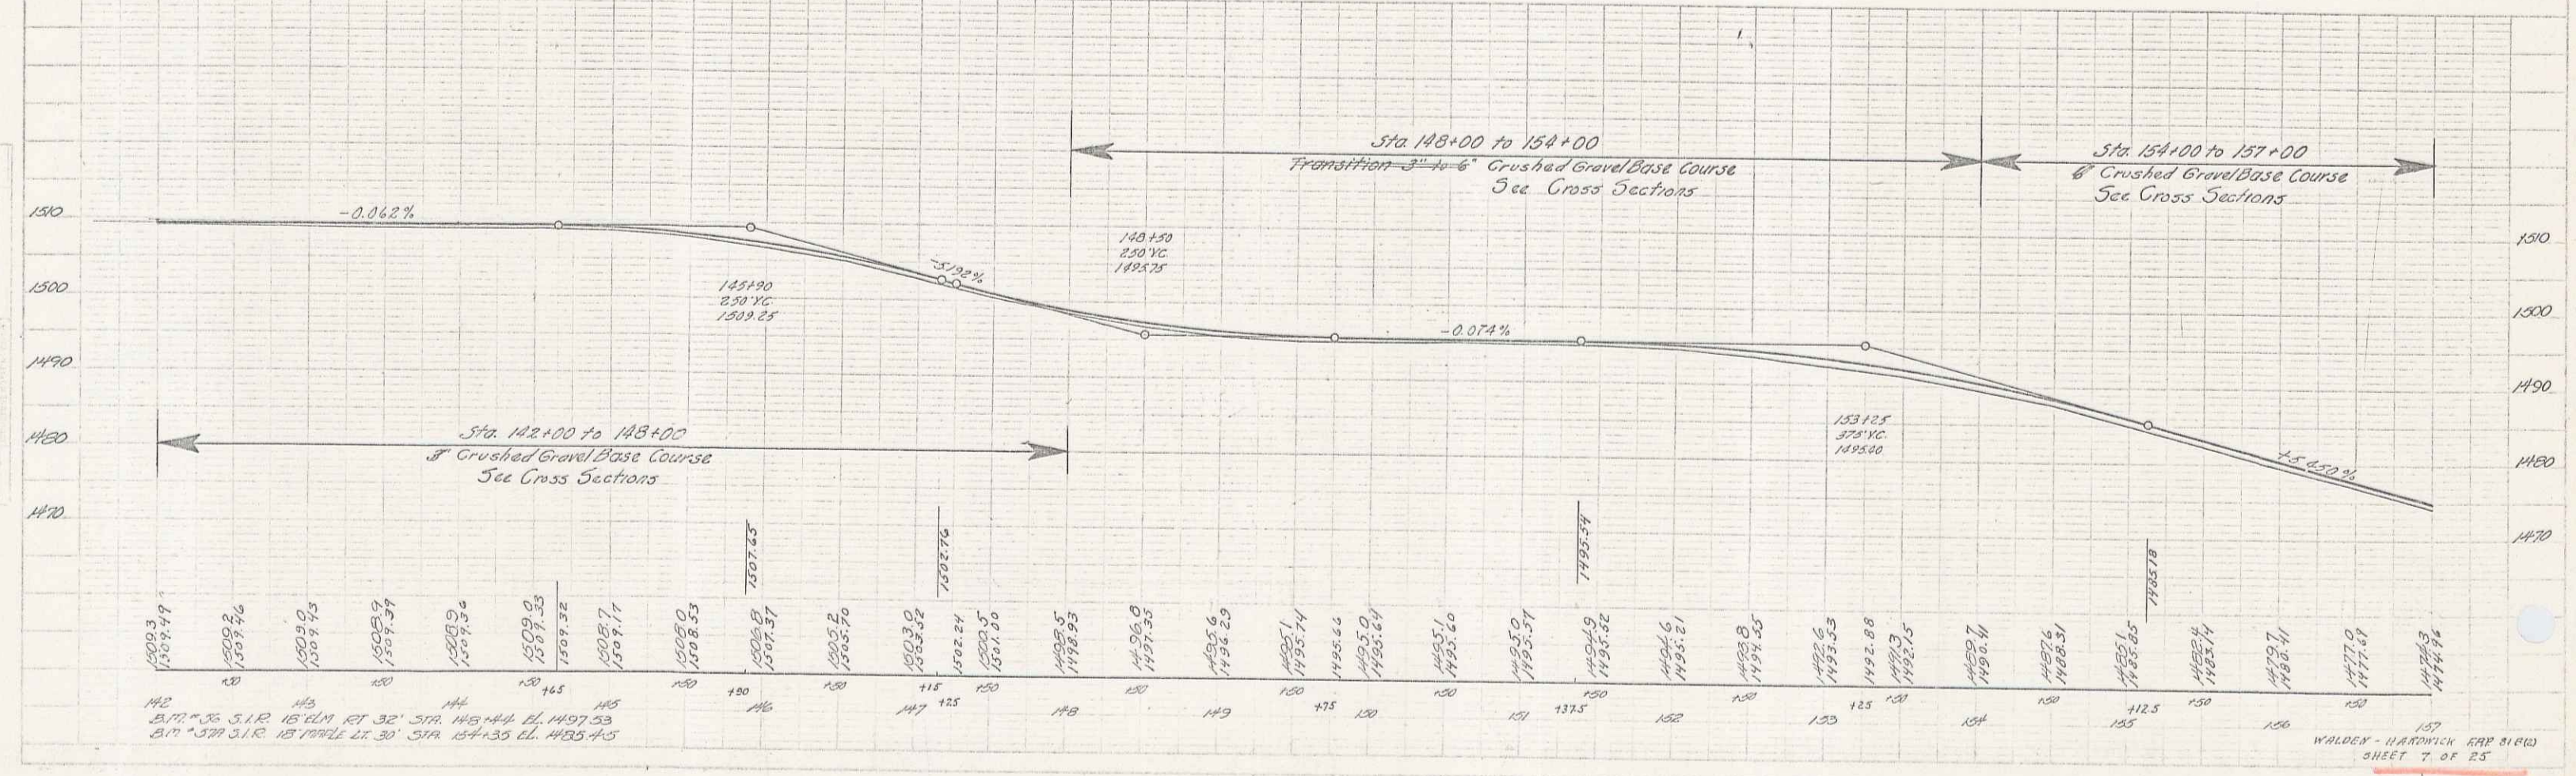

5