
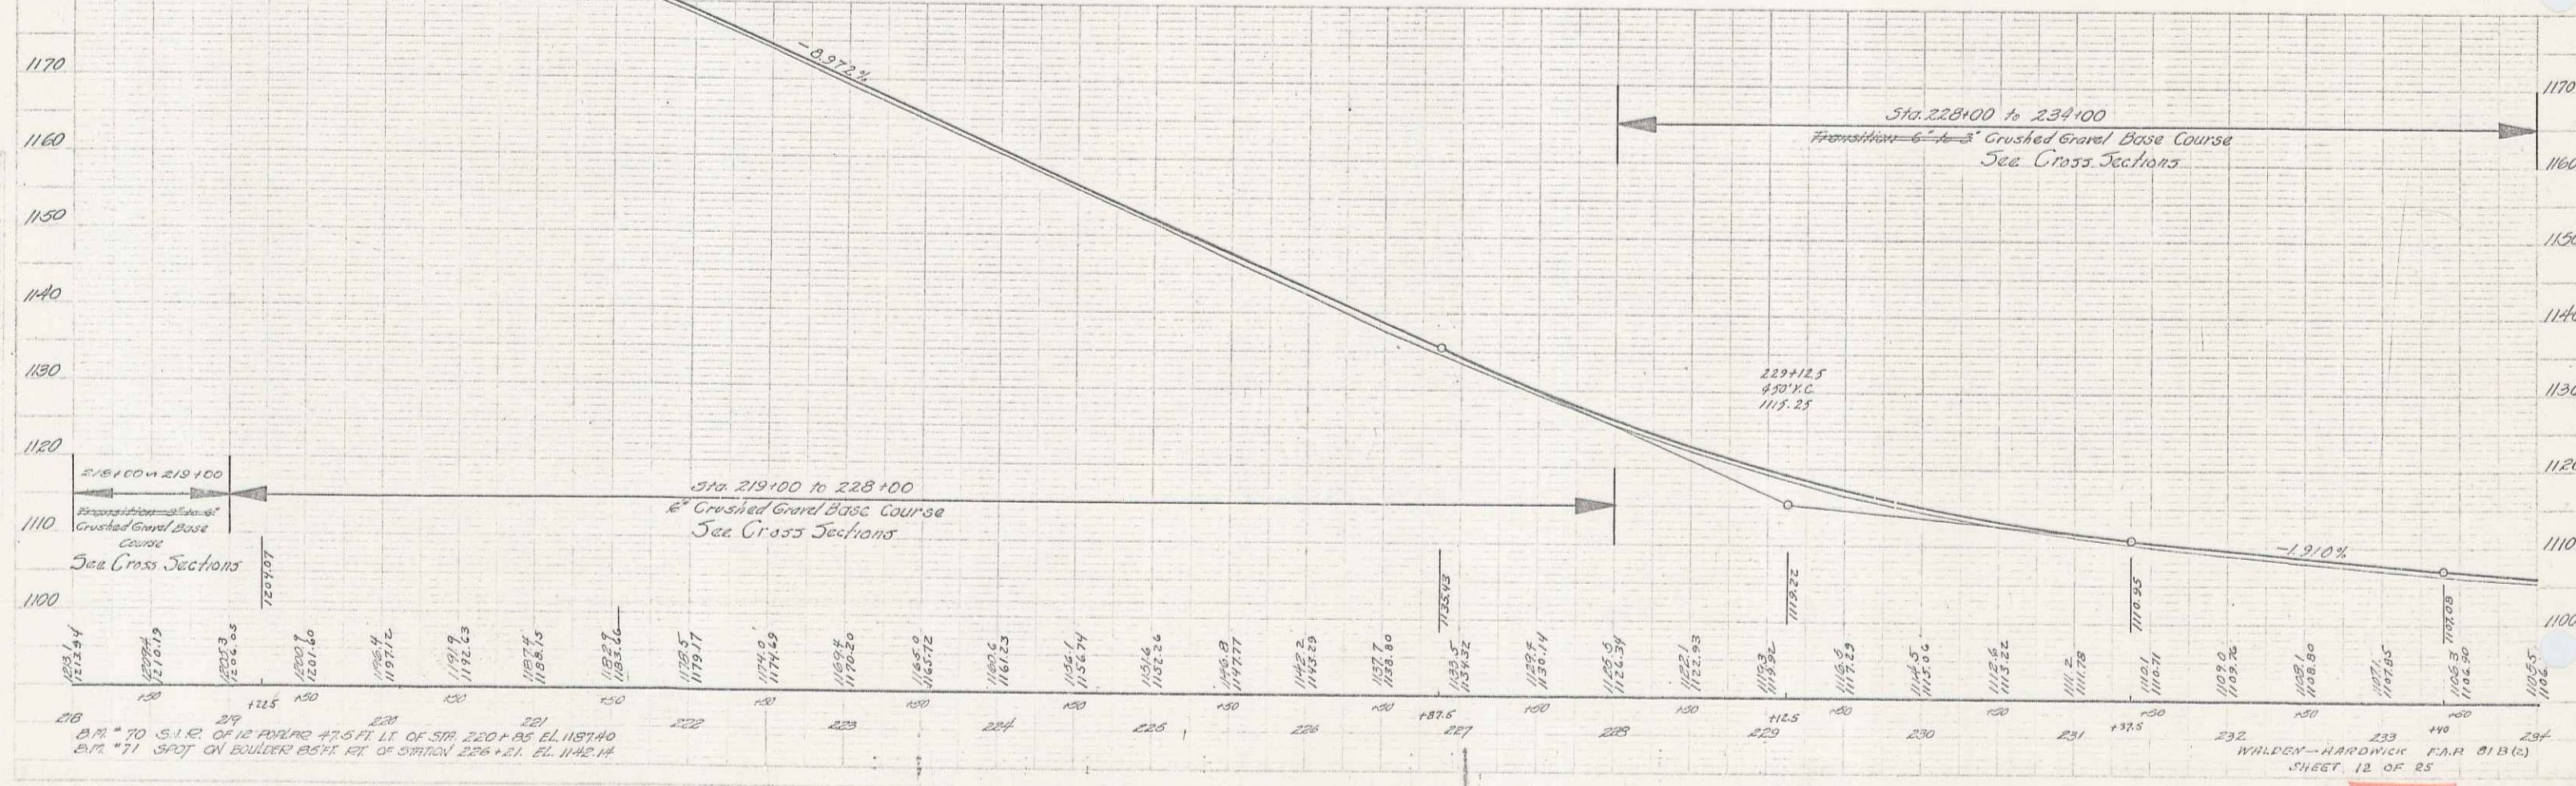


B187 1940 12 25

PARCEL KIND OR INSTRUMENT	DATE OF INSTRUMENT	GRANTOR	GRANTEE	RECORDED WALDEN	DATE	REMARKS
A.B. O.C.D.	1-28-37	ROY C. GOODENOUGH	3 of vt.	BRK 23	1812 2537	

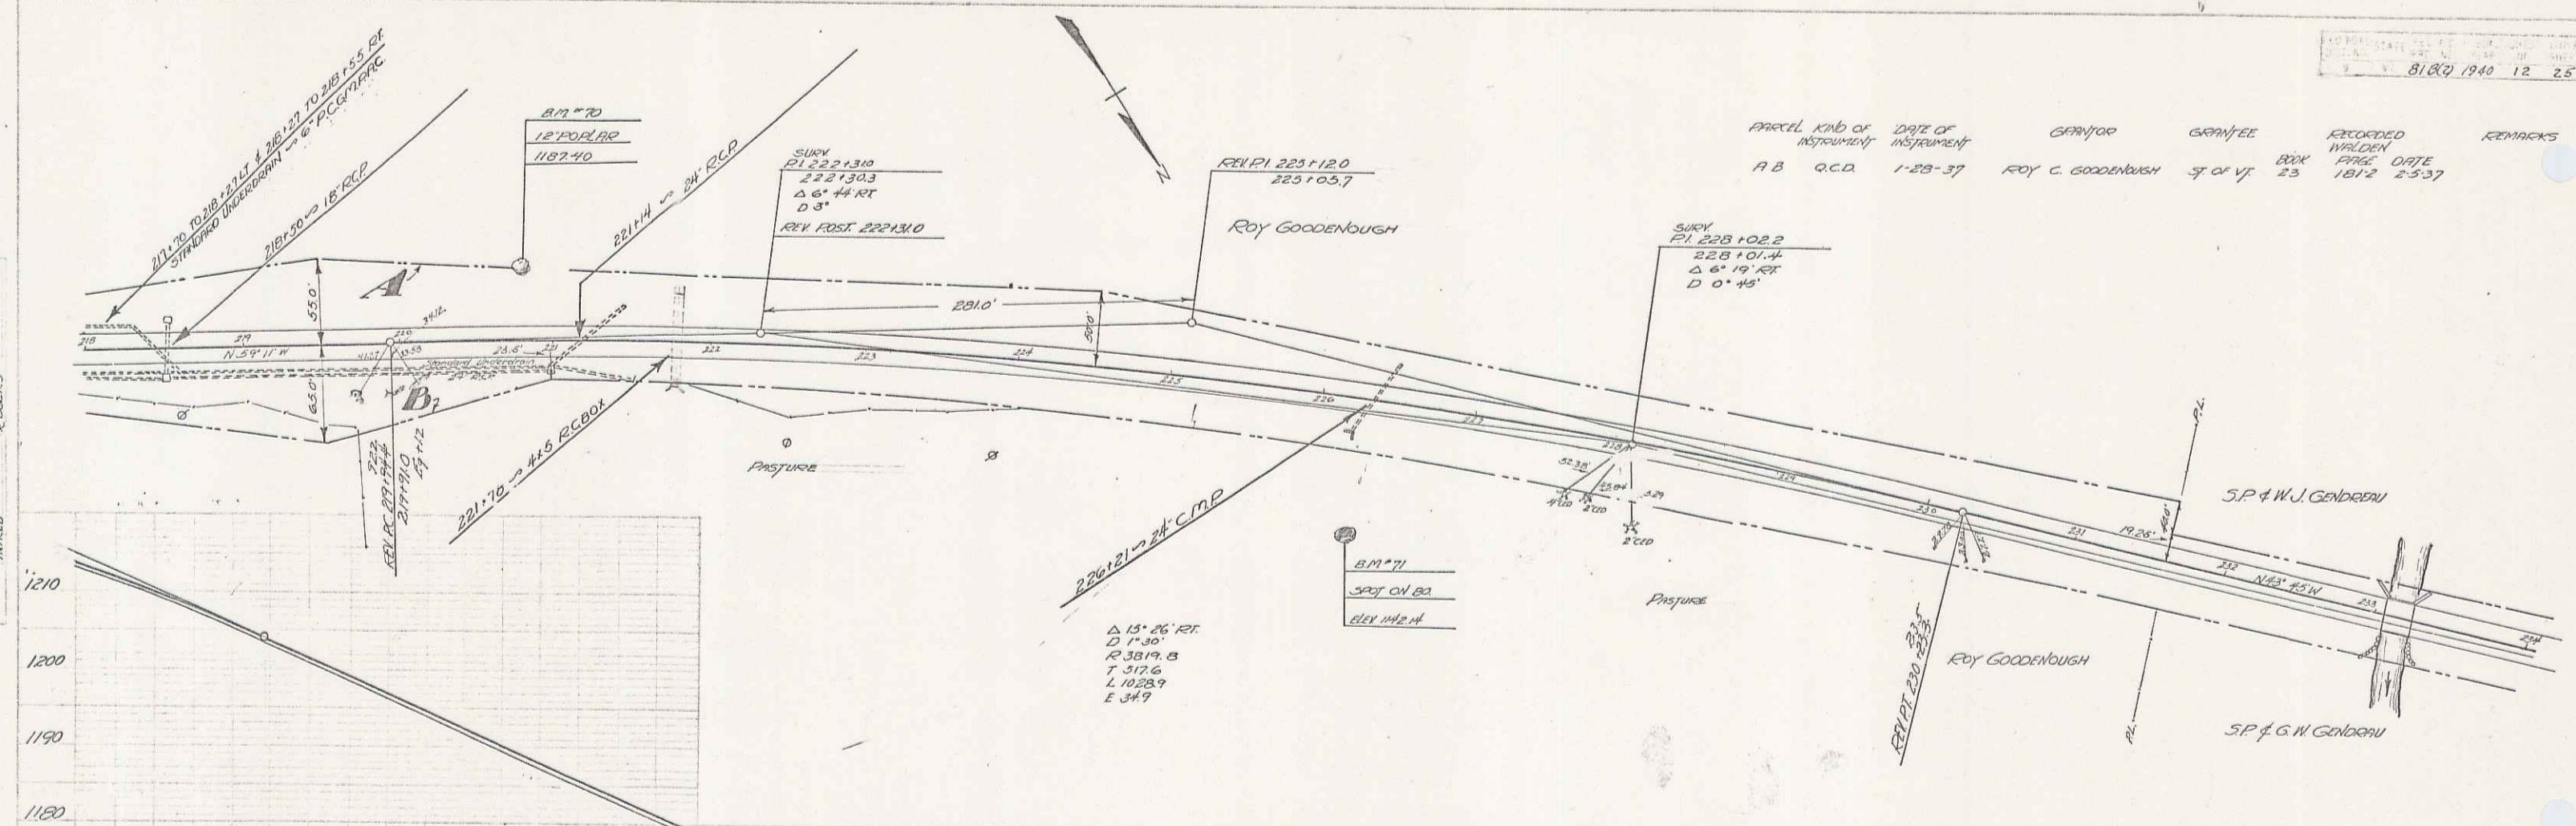

218+00 to 219+00
 219+00 to 228+00
 228+00 to 234+00

WALDEN-HARDWICK F.A.R. #116 (2)
 SHEET 12 OF 25