


PARCEL	KIND OF INSTRUMENT	DATE OF INSTRUMENT	GRANTOR	GRANTEE	RECORDED WALDEN	REMARKS
ABCDE	O.C.D.	6-3-37	S.P. & W.J. Gendreau	ST. OF VT.	BOOK PAGE DATE	
"	"	5-26-37	ED. LAND BANK	"	23 185-6 7-1-37	
"	"	5-26-37	ED. LAND BANK	"	23 185-4 7-1-37	
"	"	5-26-37	ED. LAND BANK	"	23 191-3 7-1-37	

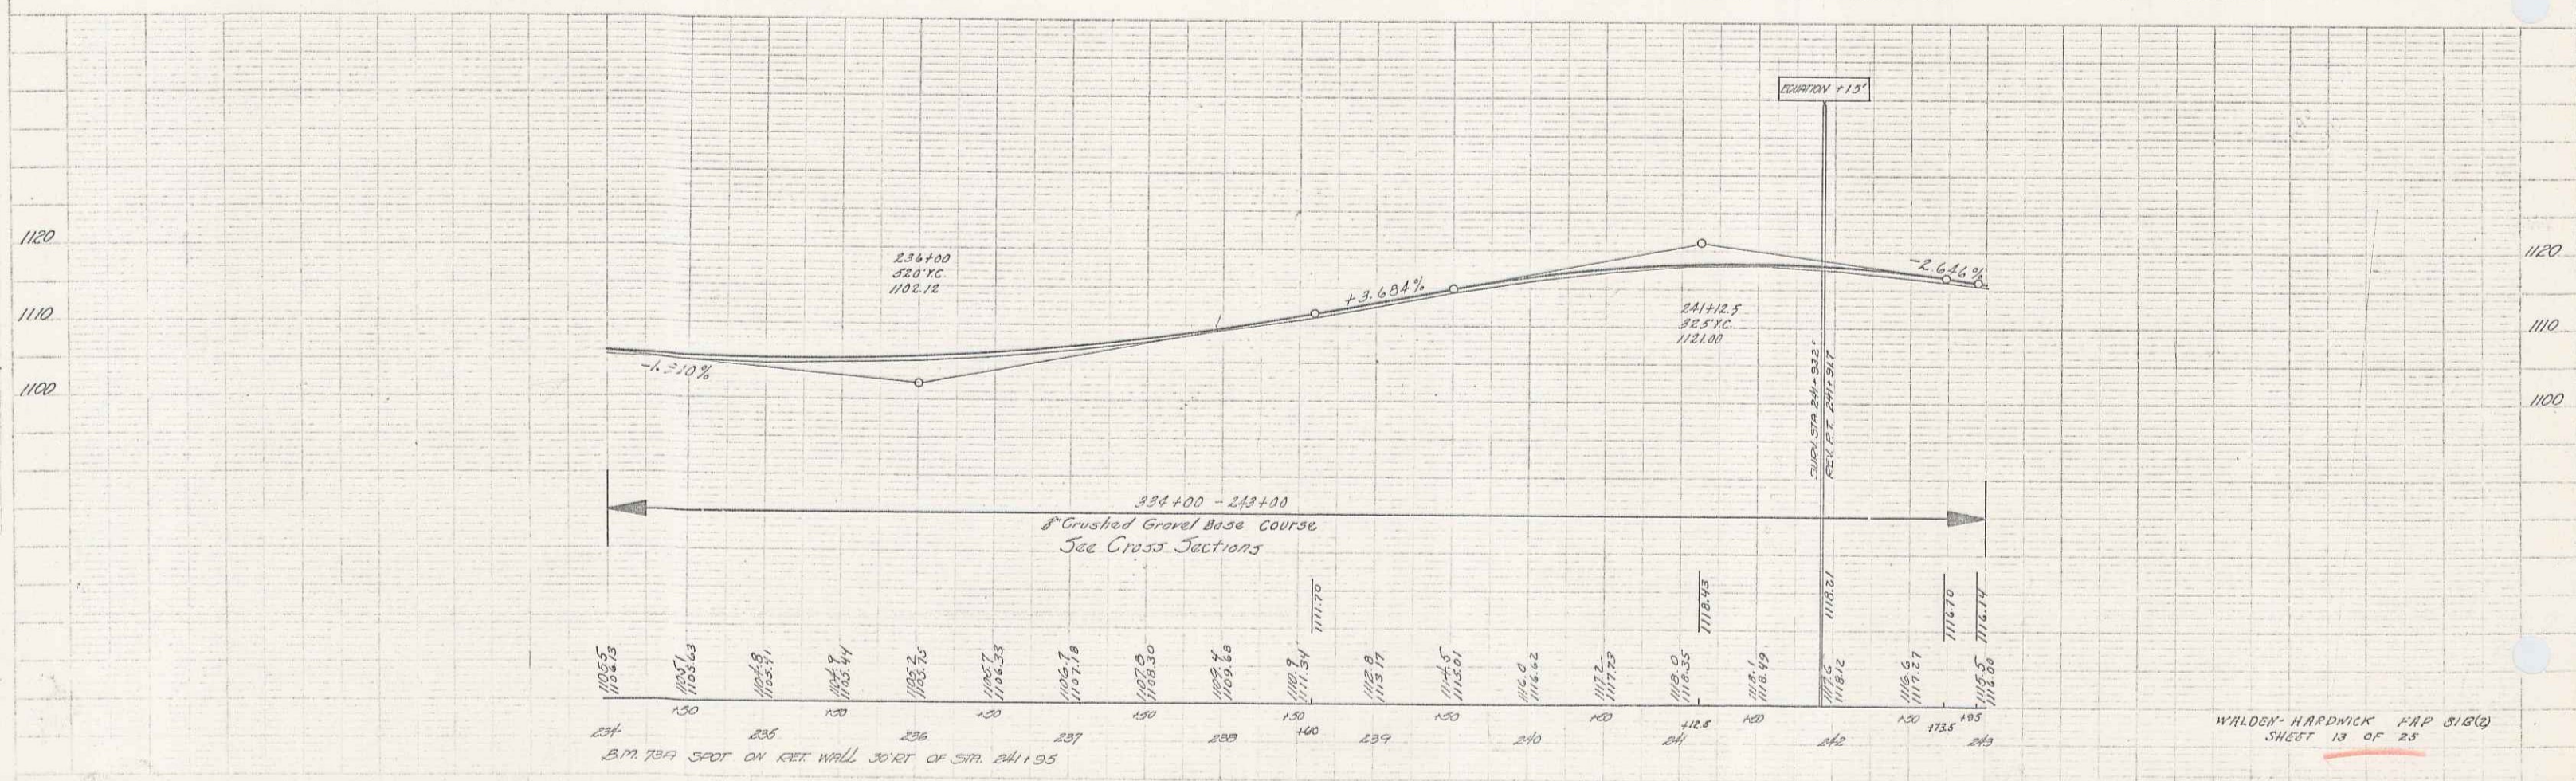

WALDEN-HARDWICK MAP 516(C)
SHEET 13 OF 25