


$\Delta$  H-401K  
 $D = 5^\circ$   
 $R = 1146.3$   
 $T = 187.5$   
 $L = 293.3$   
 $E = 35$

PARCEL	KIND OF INSTRUMENT	DATE OF INSTRUMENT	GRANTOR	GRANTEE	RECORDED	REMARKS
A B C D	QCD	2-12-37	RENE & RENEE GUILLET	SR OF VT.	BOOK PAGE DATE	
A B	CONVEY DEED	3-30-37	FEDERAL BANK	SR OF VT.	36 67-18 1-17-34	

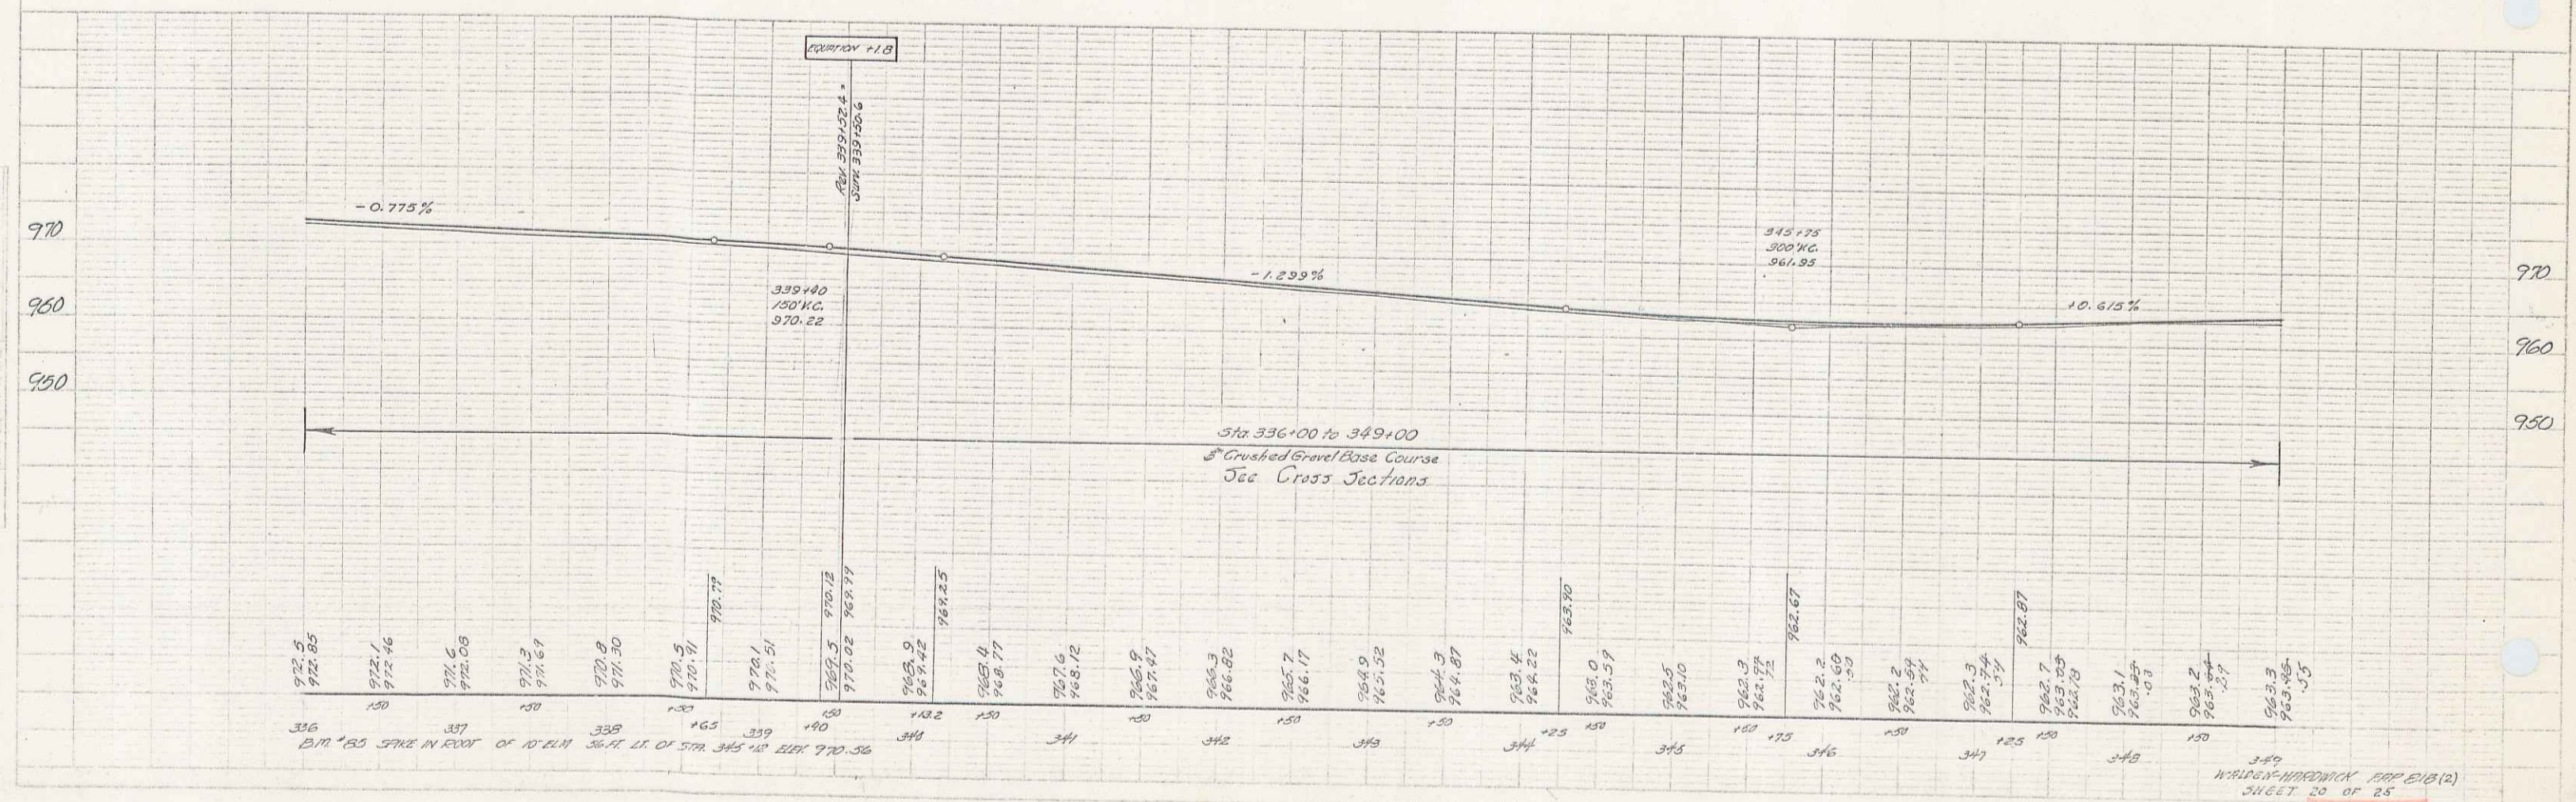

Station	Elevation
336	922.5
336	922.85
337	922.46
337	922.06
338	921.69
338	921.30
339	920.91
339	920.51
340	920.12
340	919.72
341	919.32
341	918.92
342	918.52
342	918.12
343	917.72
343	917.32
344	916.92
344	916.52
345	916.12
345	915.72
346	915.32
346	914.92
347	914.52
347	914.12
348	913.72
348	913.32
349	912.92
349	912.52

349  
 WINDY-HAYNESVILLE MAP 618(2)  
 SHEET 20 OF 25