


8184 1940 21 25

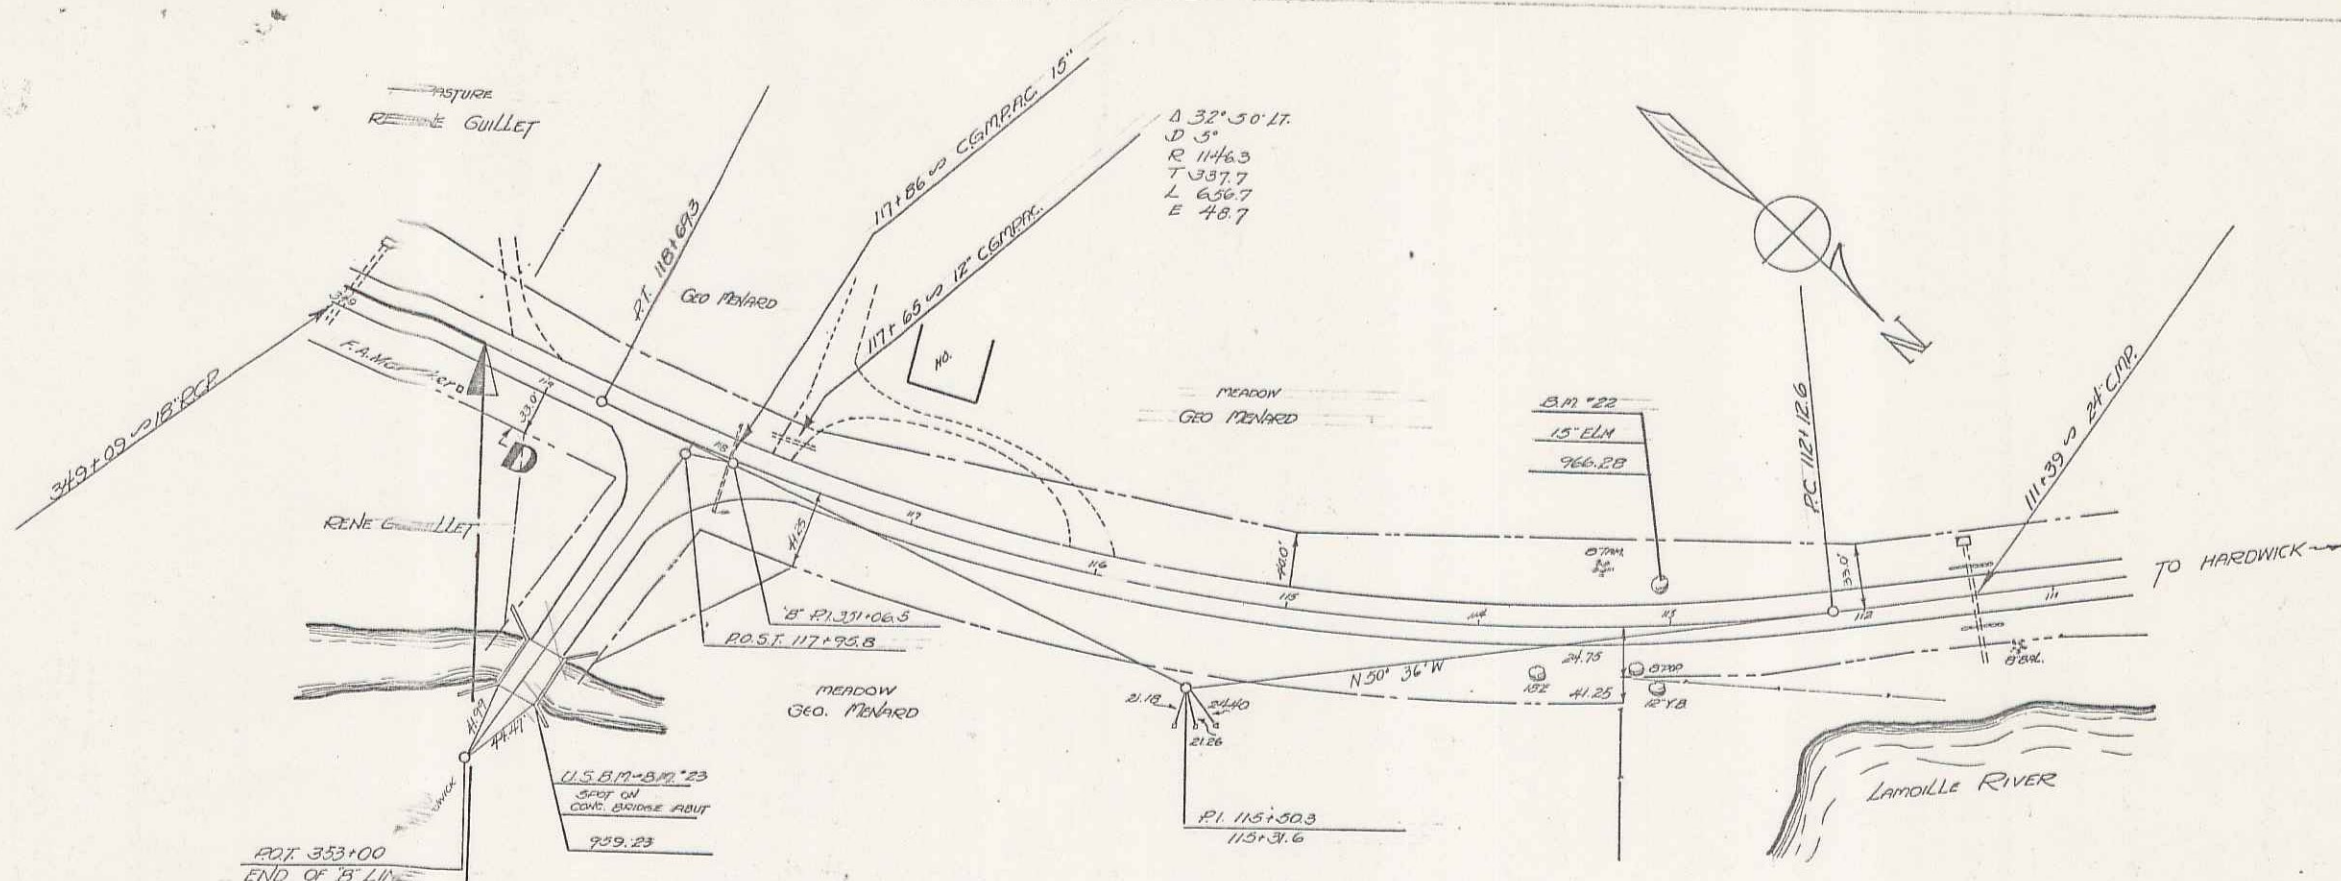

INSTR.	KIND OF INSTRUMENT	DATE OF INSTRUMENT	GEOMETER	GRANTEE	RECORDED	REMARKS
ABCD	O.C.D.	2-12-37	Rene Gullet Gullet	STATE	34	1965-66 2-10-37

Sta 349+613  
END OF PRODUCT RAR E 50'

Sta 119+382  
END OF PRODUCT RAR B1A(C)



Sta 349+00 to 349+613  
Crushed Stone Base Course  
See Cross Sections

963.3	965.4	967.4	969.4	1111.4																																																																													
349	150	149	148	0

WINDSOR-HARDWICK, RAR B1A(C)  
SHEET 21 OF 25