
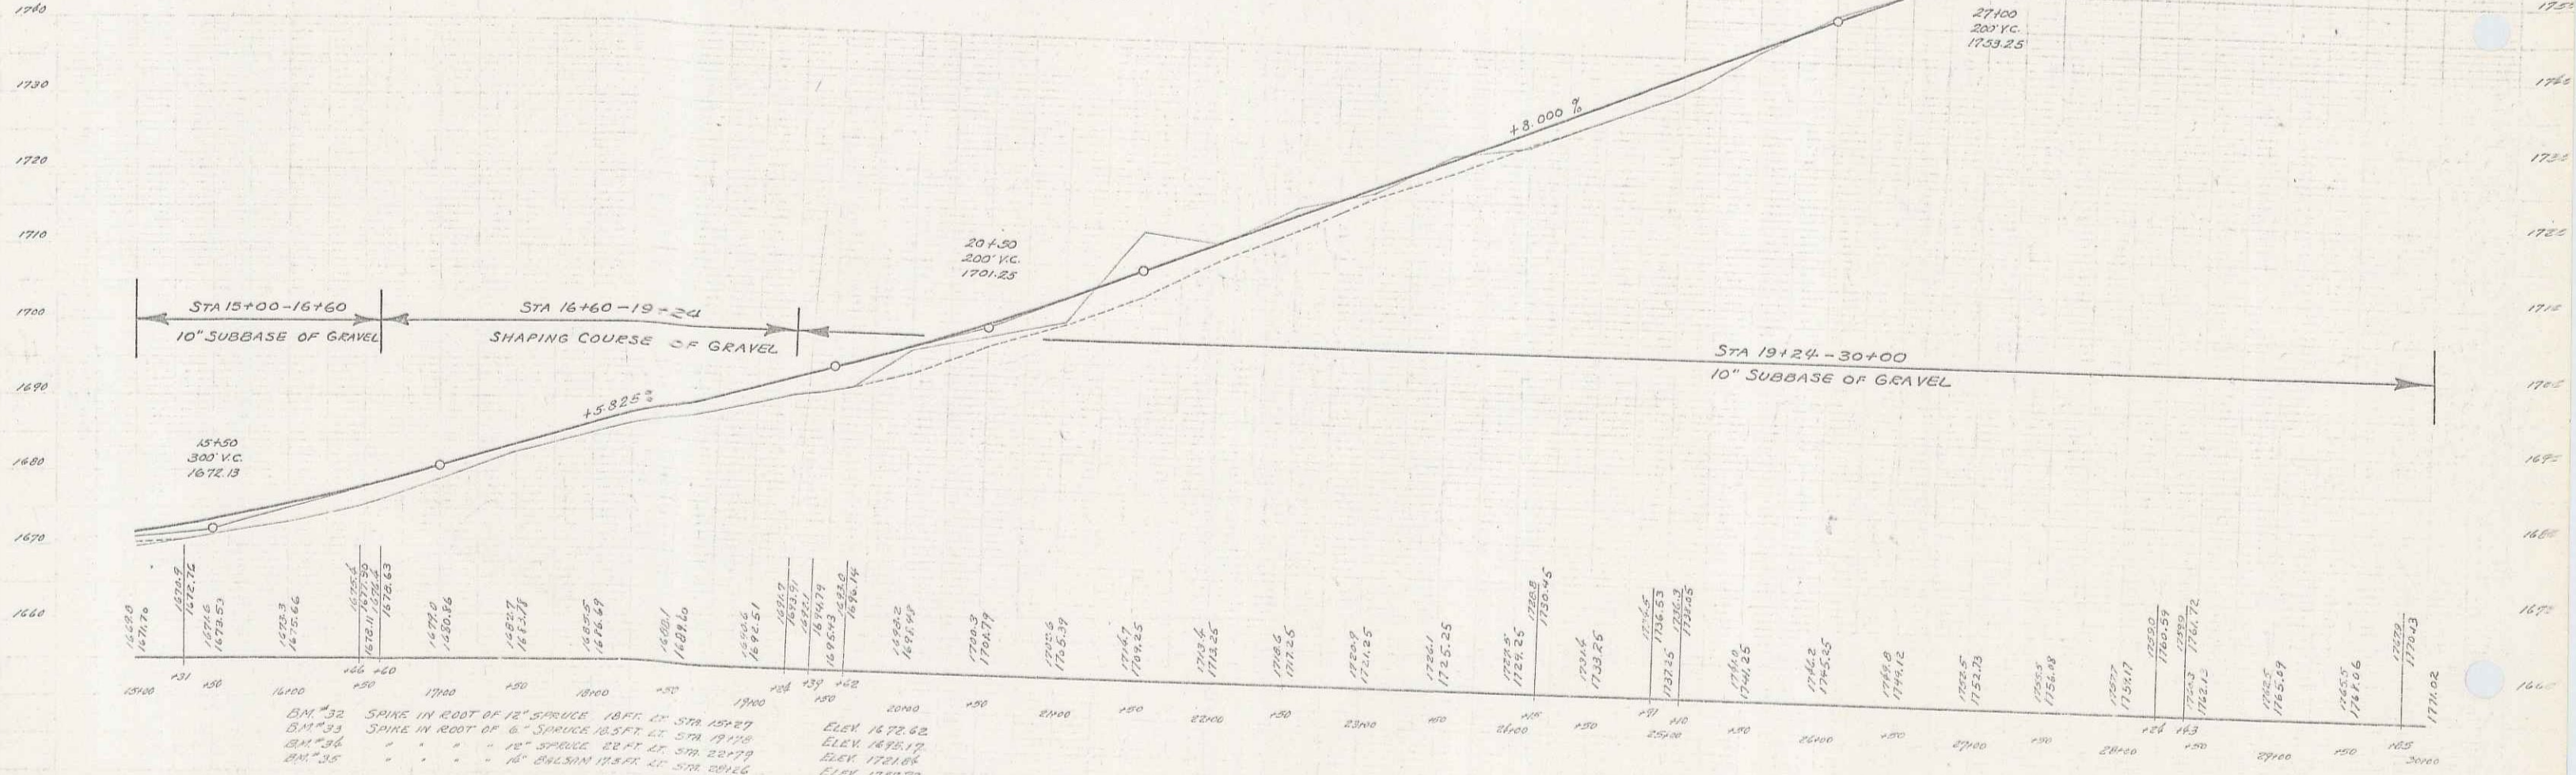


F.P.D. 81-G			
Wood Guard Riv.			
STATION	SPACING	LT	RT
1672.13	12'	32'	32'
1672.13	12'	32'	32'
1672.13	12'	32'	32'
1672.13	12'	32'	32'

F.P.D. 81-G			
Grade Points			
STATION	SPACING	LT	RT
1672.13	12'	32'	32'
1672.13	12'	32'	32'
1672.13	12'	32'	32'
1672.13	12'	32'	32'

F.P.D. 81-G			
Fiscal Sheet			
NO.	DATE	BY	REVISION
1	5-12-23		

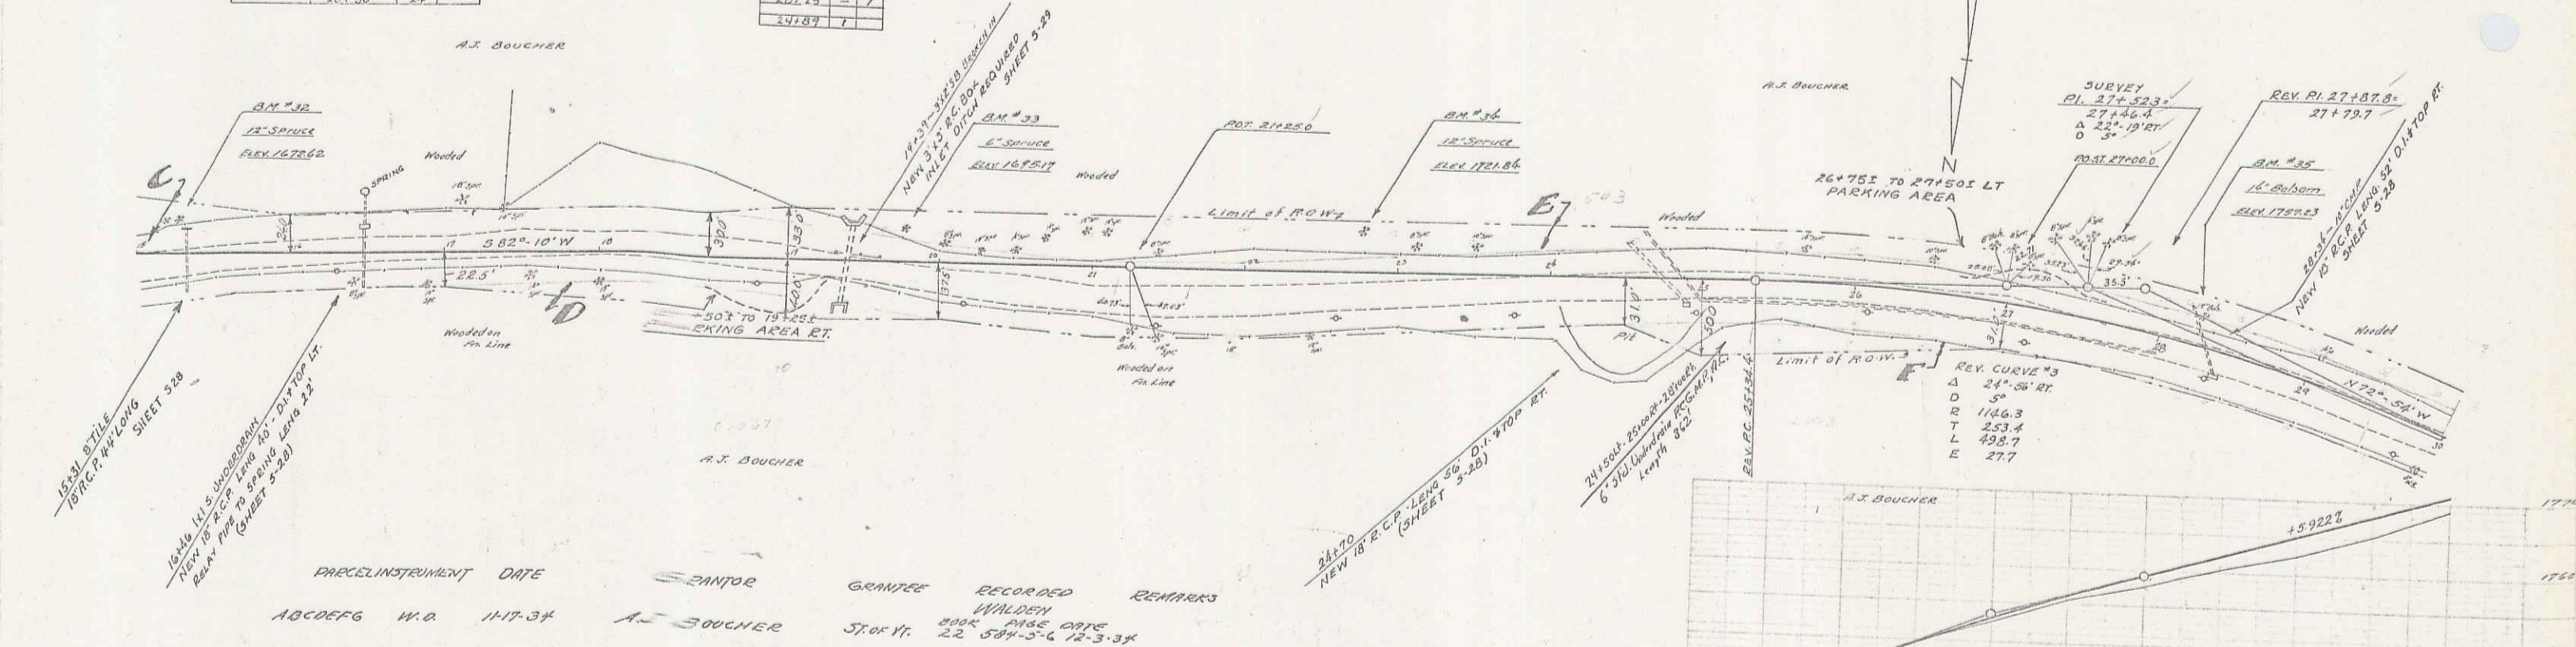

B.M. 32 SPIKE IN FOOT OF 12" SPRUCE 18 FT. IN STR. 154.27 ELEV. 1672.13
 B.M. 33 SPIKE IN FOOT OF 6" SPRUCE 12 FT. IN STR. 171.50 ELEV. 1672.13
 B.M. 34 " " " " 12" SPRUCE 22 FT. IN STR. 204.77 ELEV. 1721.84
 B.M. 35 " " " " 12" BALSAM 17.8 FT. IN STR. 204.66 ELEV. 1721.23