



F.A.P. 81-G		
Station	Station	LT
52+45	54+18	2+73

F.A.P. 81-G		
Station	Station	LT
52+45	54+18	2+73
54+18	55+10	1+22
55+10	57+00	1+90
57+00	58+10	1+10

F.A.P.			
NO.	YEAR	NO.	SHEETS
81-G	1916	7	12

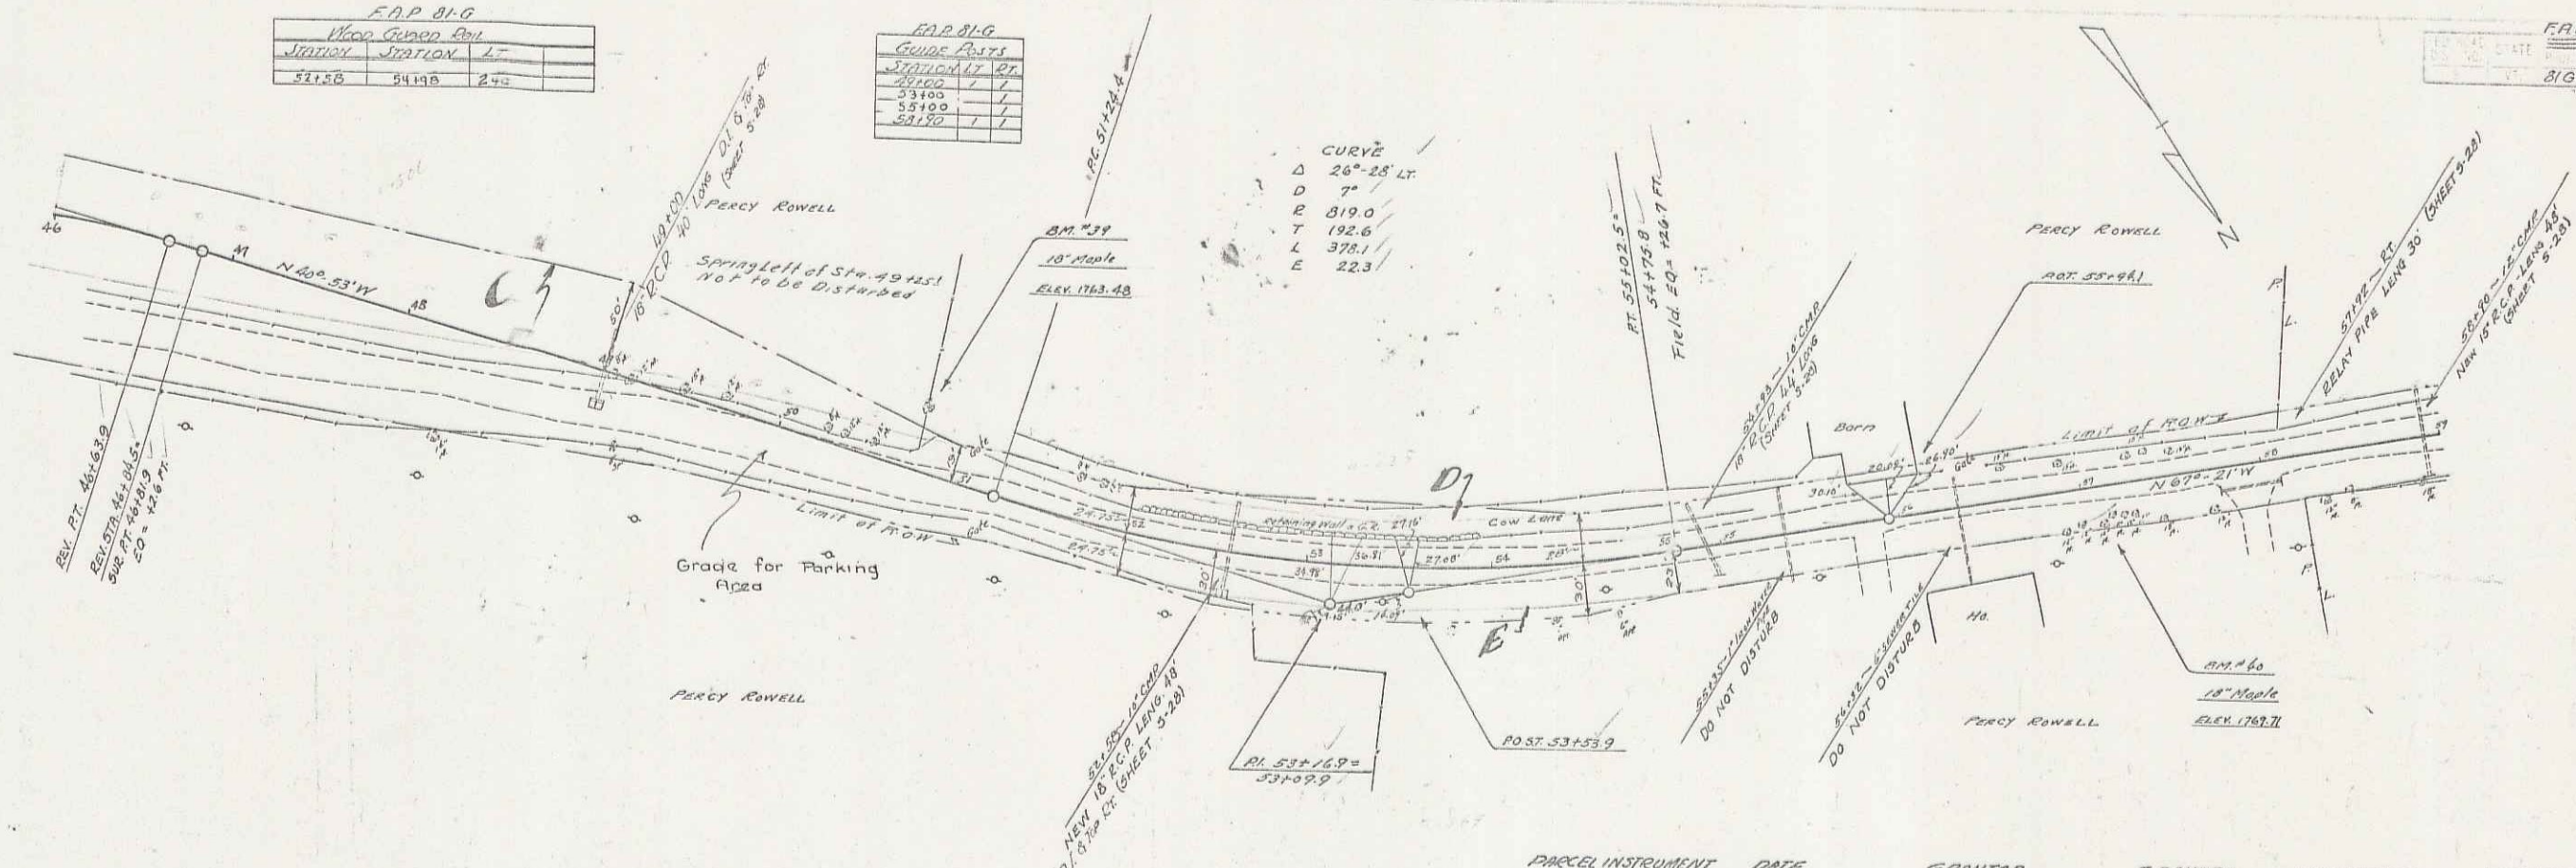

PARCEL	INSTRUMENT	DATE	GRANTOR	GRANTEE	RECORDED	REMARKS
ABCDE	N.O.	12-27-34	PERCY R. G. ROWELL	J.P. O'NEILL	22 5878-9	12-27-34

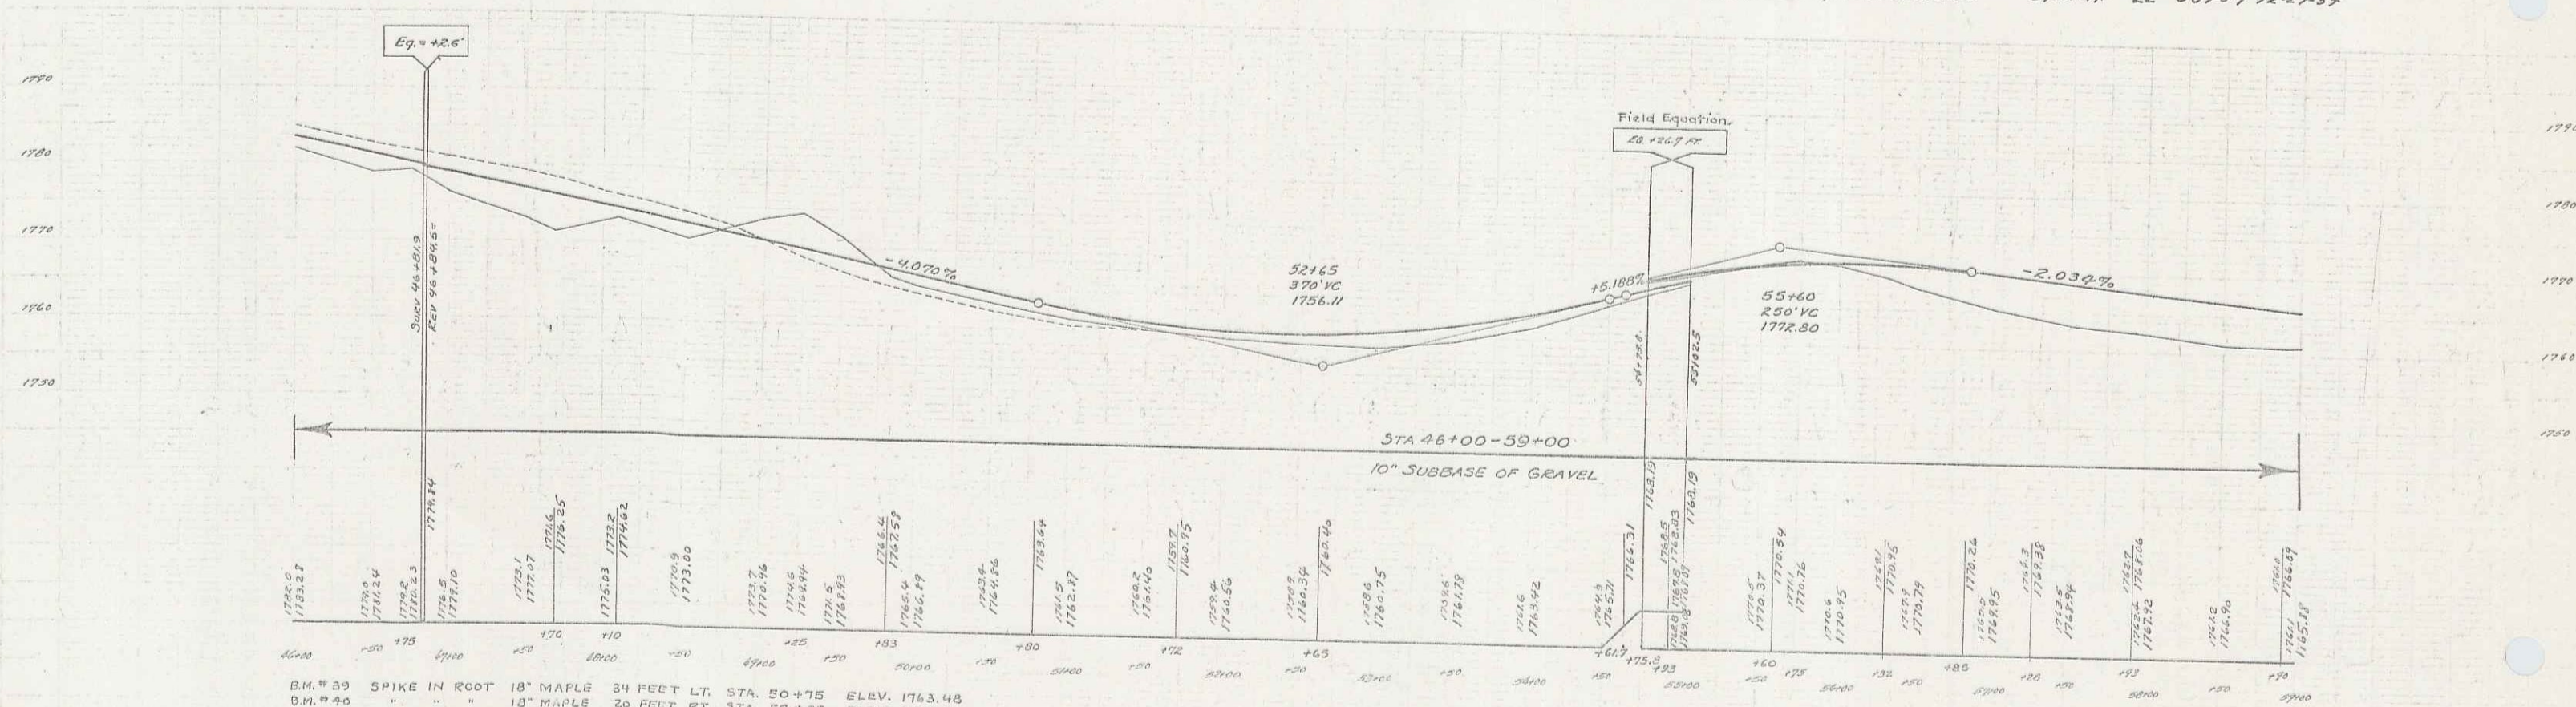

B.M. #39 SPIKE IN ROOT 18" MAPLE 34 FEET LT. STA. 50+47.5 ELEV. 1743.48
 B.M. #40 " " " 18" MAPLE 20 FEET RT. STA. 57+09 ELEV. 1749.71

SERIES F.A.P. NO. 81-G
 SHEET 7 OF 12