
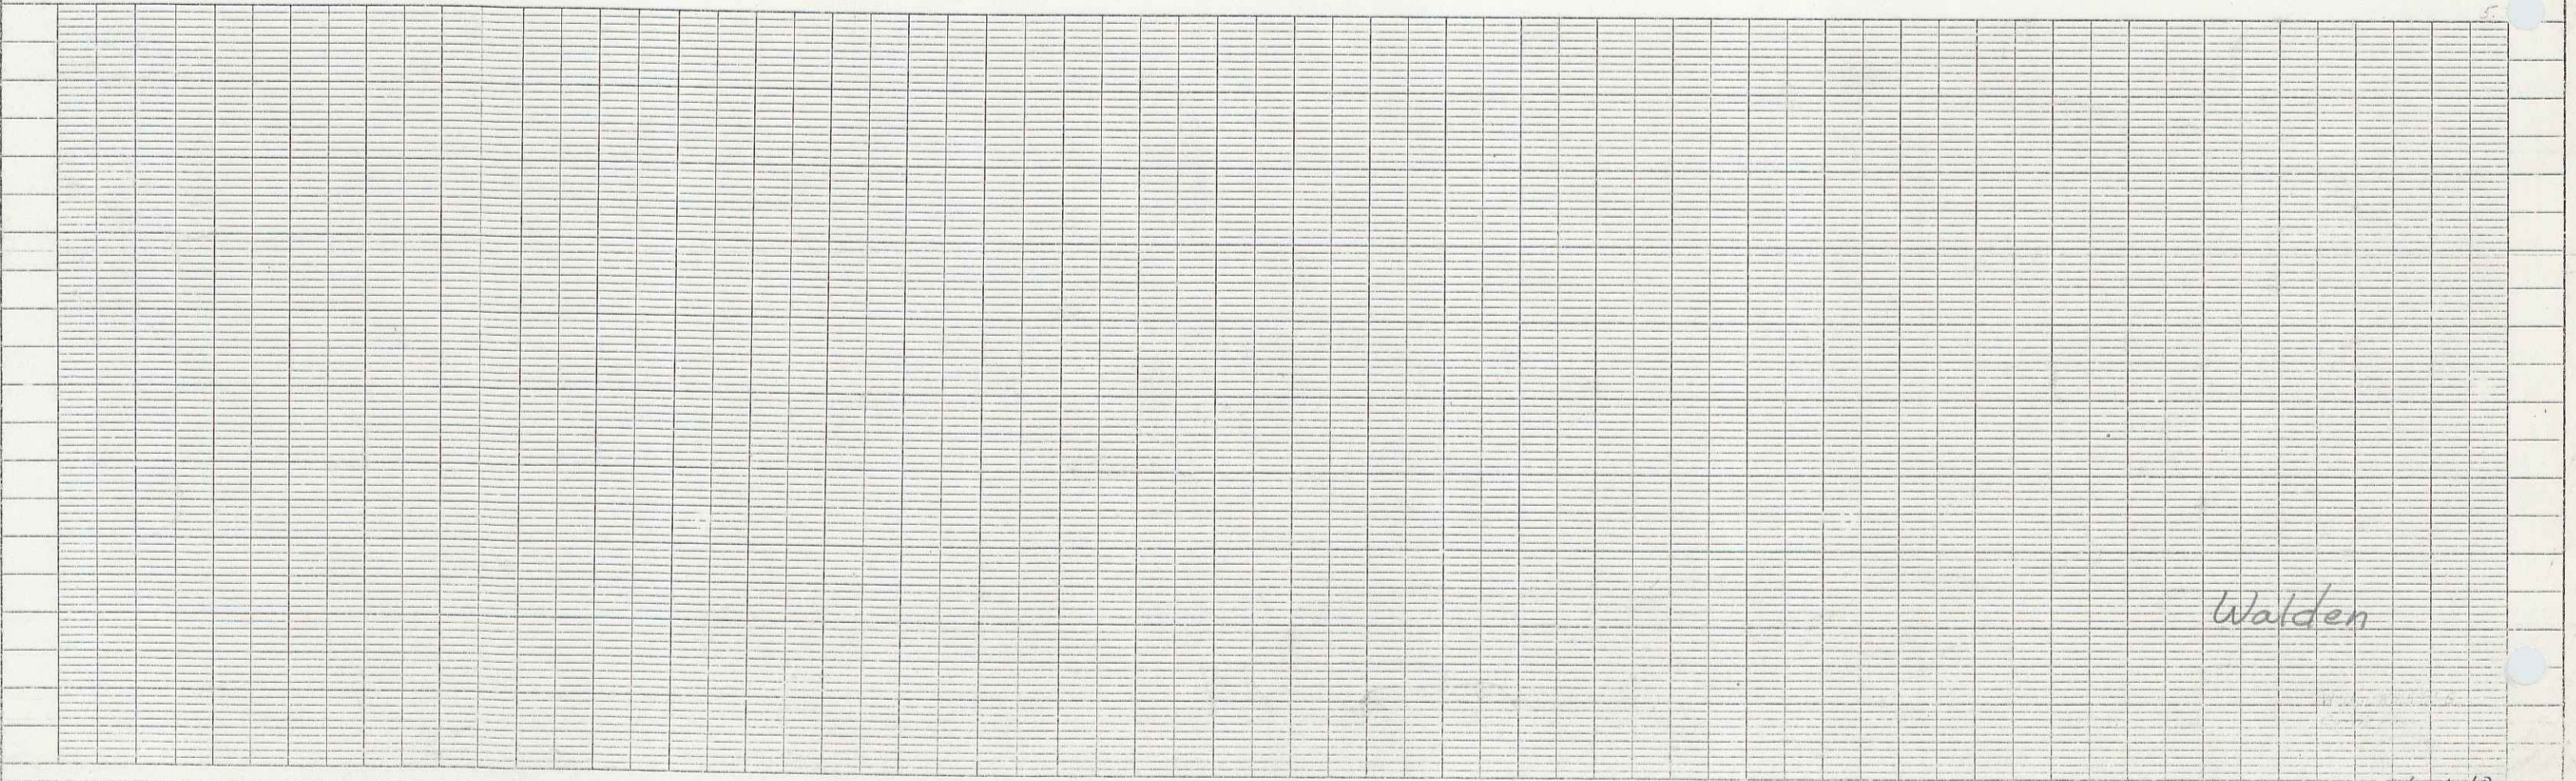


PLAN  
 SURVEYED BY  
 DATE  
 CHECKED BY  
 DATE  
 REVISIONS

PROFILE  
 SURVEYED BY  
 DATE  
 CHECKED BY  
 DATE  
 REVISIONS

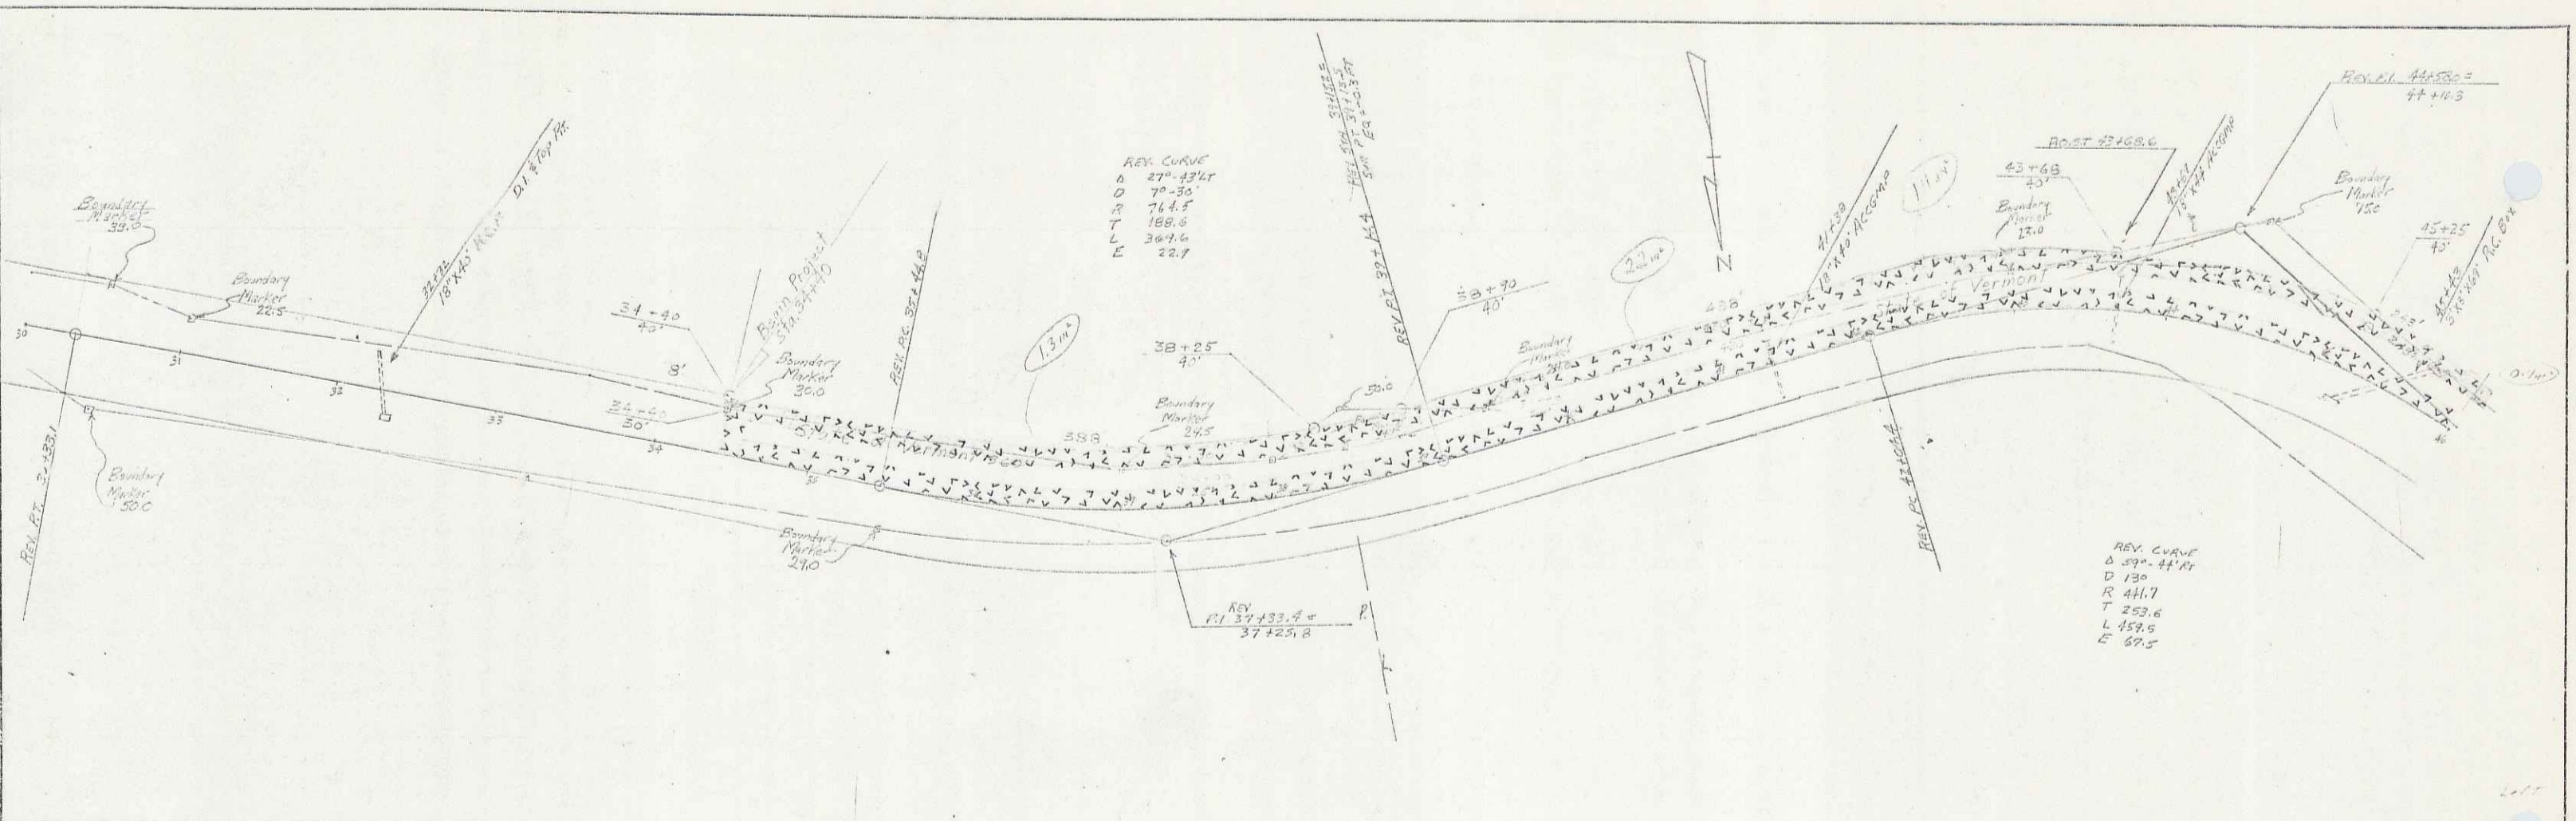

Walden

10  
 1415