



Parcel	Kind of Instrument	Date of Instrument	Grantor	Grantee	Recorded Date	Remarks
A.B.	30.D	9-27-33	W.A. Smith	Steffl.	33 673-674	12-1-33
A.		11-6-33	Wallace Griggs		33 670-671	12-1-33

FED. ROAD STATE HIGHWAY FISCAL SHEET SERIAL NO. PROJECT YEAR DIST. 5 VT NEWBOLD 1933 4 50

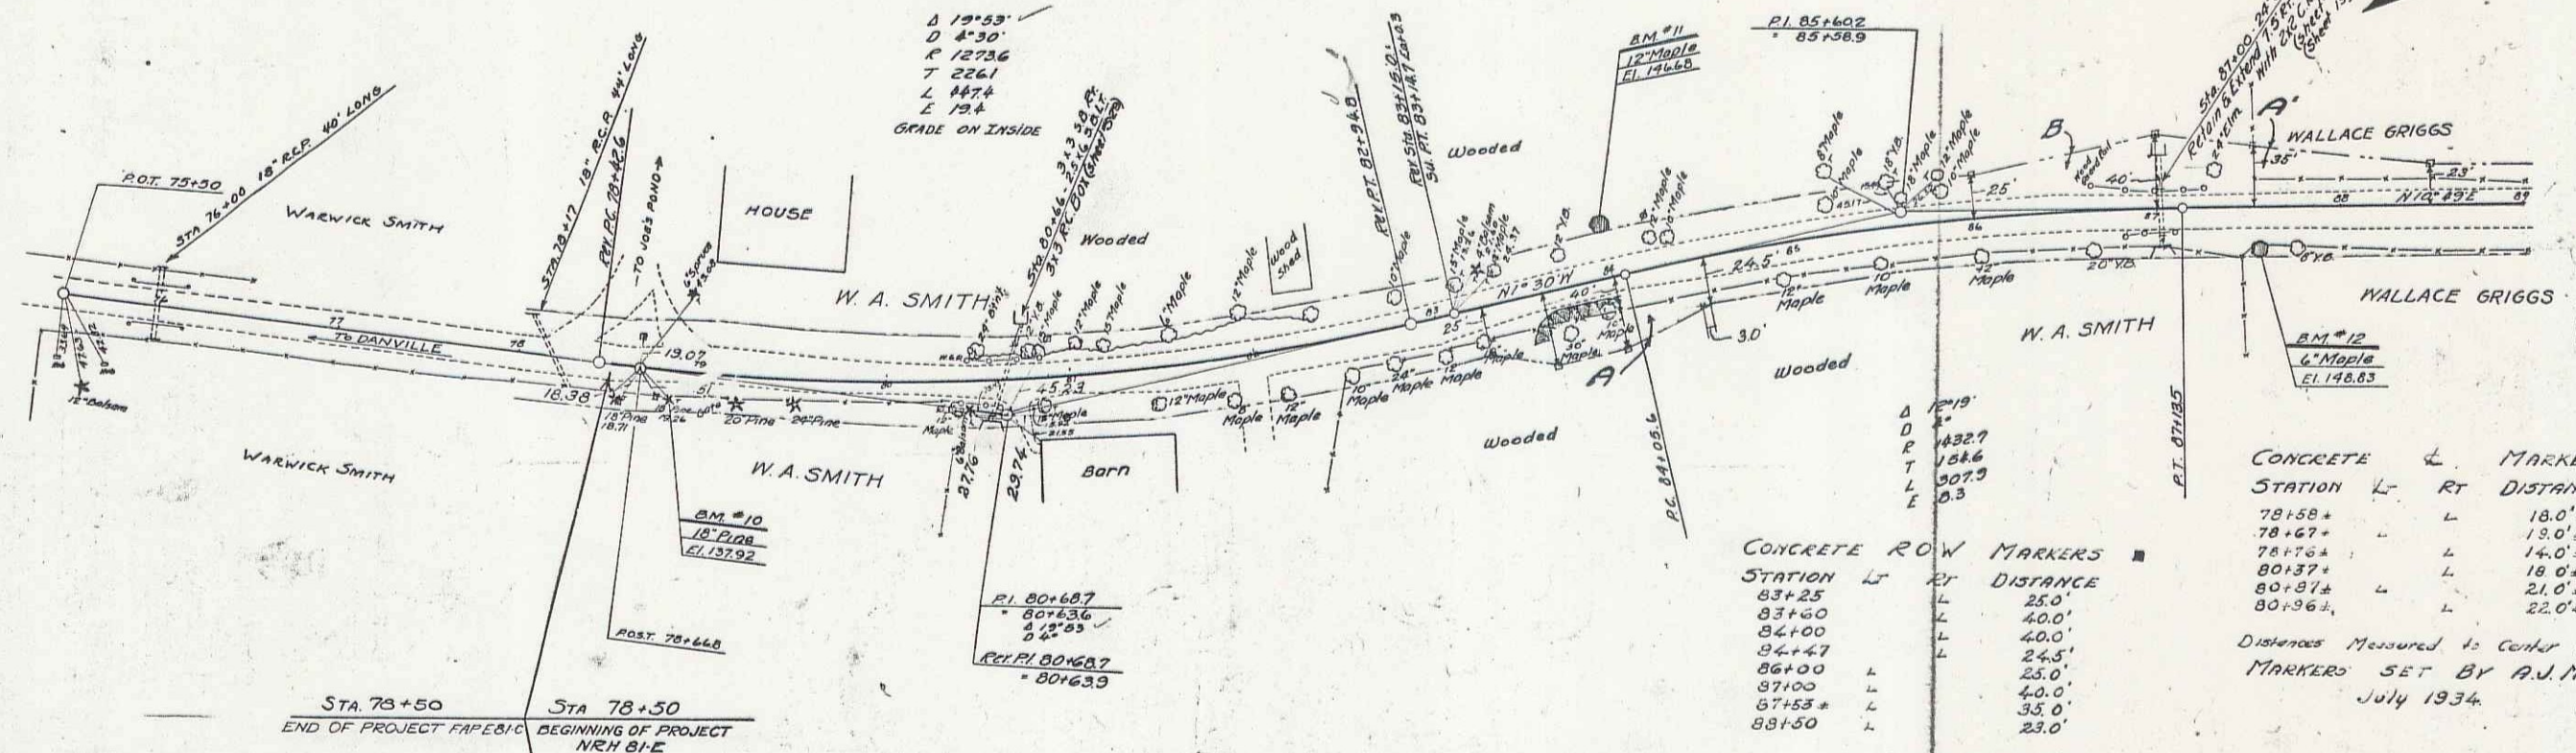

STATION	LT	RT	DISTANCE
78+50	L	L	18.0'
78+67	L	L	18.0'
78+76	L	L	14.0'
80+37	L	L	18.0'
80+87	L	L	21.0'
80+96	L	L	22.0'

DISTANCES MEASURED TO CENTER OF IRON PIN MARKERS SET BY A.J.M. July 1934.

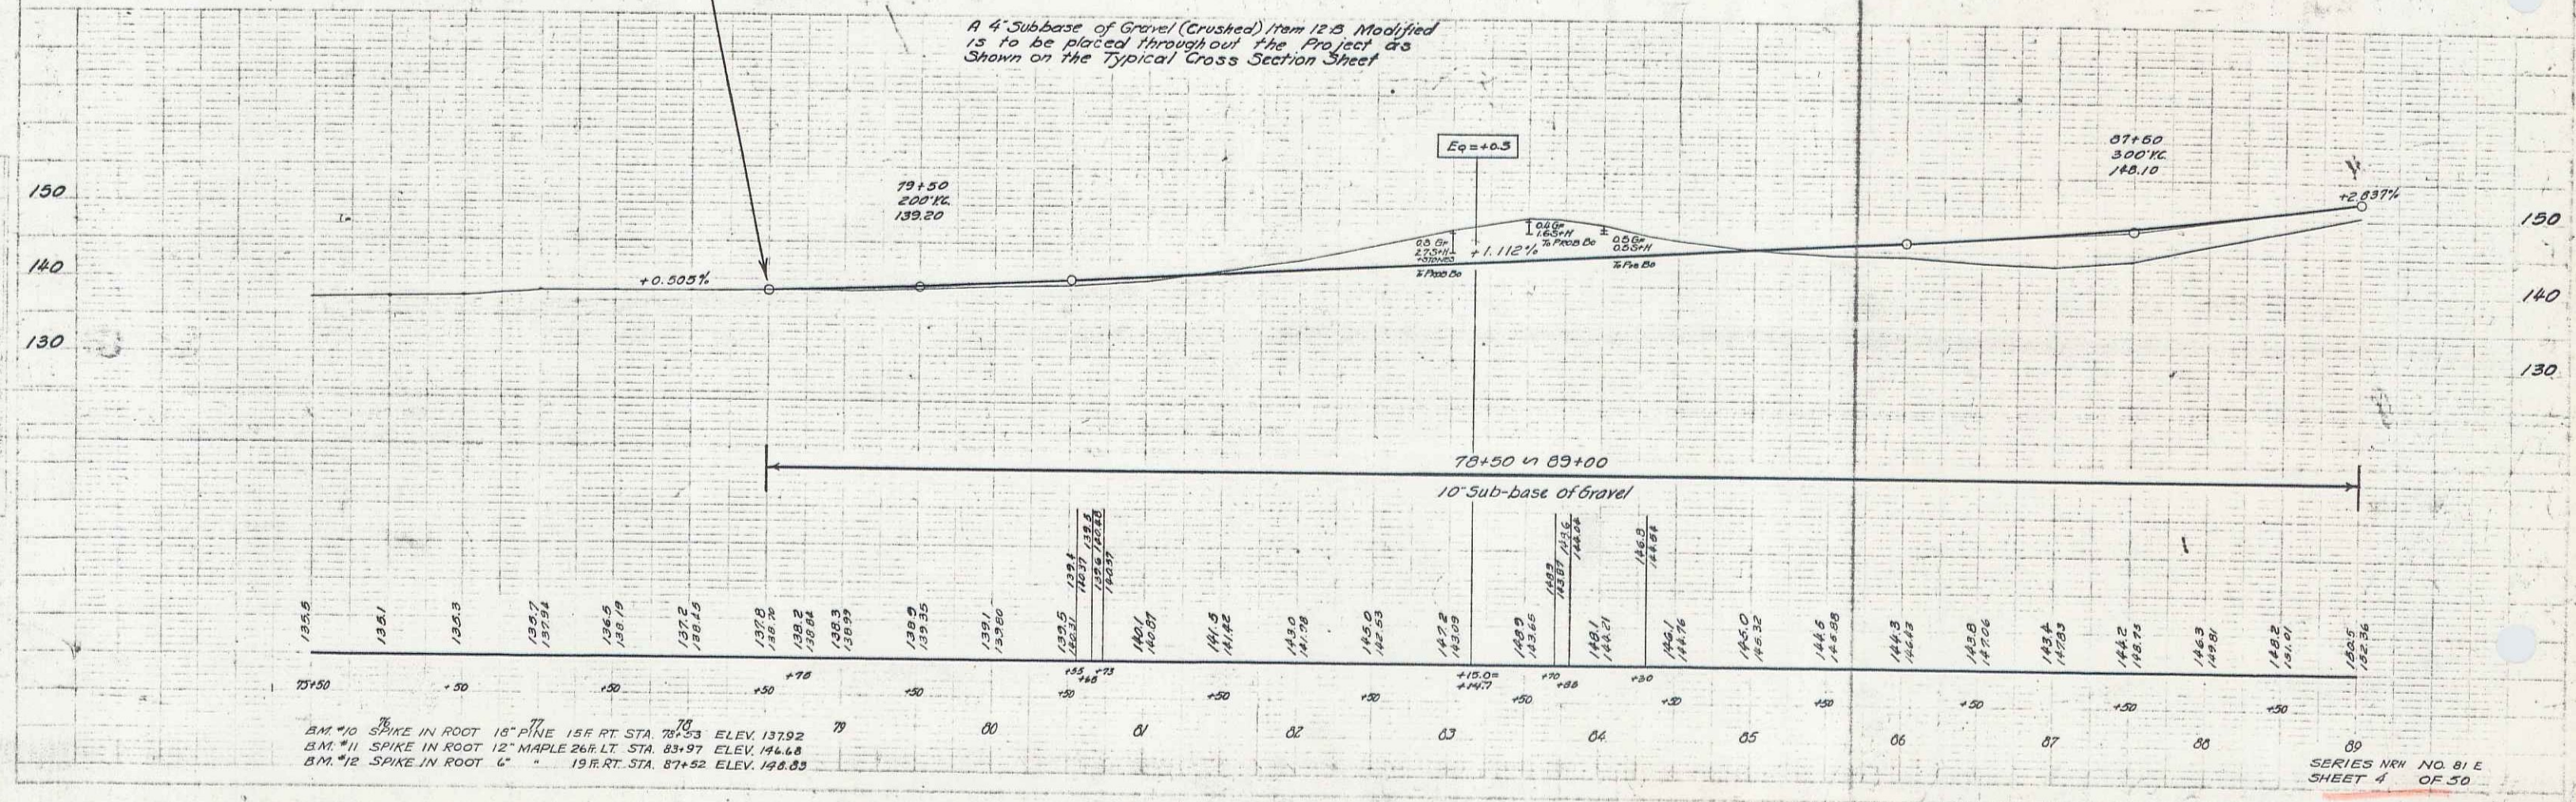

B.M. #10 SPIKE IN ROOT 18" PINE 156 FT. STA 75+53 ELEV. 137.92
 B.M. #11 SPIKE IN ROOT 12" MAPLE 266 FT. STA 83+97 ELEV. 144.48
 B.M. #12 SPIKE IN ROOT 6" 19 FT. STA 87+52 ELEV. 148.83