



Parcel	Kind of Instrument	Date of Instrument	Grantor	Grantee	Recorded Value	Back Page	Date	Remarks
B	Q.C.D.	11-6-33	Wallace Griggs	St of W	22 449	12-1-33		
A'B'C'D	Q.C.D.	9-14-33	Elson Douse	St of W	22 445	9-28-33		

NO.	DATE	BY	REVISION
1	1933	R.J.M.	Original

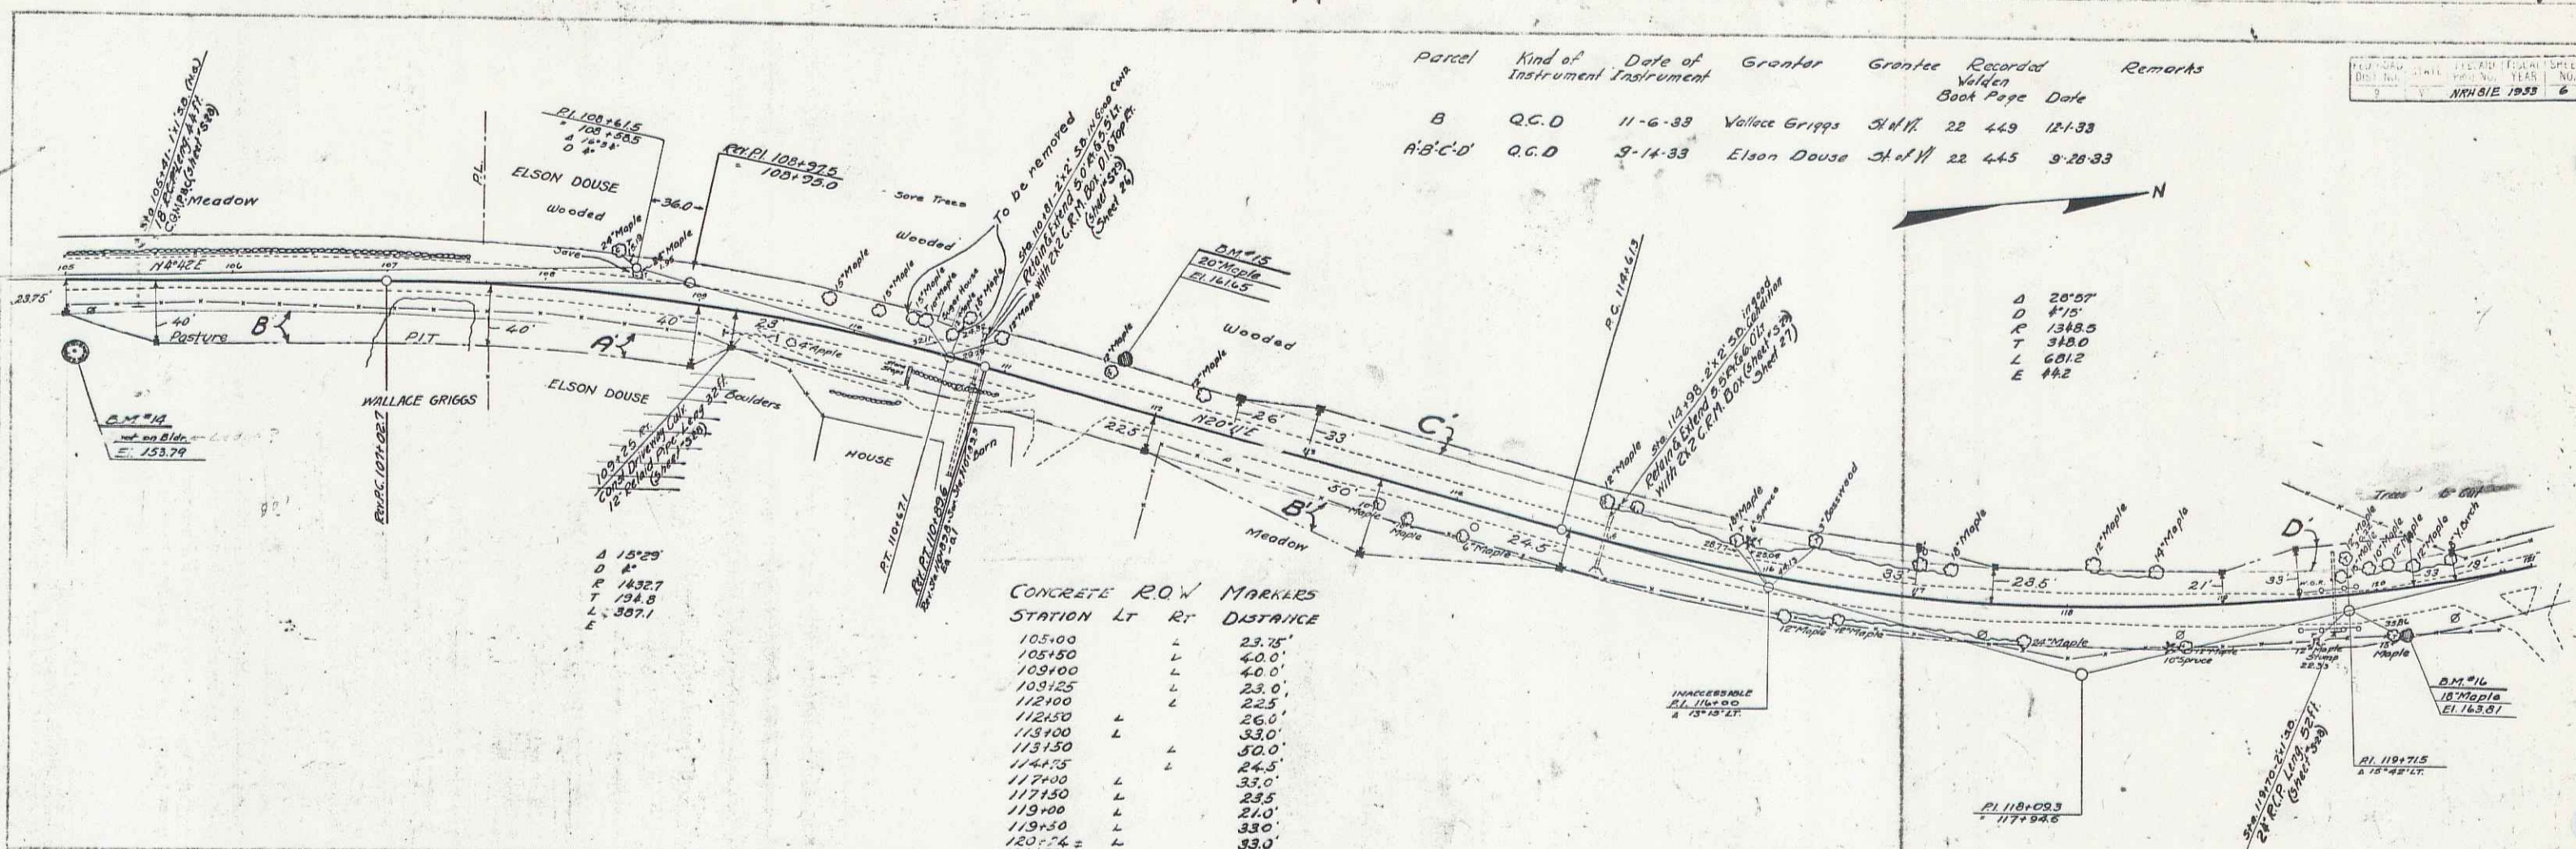

CONCRETE R.O.W MARKERS

STATION	Lt	Rt	DISTANCE
105+00	L		23.75'
105+50	L		40.0'
105+100	L		40.0'
105+125	L		23.0'
112+00	L		22.5'
112+50	L		26.0'
113+00	L		33.0'
113+150	L		30.0'
114+15	L		24.5'
117+00	L		33.0'
117+150	L		23.5'
119+00	L		24.0'
119+150	L		33.0'
120+74	L		33.0'
120+150	L		19.0'

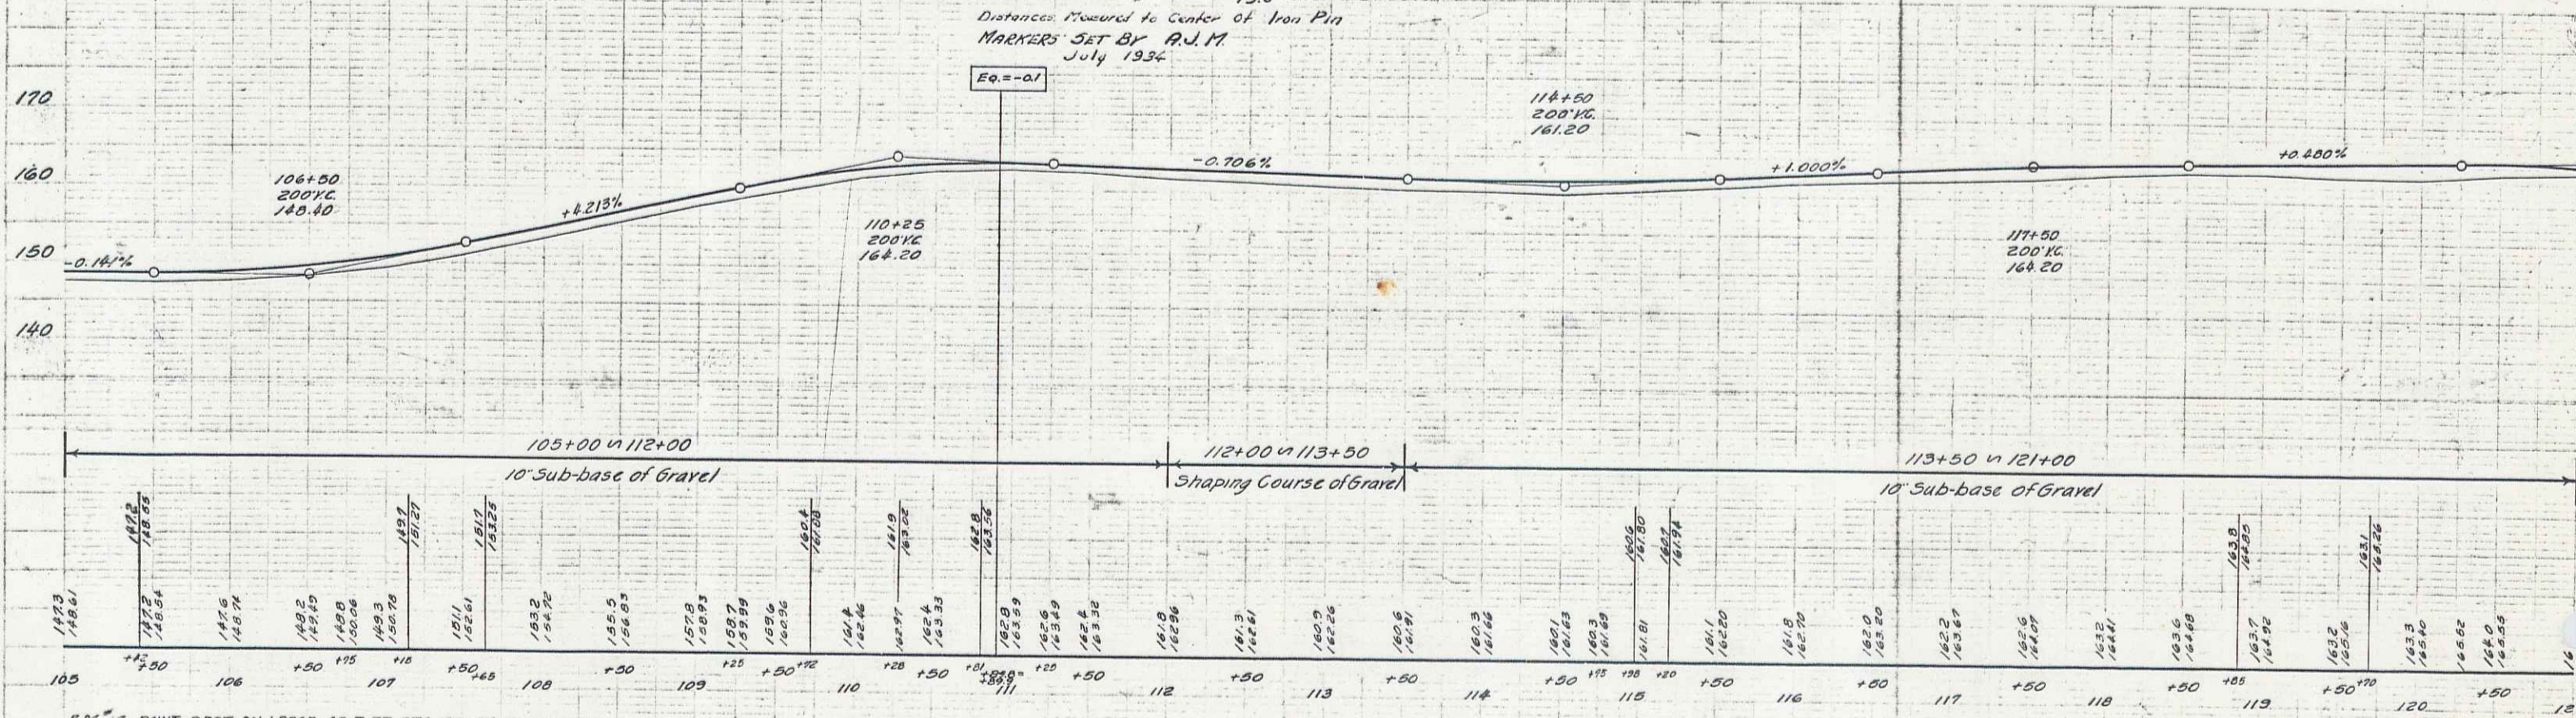

B.M. #4 PAINT SPOT ON LEDGE 42 FT. RT. STA. 105+04 ELEV. 153.79
 B.M. #15 SPIKE IN TRUNK 20" MAPLE 25 FT. LT. STA. 111+70 ELEV. 161.65
 B.M. #16 SPIKE IN ROOT 18" MAPLE 27 FT. RT. STA. 120+19 ELEV. 143.81