



Parcel Kind of Date of Grantor Grants Recorded Remarks
 Instrument Instrument No. Book Page Date
 A.L.C.H. Q.C.D. 9-10-33 Earl McGoff 51 of 11. 22 44 9-28-33 C.W. 34 122160

FED. ROAD DIST. NO. STATE PROJ. NO. FISCAL YEAR SHEET NO. TOTAL SHEETS
 V. 1. NOV 21E 1933 7 50

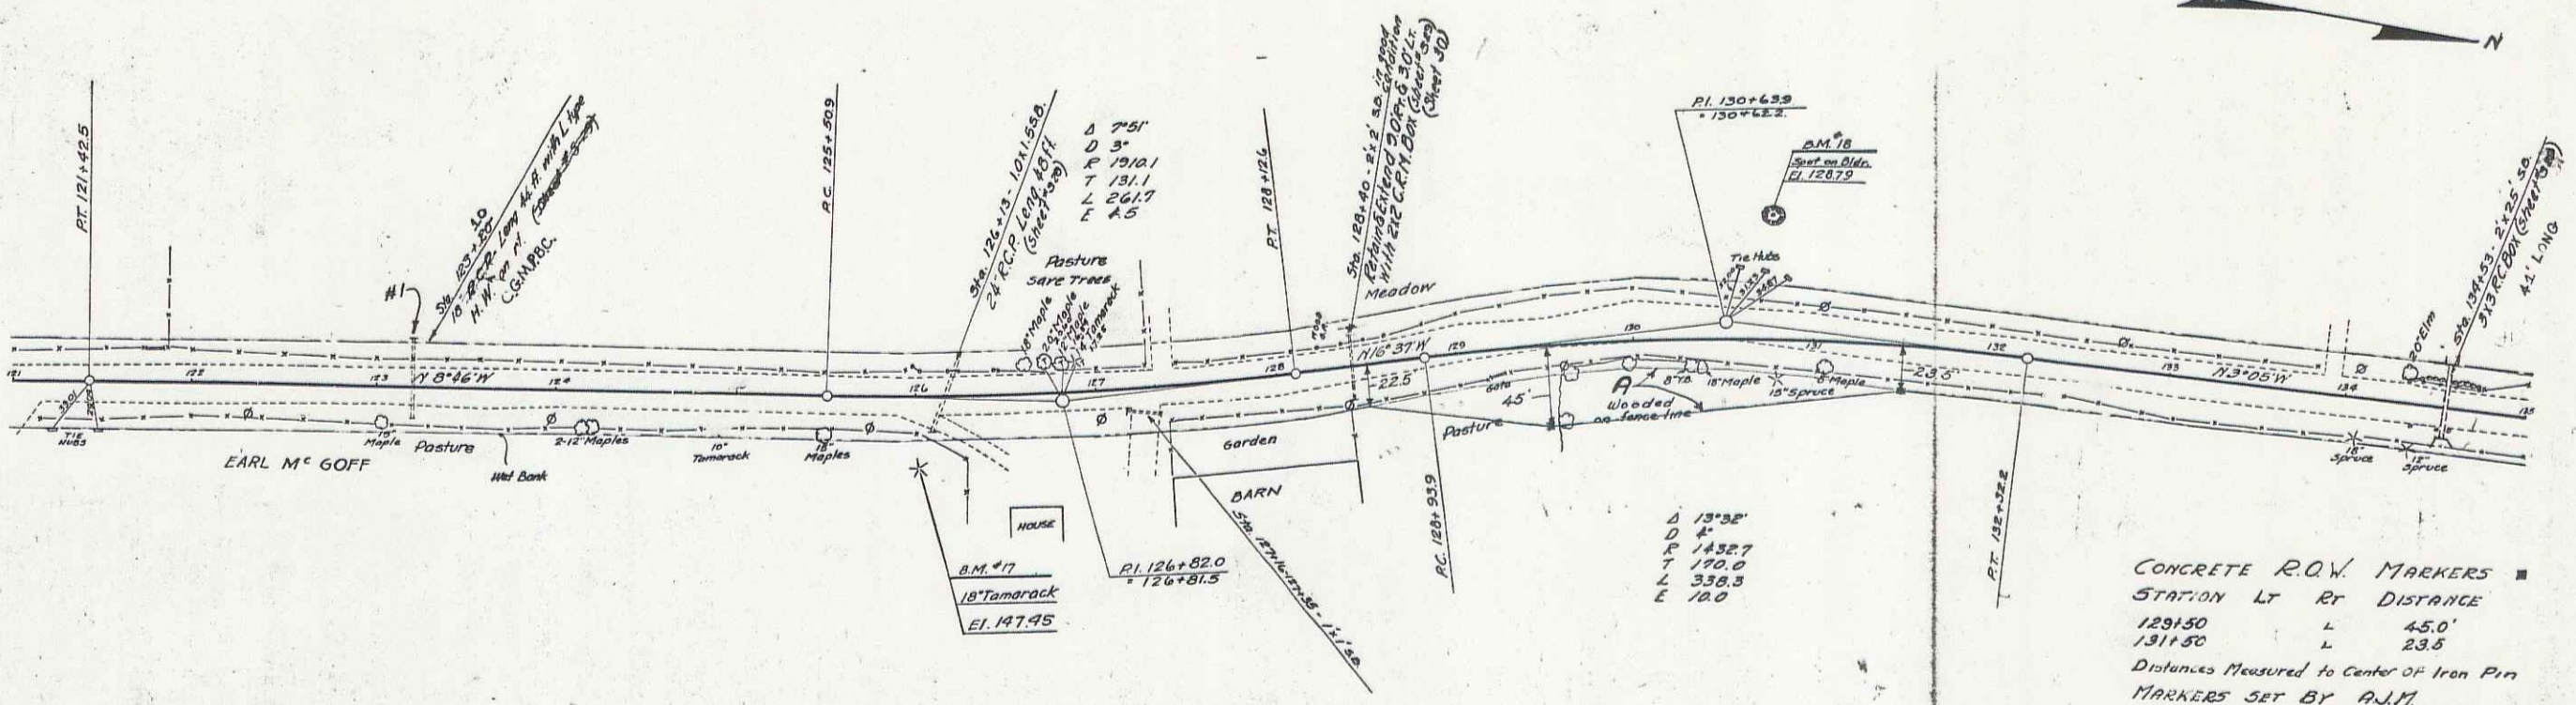

CONCRETE R.O.W. MARKERS
 STATION Lt Rt DISTANCE
 129+50 L 45.0
 131+50 L 23.5
 Distances Measured to Center of Iron Pin
 MARKERS SET BY A.J.M.
 July 1934

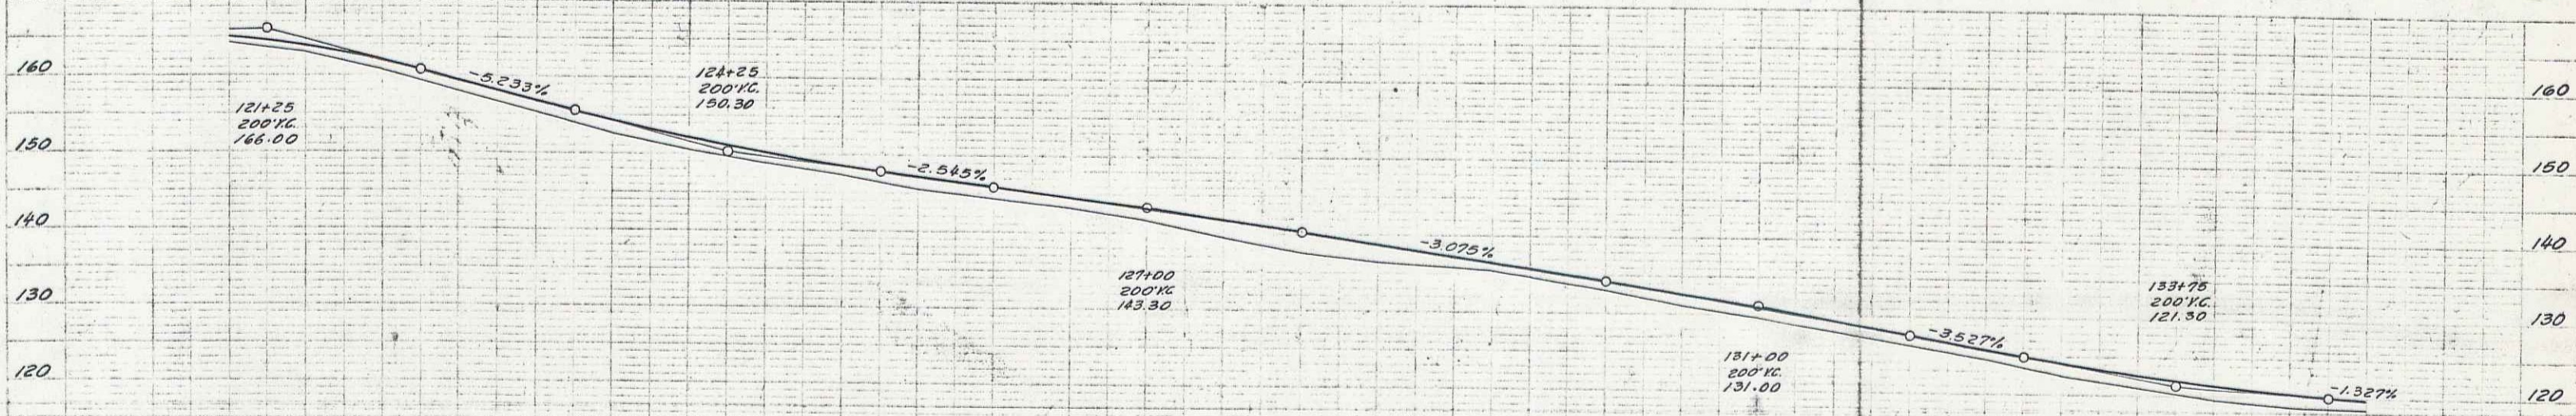

10' Sub-base of Gravel

Station	Elevation
121+00	165.58
121+10	164.57
121+20	163.57
121+30	162.58
121+40	161.59
121+50	160.60
121+60	159.61
121+70	158.62
121+80	157.63
121+90	156.64
122+00	155.65
122+10	154.66
122+20	153.67
122+30	152.68
122+40	151.69
122+50	150.70
122+60	149.71
122+70	148.72
122+80	147.73
122+90	146.74
123+00	145.75
123+10	144.76
123+20	143.77
123+30	142.78
123+40	141.79
123+50	140.80
123+60	139.81
123+70	138.82
123+80	137.83
123+90	136.84
124+00	135.85
124+10	134.86
124+20	133.87
124+30	132.88
124+40	131.89
124+50	130.90
124+60	129.91
124+70	128.92
124+80	127.93
124+90	126.94
125+00	125.95
125+10	124.96
125+20	123.97
125+30	122.98
125+40	121.99
125+50	121.00
125+60	120.01
125+70	119.02
125+80	118.03
125+90	117.04
126+00	116.05
126+10	115.06
126+20	114.07
126+30	113.08
126+40	112.09
126+50	111.10
126+60	110.11
126+70	109.12
126+80	108.13
126+90	107.14
127+00	106.15
127+10	105.16
127+20	104.17
127+30	103.18
127+40	102.19
127+50	101.20
127+60	100.21
127+70	99.22
127+80	98.23
127+90	97.24
128+00	96.25
128+10	95.26
128+20	94.27
128+30	93.28
128+40	92.29
128+50	91.30
128+60	90.31
128+70	89.32
128+80	88.33
128+90	87.34
129+00	86.35
129+10	85.36
129+20	84.37
129+30	83.38
129+40	82.39
129+50	81.40
129+60	80.41
129+70	79.42
129+80	78.43
129+90	77.44
130+00	76.45
130+10	75.46
130+20	74.47
130+30	73.48
130+40	72.49
130+50	71.50
130+60	70.51
130+70	69.52
130+80	68.53
130+90	67.54
131+00	66.55
131+10	65.56
131+20	64.57
131+30	63.58
131+40	62.59
131+50	61.60
131+60	60.61
131+70	59.62
131+80	58.63
131+90	57.64
132+00	56.65
132+10	55.66
132+20	54.67
132+30	53.68
132+40	52.69
132+50	51.70
132+60	50.71
132+70	49.72
132+80	48.73
132+90	47.74
133+00	46.75
133+10	45.76
133+20	44.77
133+30	43.78
133+40	42.79
133+50	41.80
133+60	40.81
133+70	39.82
133+80	38.83
133+90	37.84
134+00	36.85
134+10	35.86
134+20	34.87
134+30	33.88
134+40	32.89
134+50	31.90
134+60	30.91
134+70	29.92
134+80	28.93
134+90	27.94
135+00	26.95

B.M. #7 SPIKE IN ROOT 13' TAMARACK 3/4 RT. STA. 126+01 ELEV. 147.45
 B.M. #8 SPOT ON BOULDER 6.5' LT. STA. 130+76 ELEV. 128.79

SERIES NRH NO. 81E
 SHEET 7 OF 50

5