


Parcel	Kind of Instrument	Date of Instrument	Grantor	Grantee	Recorded Volume	Book	Page	Date	Remarks
A, B	O.C.D.	9-14-33	Philip Silver	St. #11	22	446	9-28-33		
A'	"	9-15-33	Lelia E. Thurston	"	21	440	9-18-33		


LEWIS & CLARK
DIST. NO. STATE ROAD DIST. NO. YEAR NO. SHEETS
6 171 1933 10 30

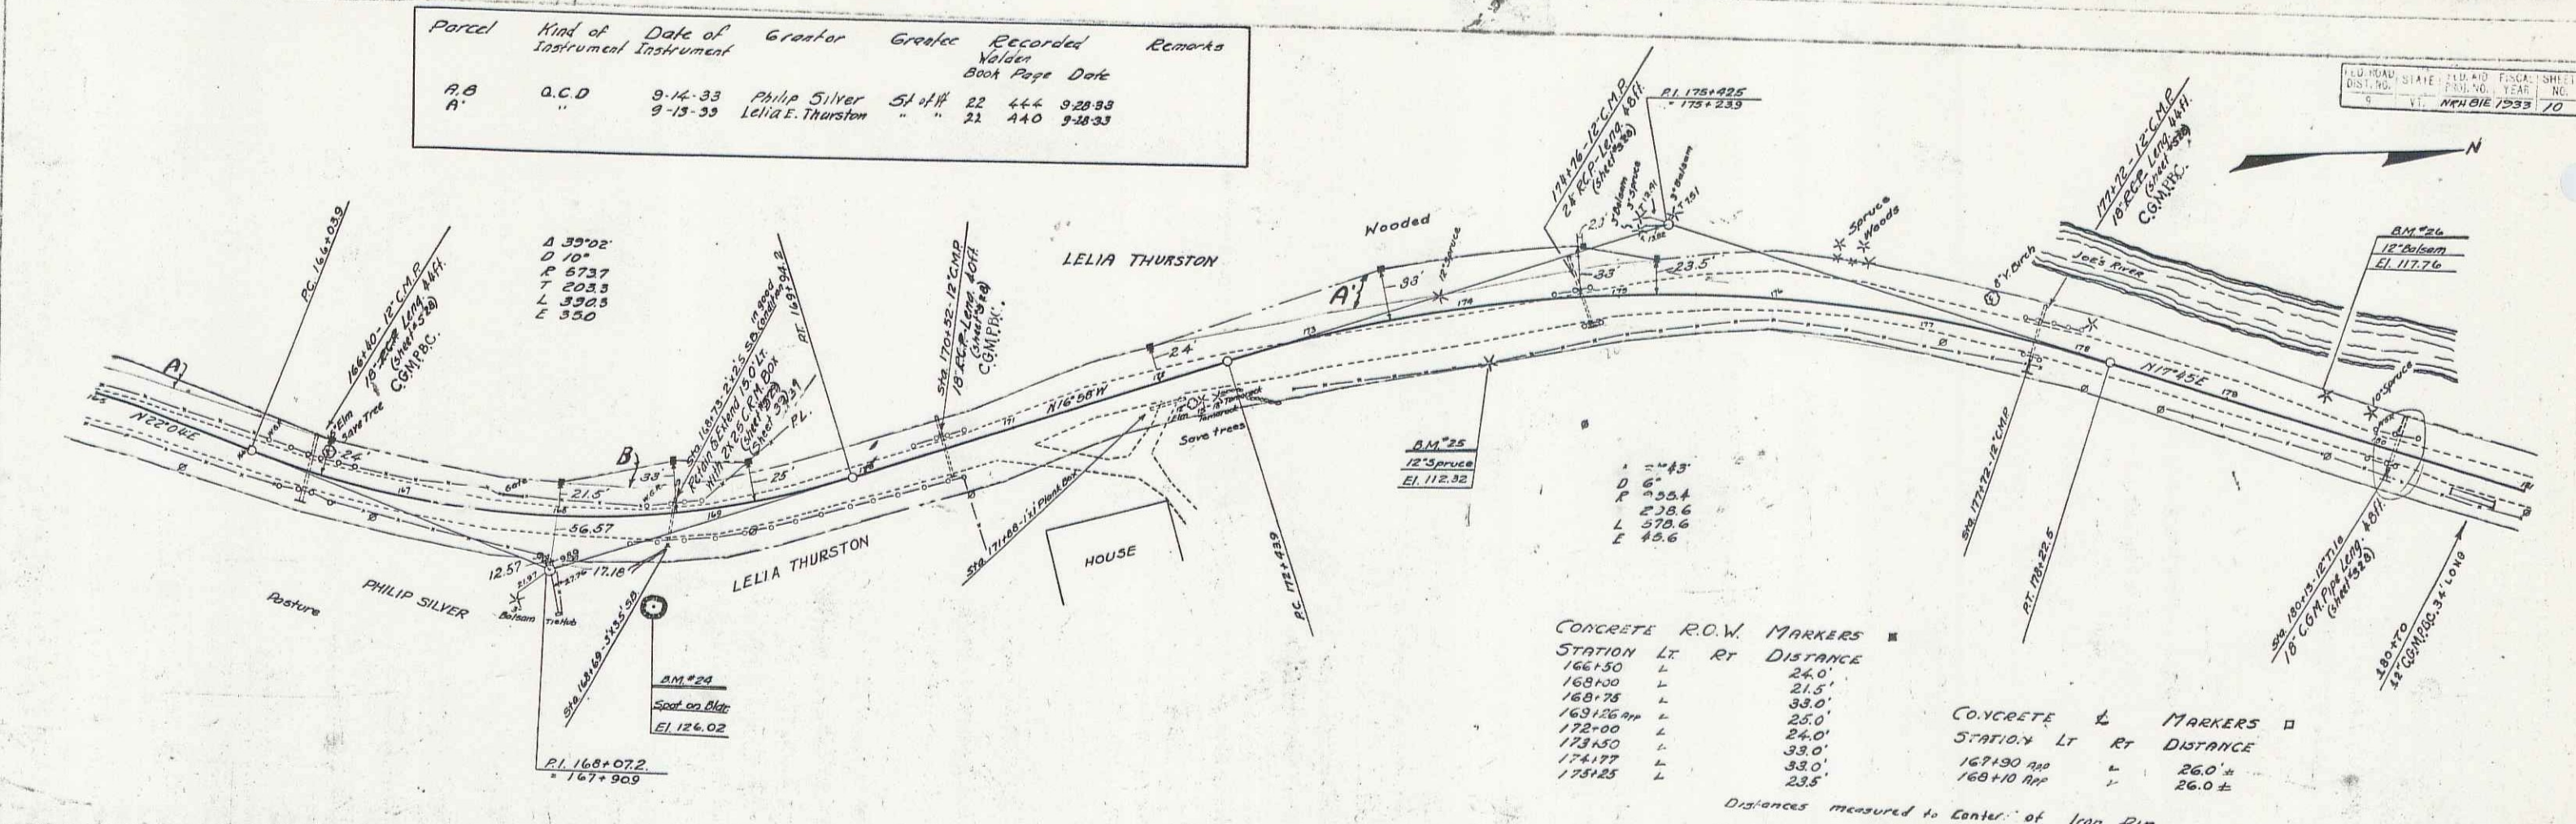

STATION	Lt	Rt	DISTANCE
165+50	L		24.0'
168+00	L		21.5'
168+75	L		33.0'
169+25	L		25.0'
172+00	L		24.0'
173+50	L		33.0'
174+77	L		33.0'
175+25	L		23.5'

STATION	Lt	Rt	DISTANCE
167+90	L		26.0' ±
168+10	Rt		26.0' ±

Distances measured to center of Iron Pin
MARKERS SET BY A.J.M. July 1934

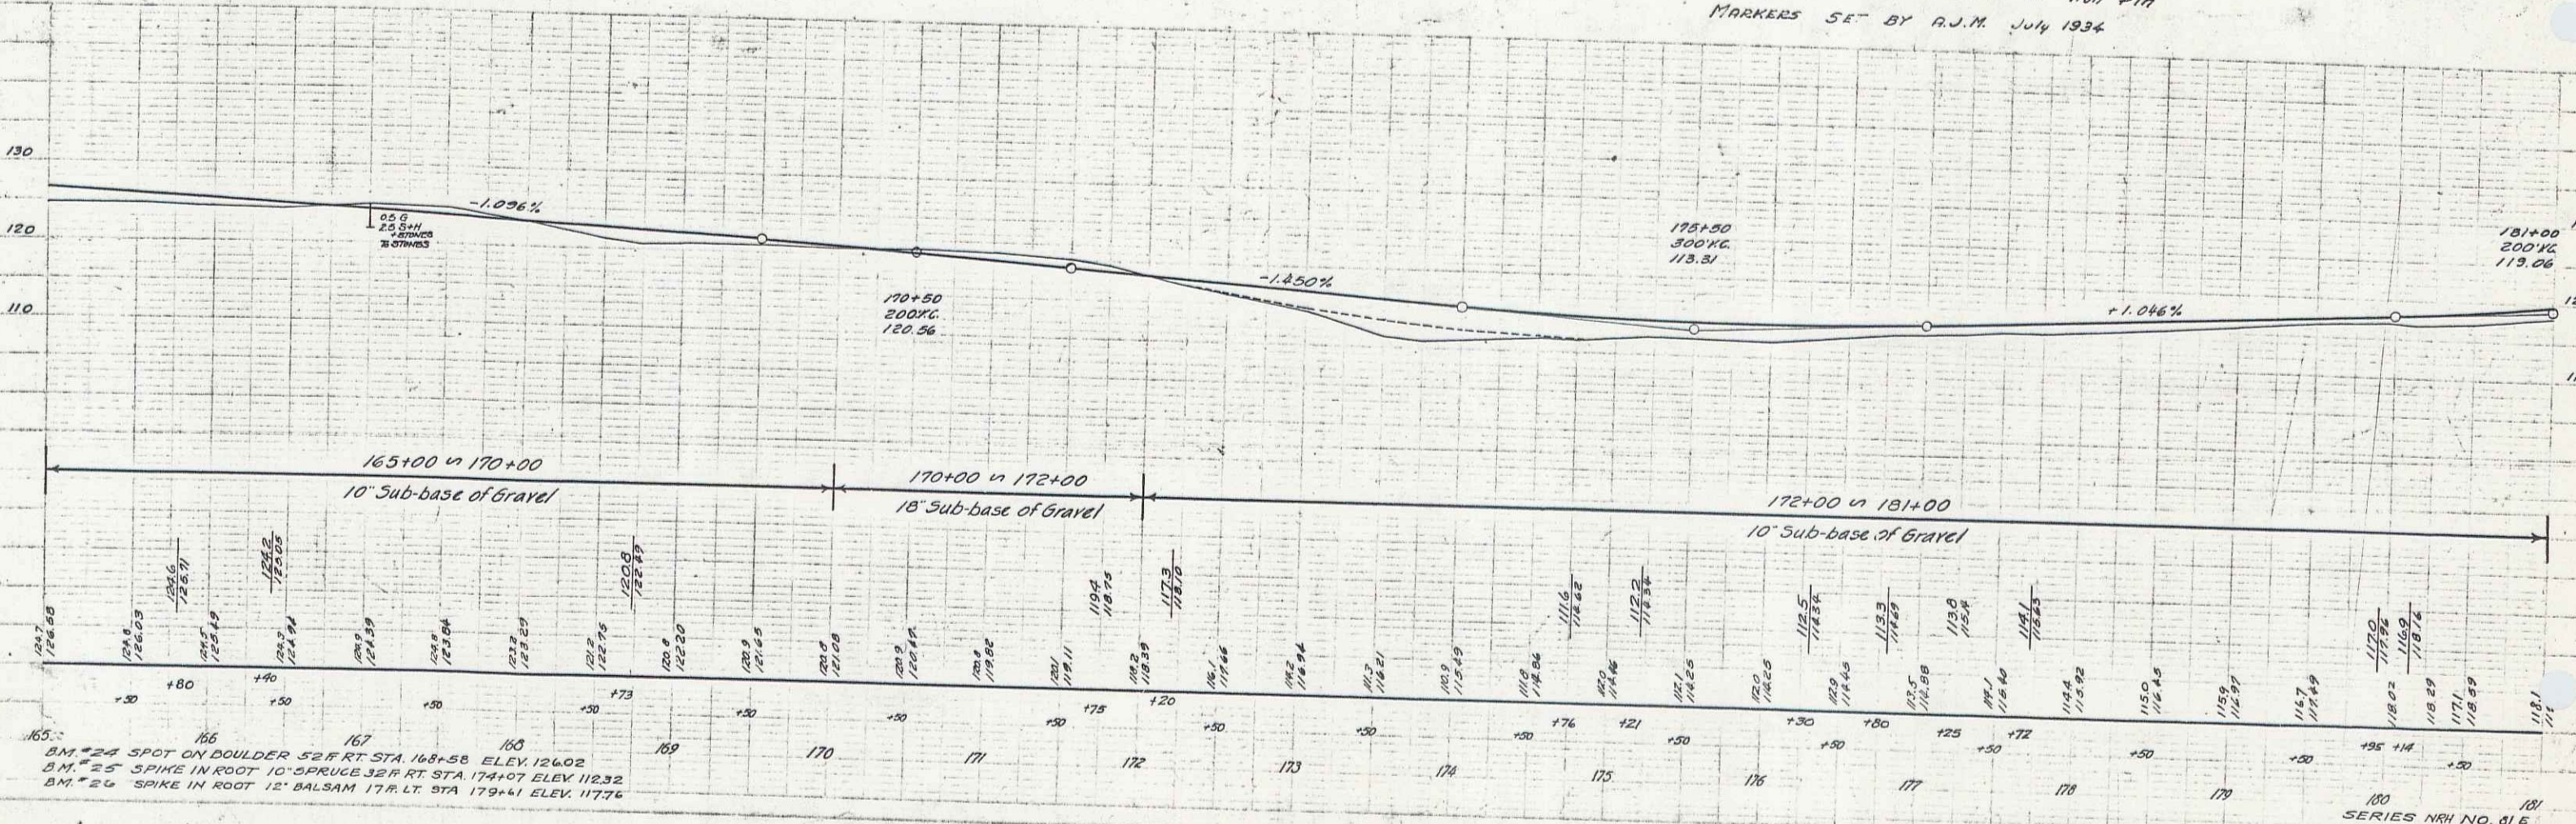

165+58
166
167
168
BM #24 SPOT ON BOULDER 52 FT RT STA 168+58 ELEV 126.02
BM #25 SPIKE IN ROOT 10-SPRUCE 32 FT RT STA 174+07 ELEV 112.32
BM #26 SPIKE IN ROOT 12-BALSAM 17 FT LT STA 179+41 ELEV 117.76